IREDELL COUNTY HEALTH DEPARTMENT

STATESVILLE 704-878-5305 MOORESVILLE 704-664-5281

IMPROVEMENT PERMIT / AUTHORIZATION TO CONSTRUCT / OPERATION PERMIT / EXISTING SYSTEM INSPECTION

PERMIT # 136493 PIN # 4639-31-8812 DATE 11-8-10

OWNER or APPLICANT Robert Rizzotto PHONE-Business 718-755-3131 Home:

OWNER or APPLICANT ADDRESS 6482 Key Islands Ct West Palm Beach FL 33411

LOCATION / DIRECTIONS 162 Blue Ridge Tr

SUBDIVISION Woodlake BLOCK / SECTION LOT # 21 LOT AREA 1.17 Ac DESIGN FLOW 480 GPD L.T.A.R. .25

Septic Tank 1000 Gallons: STB 160 Date 4-27-14

Pump Tank Gallons: P T Date

Pump Make Model Serial #

Nitrification Field No Fields 1 No Lines 4 Linear Feet 480'

Trench Width 36" Max. Trench Bottom Depth 36" Gravel Depth

☒ New System ☐ Repair ☐ Expansion System Type I II III IV V VI

System Description: Gravity 25% Red

Repair System Description: Panel Block

Maintenance Agreement Required ☐ YES ☒ NO Initially

☒ GRAVITY ☐ PRESSURE

☒ Residence No. Bedrooms 4

☐ Business No. Persons

☐ Other No. Employees

☐ Slab ☒ Crawl Space


☐ Basement w/plumbing ☐ Basement w/o plumbing

Water Supply: ☒ Private ☐ Public ☐ Community

Comments / Conditions

Comments / Conditions ① Meet All Required Setbacks ② Pool Can Be Larger But Must Be Min 15' From Septic Serial distribution into end Caps used Quick 4.


INITIAL SITE SKETCH

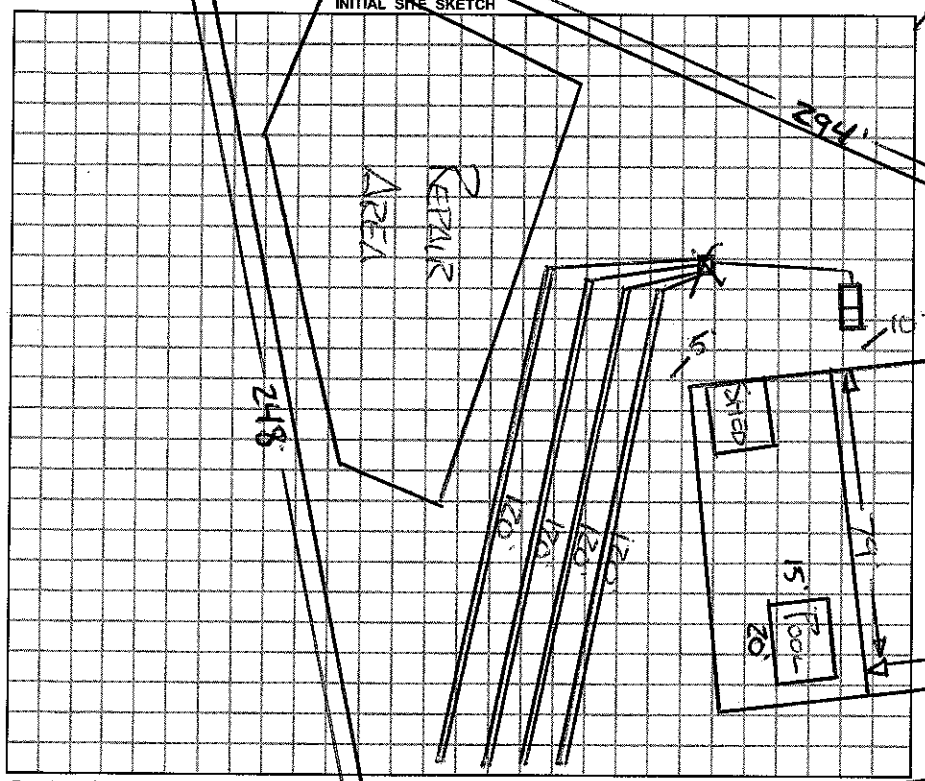

AS BUILT SKETCH

~1"=50'

Installed essentially as Drawn.

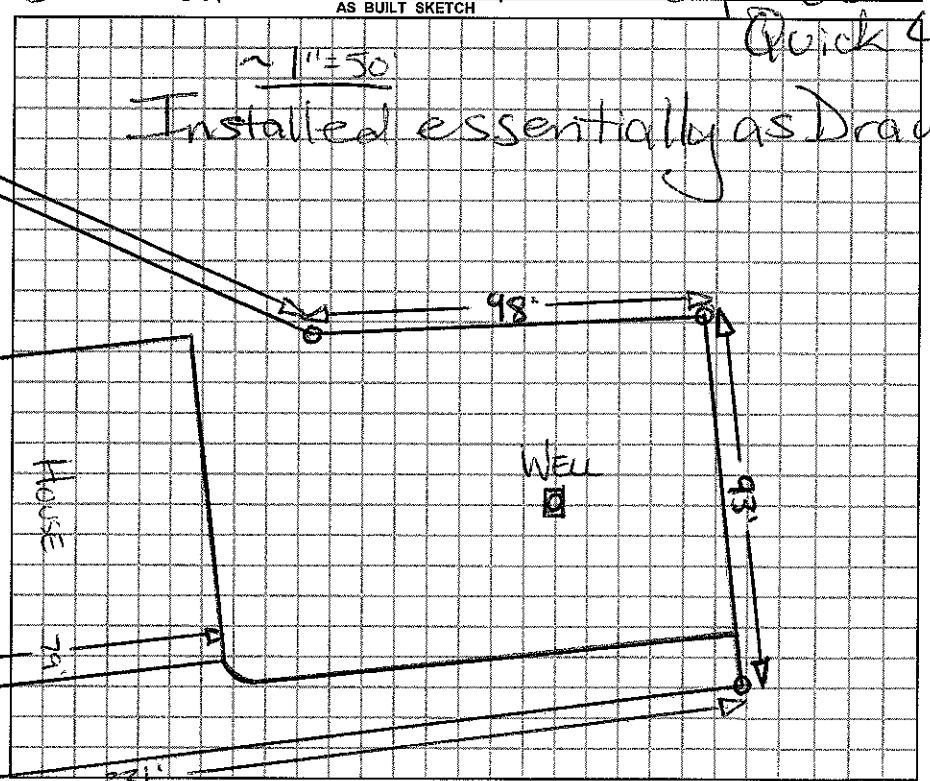

Permit can be suspended or revoked if any false information is supplied toward securing the permit / any unauthorized changes are made to the site / any unauthorized changes are made in the installation of the system.

☐ *IMPROVEMENT PERMIT w / plat valid without expiration.* ☒ *IMPROVEMENT PERMIT w / site plan valid for 60 mos.* ☒ *AUTHORIZATION TO CONSTRUCT valid for period equal to IMPROVEMENT PERMIT-not to exceed 60 mo.*

Owner / Applicant Signature: Date 12-29-10

Improvement Permit by: REHS Date 11-8-10

Authorization to Construct by: Date 11-26-13

Installed by: Gary Leatherman

Operation Permit by: Date: 7/16/14

Existing System Inspected by: Date:

YOU SHOULD CONTACT A) LOCATOR SERVICE PRIOR TO ANY EXCAVATION.

WHITE COPY Environmental Health YELLOW COPY (Final) Owner / Applicant PINK COPY (Initial) Owner / Applicant