375 3=3

IREDELL COUNTY HEALTH DEPARTMENT

STATESVILLE 704-878-5305 MOORESVILLE 704-664-5281

IMPROVEMENT PERMIT / AUTHORIZATION TO CONSTRUCT / OPERATION PERMIT / EXISTING SYSTEM INSPECTION

PERMIT# 135557 PIN# 4639 20 9711.056 4639 318422 DATE June 9, 2006

OWNER OR APPLICANT Woodbridge Partners / Dream Works PHONE: Business _____ Home _____

ADDRESS P.O. Box 3608 / Mooresville / N.C 28117

LOCATION Perth Rd (N) TL Fern Hill TL Kenway Loop on Right

SUBDIVISION Woodleaf BLOCK / SECTION _____ LOT 56 LOT AREA .74Ac SITE CLASS. PS DESIGN FLOW 440gpd L.T.A.R. .3

Septic Tank: 1000 Gallons: STB 1012 Date 9/19/06

Pump Tank: 1000 Gallons: PT 17 Date 11/15/06

Pump Make: Gould's Model WEO-512 Model No. B0151359

Nitrification Field: No Fields 1 Square Feet 1200 Linear Feet 400

No Lines 5@80' Trench Width 36" Max Trench Bottom Depth 36"

☒ New System ☐ Repair ☐ Expansion System Type: I II (III) IV V VI

System Description: pm 25% Reduction

Repair System Description: LPPPBS

Maintenance Agreement Required: ☐ Yes ☒ No Initially

☒ House/Mod. Home No. Bedrooms 4

☐ Mobile Home No. Persons ____

☐ Business No. Employees ____

☐ Other _____

Water Supply: ☒ Individual ☐ Public ☐ Community

Gravel Depth NA ☐ Gravity ☒ Pressure ☐ Slab ☒ Crawl Space ☐ Basement w/plumbing ☐ Basement wo/plumbing

Comments:/Conditions:

"Shave off" old beam in septic drainfield area.
11/2/06 Reviewed Building plans Site Plan, in Compliance with Original permit

Comments:/Conditions: Inspection not Installed

INITIAL SITE SKETCH

SEE Plan from SCME

AS BUILT SKETCH


Permit can be suspended or revoked if any false information is supplied toward securing the permit/any unauthorized changes are made to the site/any unauthorized changes are made in the installation of the system. Improvement Permit with plat valid without expiration ☐ Improvement Permit with site plan valid for sixty months ☒ Authorization to Construct is valid for a period equal to that of Improvement Permit – not to exceed sixty months.

Signed: _____ date 6-20-06 Installed by: Piedmont Backflow Service

Improvement Permit by: _____ date 6-9-06 Operation Permit by: Wesley Sparks R.S. date 5/7/07

Authorization to Construct by: _____ date 11/2/06 Existing System Inspection by: _____ date _____

HEALTH DEPT. COPY: WHITE OWNER COPY (FINAL): YELLOW OWNER COPY (INITIAL): PINK

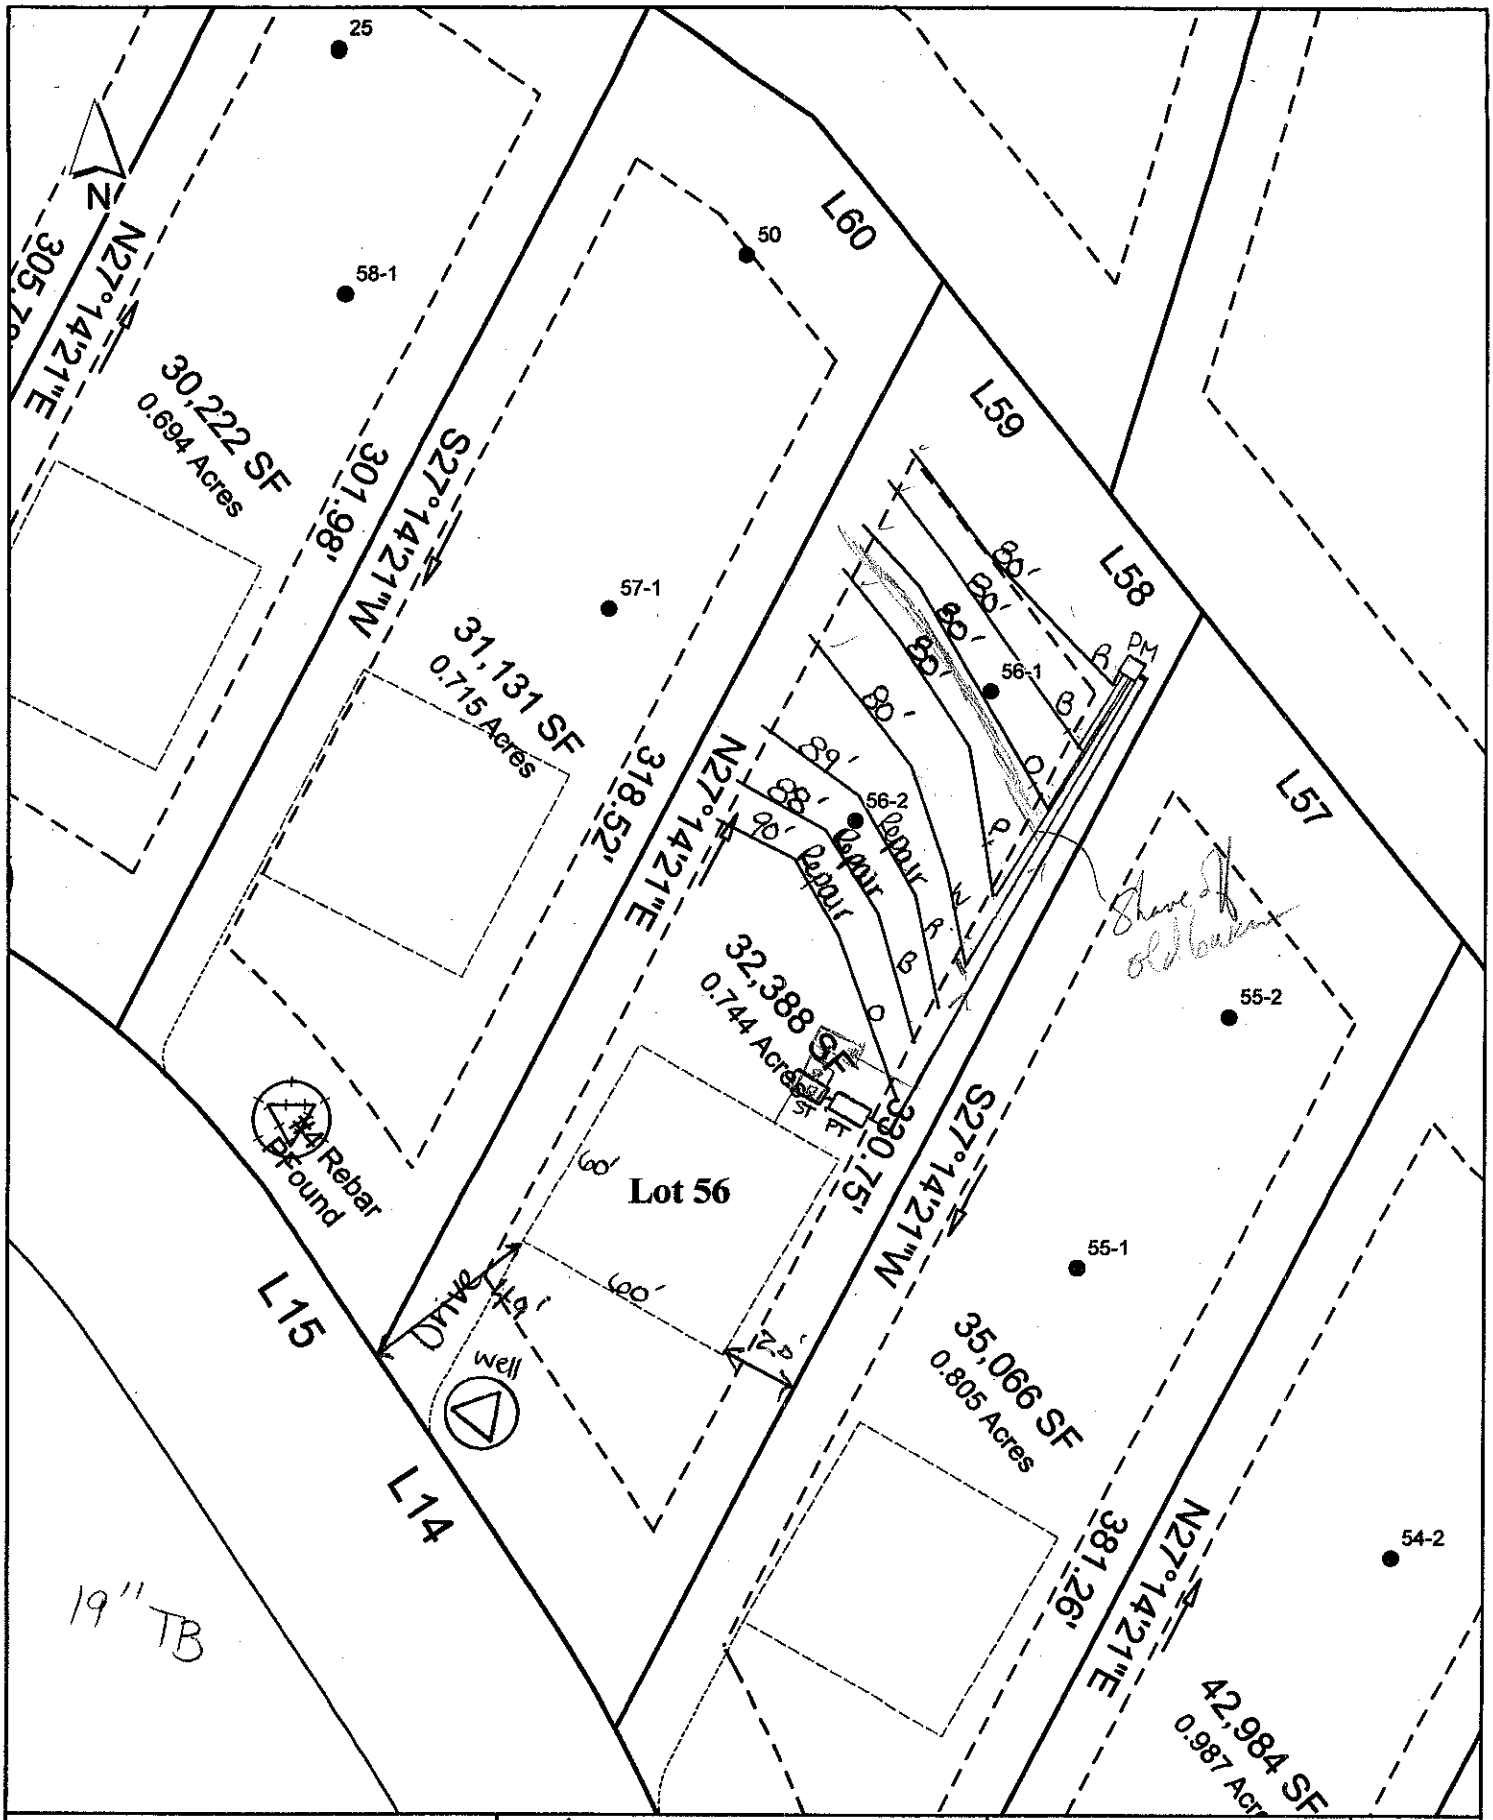

Scale: 1 inch equals 50 feet	S&ME	Woodleaf - Phase I	FIGURE
Drawn by: JBP		Lot 56	1
Reviewed by: PGP		Iredell County, NC	
Date: May, 2006	ENVIRONMENTAL SERVICES • ENGINEERING • TESTING	S&ME Project #1588-05-121	