2-2130

IREDELL COUNTY HEALTH DEPARTMENT

STATESVILLE 704-878-5305 MOORESVILLE 704-664-5281

IMPROVEMENT PERMIT / AUTHORIZATION TO CONSTRUCT / OPERATION PERMIT / EXISTING SYSTEM INSPECTION

PERMIT# ~~14239~~ 202338 PIN# 4639218089.063 4639 32 2506 DATE 5-15-07

OWNER OR APPLICANT Woodbridge Partners LLC/Geoffrey Bowen PHONE: Business _____ Home _____

ADDRESS PO Box 3608 Mooresville NC 28117

LOCATION Perth Rd N TL Fern Hill on left 943 Fern Hill Rd

SUBDIVISION Woodleaf BLOCK / SECTION 2 LOT 63 LOT AREA 1.420 Ac SITE CLASS. PS DESIGN FLOW 480 gpd L.T.A.R. .25 gpd/ft²

Septic Tank: 1000 Gallons; STB 825 Date 8-17-14

Pump Tank: 1000 Gallons; PT 302 Date 8-17-14

Pump Make: Liberty Model PL-50 Serial No. _____

Nitrification Field: No Fields 1 Square Feet 1440 Linear Feet 480

No Lines 4 Trench Width 36" Max Trench Bottom Depth 36" Gravel Depth NA ☐ Gravity ☒ Pressure

☒ New System ☐ Repair ☐ Expansion System Type: I II III IV V VI

System Description: 25% reduction pm

Repair System Description: LP PPBPS

Maintenance Agreement Required: ☐ Yes ☒ No

☒ House/Mod. Home ☐ Mobile Home ☐ Business ☐ Other

No. Bedrooms 4 No. Persons 8 No. Employees _____

Water Supply: ☒ Individual ☐ Public ☐ Community

☐ Slab ☐ Crawl Space ☒ Basement w/plumbing ☐ Basement wo/plumbing

Comments:/Conditions:

Install with 36 inch Trench bottom

Comments:/Conditions: 10/2/14 Set 2ff pressure Checked tanks & lines. Inst Installed Quick 4

INITIAL SITE SKETCH

See Plan from S&ME

AS BUILT SKETCH

Permit can be suspended or revoked if any false information is supplied toward securing the permit/any unauthorized changes are made to the site/any unauthorized changes are made in the installation of the system. Improvement Permit with plat valid without expiration ☐ Improvement Permit with site plan valid for sixty months ☒ Authorization to Construct is valid for a period equal to that of Improvement Permit - not to exceed sixty months.

Signed: Kathleen Saunders date 5/24/07

Improvement Permit by: Judy McNille date 5-15-07

Authorization to Construct by: Judy McNille date 3-27-14

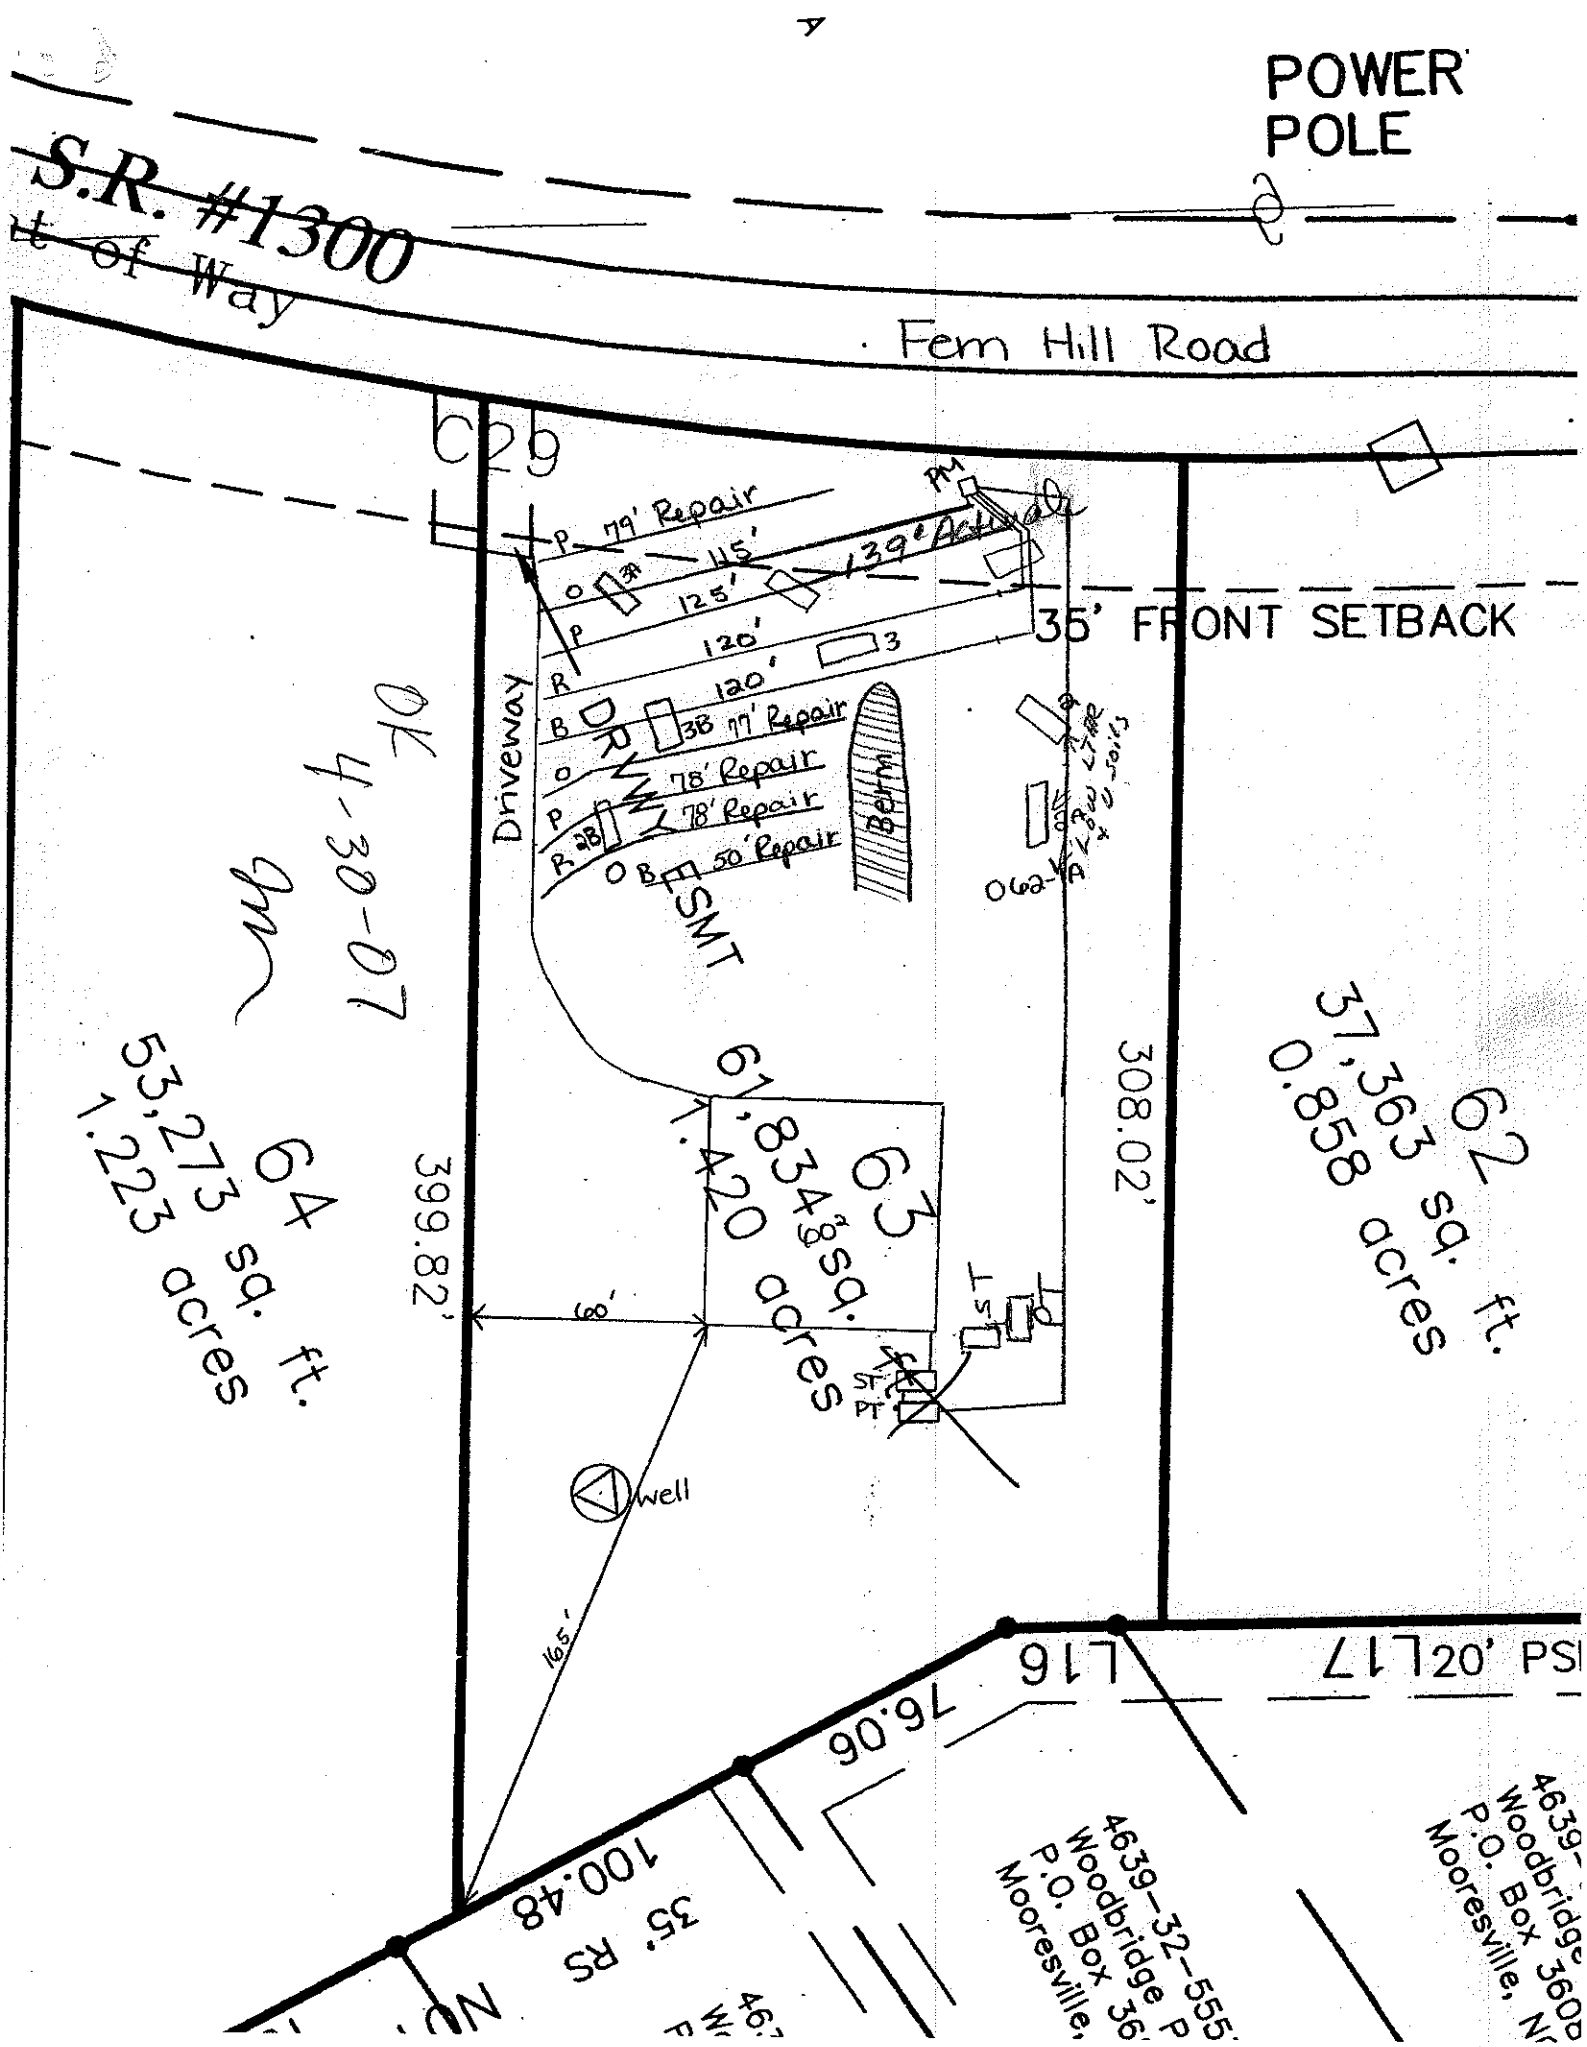
Installed by: Rowan Septic

Operation Permit by: _____ date _____

APPROVED OCT 24 2014

Existing System Inspection by: _____ date _____

HEALTH DEPT. COPY: WHITE OWNER COPY (FINAL): YELLOW OWNER COPY (INITIAL): PINK


POWER POLE
S.R. #1300
t of Way
Fern Hill Road
C29
79' Repair
115'
139' Actual
125'
120'
120'
38' 79' Repair
78' Repair
78' Repair
50' Repair
35' FRONT SETBACK
Driveway
Berm
SMT
062-4A
OK 4-30-07
64
53,273 sq. ft.
1.223 acres
399.82'
61
1.420 acres
63
1.834 sq.
acres
60'
308.02'
62
37,363 sq. ft.
0.858 acres
well
165'
L16
76.06
L17
20' PSI
100.48
35' RS
4639-32-555
Woodbridge P
P.O. Box 36
Mooresville,