2130 ✓

IREDELL COUNTY HEALTH DEPARTMENT

STATESVILLE 704-878-5305 MOORESVILLE 704-664-5281

IMPROVEMENT PERMIT / AUTHORIZATION TO CONSTRUCT / OPERATION PERMIT / EXISTING SYSTEM INSPECTION

PERMIT# 13605 20259 PIN# ~~4639-42-0136.031~~ 4639-32-2974 DATE August 8, 2006

OWNER OR APPLICANT Woodbridge Partners, LLC / Princeton PHONE: Business _____ Home _____

ADDRESS P.O. Box 3605 Mooresville N.C. 28117

LOCATION South Rd. (N) TL Fern Hill Rd. TL Blue Ridge Trail 1st lot on Right

SUBDIVISION Woodleaf BLOCK / SECTION _____ LOT 31 LOT AREA 1.06ac SITE CLASS. FS DESIGN FLOW 480gpd L.T.A.R. .03

Septic Tank: 1000 Gallons: STB 825 Date 4-14-14
Pump Tank: _____ Gallons: PT _____ Date _____
Pump Make: _____ Model _____ Serial No. _____
Nitrification Field: No Fields 1 Square Feet 1200 Linear Feet 400
No. Lines 3 Trench Width 36" Max Trench Bottom Depth 36"

☒ New System ☐ Repair ☐ Expansion System Type: I II III IV V VI
System Description: Gravity 25% Reduction
Repair System Description: pm 25% Reduction
Maintenance Agreement Required: ☐ Yes ☒ No

☒ House/Mod. Home No. Bedrooms 4
☐ Mobile Home No. Persons ____
☐ Business No. Employees ____
☐ Other _____

Water Supply: ☒ Individual ☐ Public ☐ Community

Gravel Depth N/A ☒ Gravity ☐ Pressure ☐ Slab ☒ Crawl Space ☐ Basement w/plumbing ☐ Basement wo/plumbing

Comments:/Conditions:

Comments:/Conditions: Used Quick 4 installed as drawn.

INITIAL SITE SKETCH

SEE PLAN from S&ME

AS BUILT SKETCH

Permit can be suspended or revoked if any false information is supplied toward securing the permit/any unauthorized changes are made to the site/any unauthorized changes are made in the installation of the system. Improvement Permit with plat valid without expiration ☐ Improvement Permit with site plan valid for sixty months ☒ Authorization to Construct is valid for a period equal to that of Improvement Permit – not to exceed sixty months.

Signed: Kathleen Saunders date 8/11/06

Improvement Permit by: _____ date 8-8-06


Authorization to Construct by: _____ date 1-17-14

Installed by: Rowan Septic

Operation Permit by: _____ RS. date 6/23/14

Existing System Inspection by: _____ date _____

HEALTH DEPT. COPY: WHITE OWNER COPY (FINAL): YELLOW OWNER COPY (INITIAL): PINK

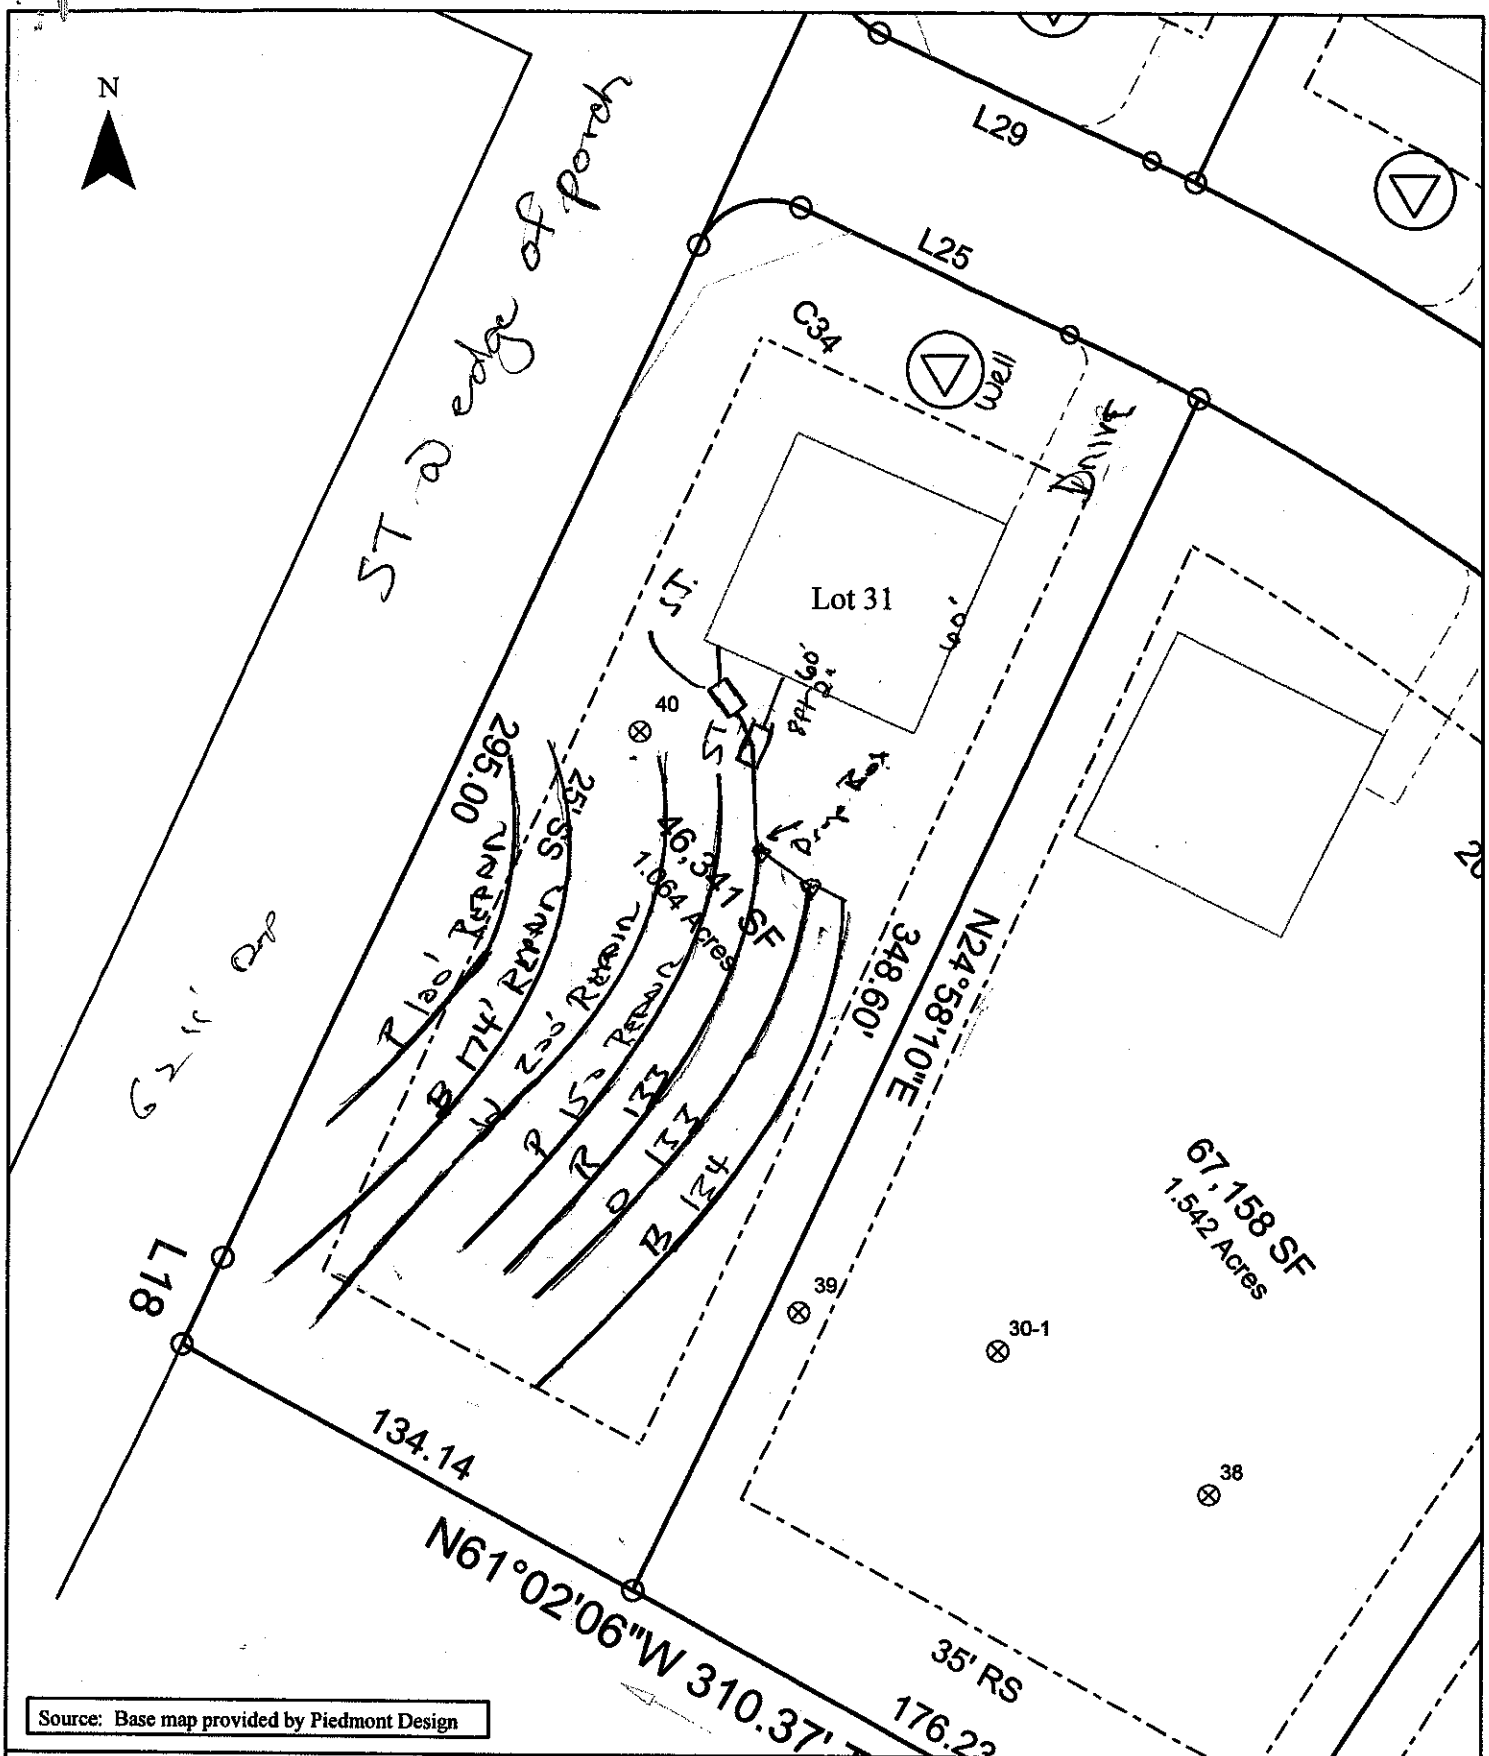

Source: Base map provided by Piedmont Design

Scale: 1 inch equals 50 feet	S&ME	Woodleaf Subdivision	FIGURE
Drawn by: JBP		Lot 31	1
Reviewed by: PGP		Iredell County, NC	
Date: June, 2006	ENVIRONMENTAL SERVICES • ENGINEERING • TESTING	S&ME Project #1588-05-121	