IREDELL COUNTY HEALTH DEPARTMENT

STATESVILLE 704-878-5305 MOORESVILLE 704-664-5281

IMPROVEMENT PERMIT / AUTHORIZATION TO CONSTRUCT / OPERATION PERMIT / EXISTING SYSTEM INSPECTION

PERMIT# 136500 PIN# 4639420136-026 4639-32-5365 DATE 4-3-07

OWNER OR APPLICANT Just mor Homes PHONE: Business 363-9354 Home

ADDRESS

LOCATION Perth Rd N TL Fern Hill Rd TL Blue Ridge Trail on right

SUBDIVISION Woodleft BLOCK / SECTION LOT 26 LOT AREA .945 Acres SOIL CLASS. PS DESIGN FLOW 600gpd L.T.A.R. .3

Septic Tank: 1500 Gallons; STB 528 Date 8/15/06

Pump Tank: Gallons; PT Date

Pump Make: Model Serial No.

Nitrification Field: No Fields 1 Square Feet 1512 Linear Feet 504

No Lines 7@72 Trench Width 36" Max Trench Bottom Depth 32"

☒ New System ☐ Repair ☐ Expansion System Type: I II III IV V VI

System Description: Gravity-25% Reduction

Repair System Description: Panel Block 25% Red

Maintenance Agreement Required: ☐ Yes ☒ No

Gravel Depth N/A ☒ Gravity ☐ Pressure

☒ House/Mod. Home ☐ Mobile Home ☐ Business ☐ Other

No. Bedrooms 5 No. Persons No. Employees

Water Supply: ☒ Individual ☐ Public ☐ Community


☐ Slab ☐ Crawl Space ☐ Basement w/plumbing ☐ Basement wo/plumbing

Comments:/Conditions:


Comments:/Conditions:

Scale 1:50

INITIAL SITE SKETCH

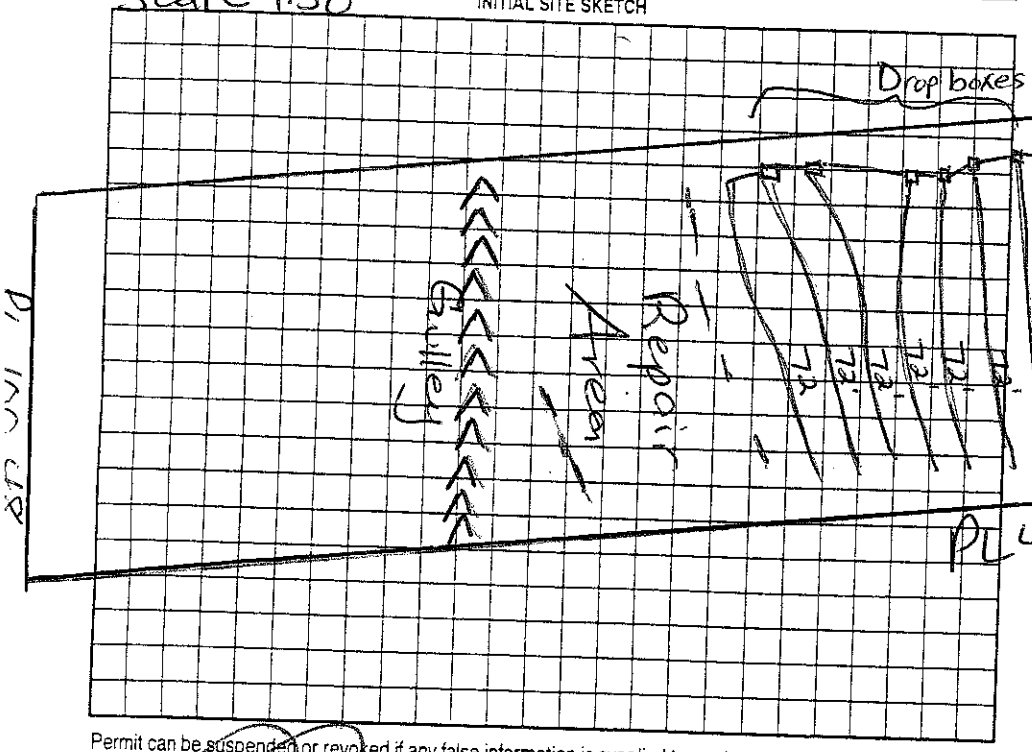

AS BUILT SKETCH

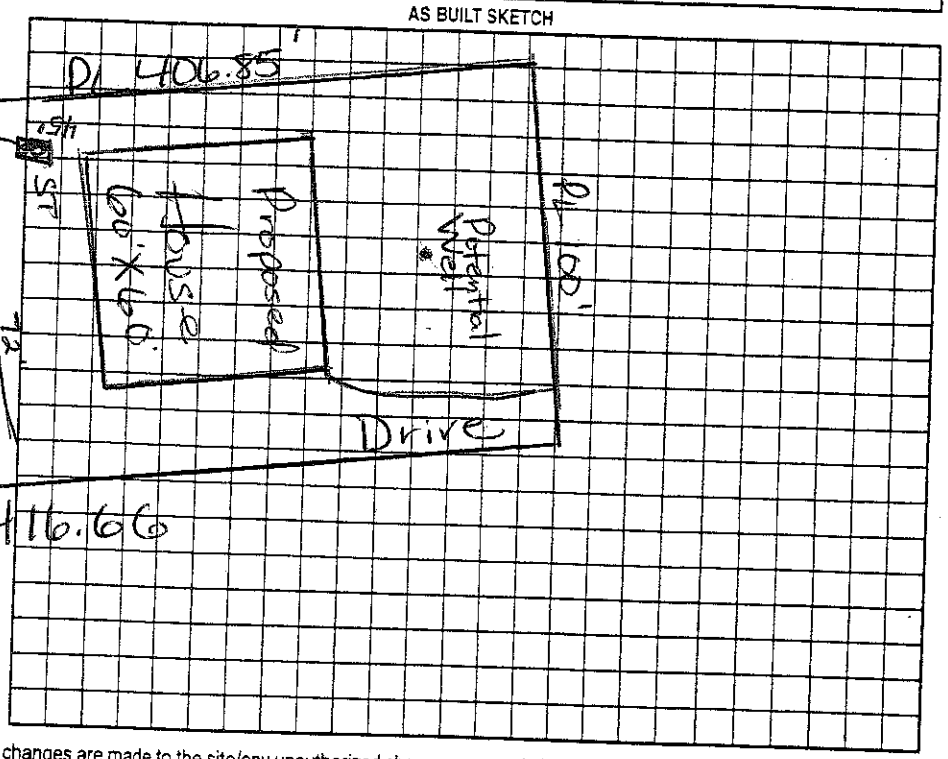

Permit can be suspended or revoked if any false information is supplied toward securing the permit/any unauthorized changes are made to the site/any unauthorized changes are made in the installation of the system. Improvement Permit with plat valid without expiration ☐ Improvement Permit with site plan valid for sixty months ☐ Authorization to Construct is valid for a period equal to that of Improvement Permit – not to exceed sixty months.

Signed: Just Mor Homes Inc date 4/4/2007

Improvement Permit by: Maria H. Nelson RS date 4/3/07

Authorization to Construct by: Maria H. Nelson RS date 4/3/07

Installed by: C+S Grading

Operation Permit by: Wade Sparks R.S. date 9/26/07

Existing System Inspection by: date

HEALTH DEPT. COPY: WHITE OWNER COPY (FINAL): YELLOW OWNER COPY (INITIAL): PINK