COPY

IREDELL COUNTY HEALTH DEPARTMENT

STATESVILLE 704-878-5305 MOORESVILLE 704-664-5281

IMPROVEMENT PERMIT / AUTHORIZATION TO CONSTRUCT / OPERATION PERMIT / EXISTING SYSTEM INSPECTION

PERMIT # Repair/16095 PIN # 4639325553 DATE 6-17-2010

OWNER or APPLICANT William Bellas PHONE: Business 704 508-1745 Home: 708663-6865

OWNER or APPLICANT ADDRESS 134 Blue Ridge Trail Mooresville NC 28117

LOCATION / DIRECTIONS Perth Rd N TL Fern Hill TL Blue Ridge Trail on right #134

SUBDIVISION Woodleaf BLOCK / SECTION LOT # 28 LOT AREA 1.896Ac DESIGN FLOW 480 gpd L.T.A.R. .3

Existing

Septic Tank 1000 Gallons: STB 794 Date 7-13-07

Pump Tank Gallons: P.T. Date

Pump Make Model Replacing 2 Serial #

Nitrification Field No Fields 1 No Lines 5 Linear Feet 400

Trench Width 36" Max. Trench Bottom Depth 36" Gravel Depth N/A

☐ New System ☒ Repair ☐ Expansion System Type I II III IV V VI

System Description: Gravity - 25% Reduction

Repair System Description: LPP PP BPS

Maintenance Agreement Required ☐ YES ☐ NO

☒ GRAVITY ☐ PRESSURE

☒ Residence No. Bedrooms 4

☐ Business No. Persons

☐ Other No. Employees

☐ Slab ☐ Crawl Space


☐ Basement w/plumbing ☐ Basement w/o plumbing

Water Supply: ☒ Private ☐ Public ☐ Community

Comments / Conditions: Replacing upper 2 lines from original drainfield. Abandon upper 2 lines & install 2 below existing system

Comments / Conditions: ADSC

INITIAL SITE SKETCH

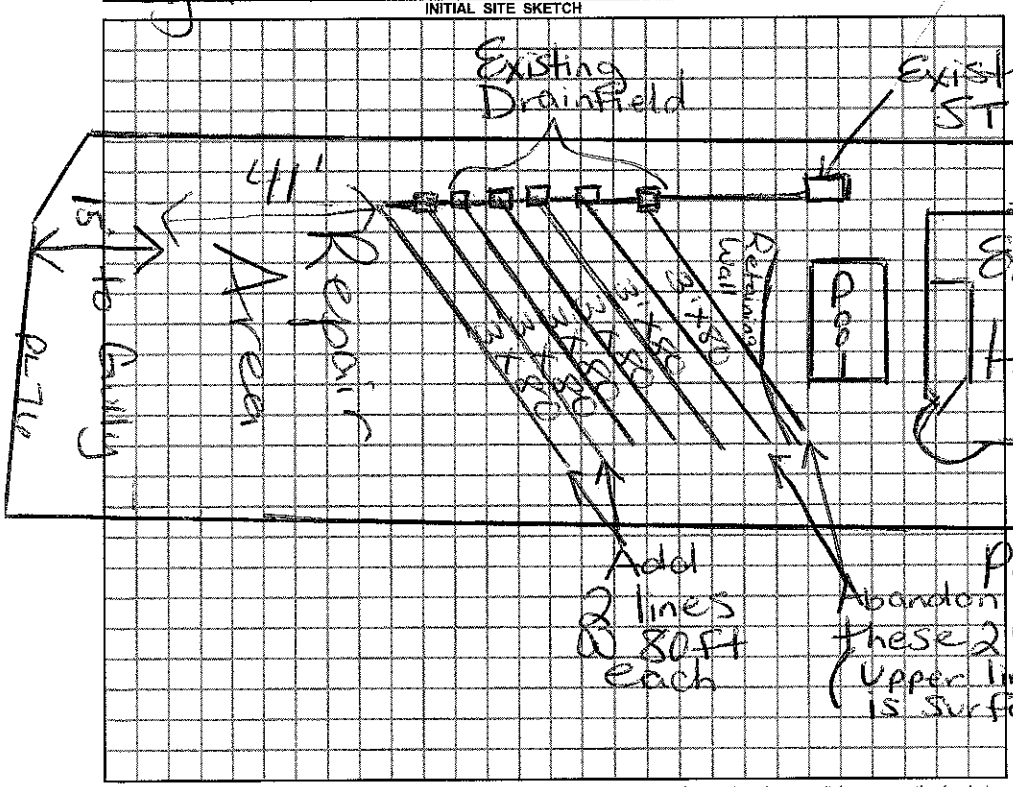

AS BUILT SKETCH

Permit can be suspended or revoked if any false information is supplied toward securing the permit / any unauthorized changes are made to the site / any unauthorized changes are made in the installation of the system.

☐ IMPROVEMENT PERMIT w / plat valid without expiration. ☐ IMPROVEMENT PERMIT w / site plan valid for 60 mos. ☐ AUTHORIZATION TO CONSTRUCT valid for period equal to IMPROVEMENT PERMIT-not to exceed 60 mo.

Owner / Applicant Signature: Rhonda Bellas Date 6/17/2010

Improvement Permit by: Maria Dolson RS Date 6/17/2010

Authorization to Construct by: Maria Dolson RS Date 6/17/2010

Repair

YOU SHOULD CONTACT A LOCATOR SERVICE PRIOR TO ANY EXCAVATION.

Installed by: R&T RE Hs

Operation Permit by: Maria Dolson Date: 6/24/2010

Existing System Inspected by: Date:

WHITE COPY Environmental Health YELLOW COPY (Final) Owner / Applicant PINK COPY (Initial) Owner / Applicant