IREDELL COUNTY HEALTH DEPARTMENT

STATESVILLE 704-878-5305 MOORESVILLE 704-664-5281

IMPROVEMENT PERMIT / AUTHORIZATION TO CONSTRUCT / OPERATION PERMIT / EXISTING SYSTEM INSPECTION

PERMIT # Repair/16095 PIN # 4639325553 DATE 6-17-2010

OWNER or APPLICANT William Bellas PHONE: Business 704 508-1745 Home: 708663-6865

OWNER or APPLICANT ADDRESS 134 Blue Ridge Trail Mooresville, NC 28117

LOCATION / DIRECTIONS Perth Rd N TL Fern Hill TL Blue Ridge Trail on right #134

SUBDIVISION Woodleaf BLOCK / SECTION LOT # 28 LOT AREA 1.896Ac DESIGN FLOW 480gpd L.T.A.R. .3

Existing

Septic Tank 1000 Gallons: STB 794 Date 7-13-07 | ☐ New System ☒ Repair ☐ Expansion System Type I II III IV V VI | ☒ Residence No. Bedrooms 4 | Water Supply ☒ Private ☐ Public ☐ Community

Pump Tank Gallons: P T Date | System Description: Gravity - 25% Reduction | ☐ Business No. Persons

Pump Make Model Replacing 2 Serial # | Repair System Description: LPP PP BPS | ☐ Other No. Employees


Nitrification Field No Fields 1 No Lines 5 Linear Feet 400 | Maintenance Agreement Required ☐ YES ☐ NO | ☐ Slab ☐ Crawl Space

Trench Width 36" Max. Trench Bottom Depth 36" Gravel Depth N/A | ☒ GRAVITY ☐ PRESSURE | ☐ Basement w/plumbing ☐ Basement w/o plumbing


Comments / Conditions: Replacing Upper 2 lines from original drainfield. Abandon upper 2 lines & install 2 below existing system

Comments / Conditions: ADS 36

INITIAL SITE SKETCH

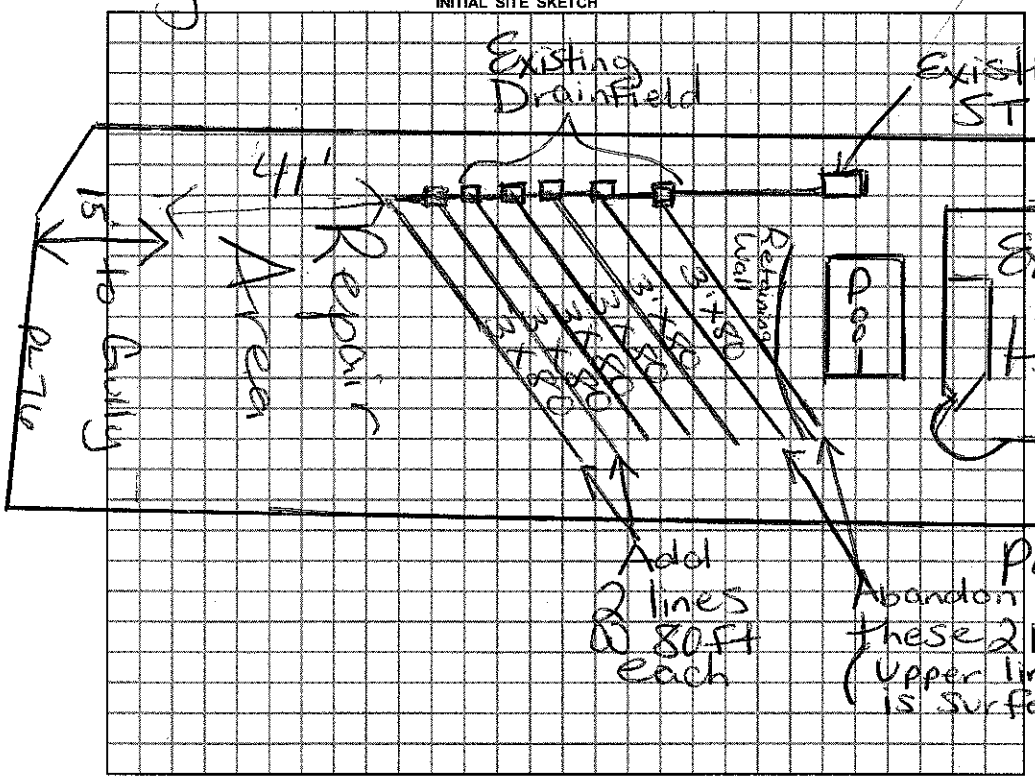

AS BUILT SKETCH

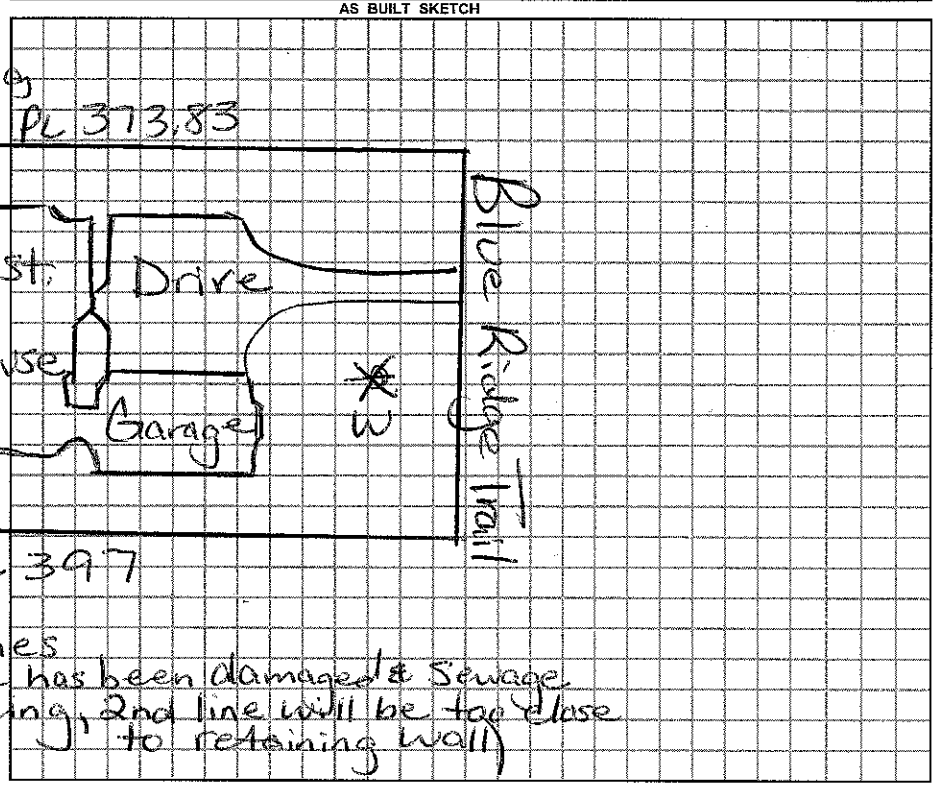

Permit can be suspended or revoked if any false information is supplied toward securing the permit / any unauthorized changes are made to the site / any unauthorized changes are made in the installation of the system.

☐ *IMPROVEMENT PERMIT w / plat valid without expiration.* ☐ *IMPROVEMENT PERMIT w / site plan valid for 60 mos.* ☐ *AUTHORIZATION TO CONSTRUCT valid for period equal to IMPROVEMENT PERMIT-not to exceed 60 mo.*

Owner / Applicant Signature: Rhonda Bellas Date 6/17/2010 Installed by: R&T Backhoe REHS

Repair Improvement Permit by: Maina M. Dolan RS Date 6/17/2010 Operation Permit by: Maina M. Dolan Date: 6/21/2010

Authorzation to Construct by: Maina M. Dolan RS Date 6/17/2010 Existing System Inspected by: Date:

YOU SHOULD CONTACT A LOCATOR SERVICE PRIOR TO ANY EXCAVATION.

WHITE COPY Environmental Health YELLOW COPY (Final) Owner / Applicant PINK COPY (Initial) Owner / Applicant