IREDELL COUNTY HEALTH DEPARTMENT

STATESVILLE 704-878-5305 MOORESVILLE 704-664-5281

IMPROVEMENT PERMIT / AUTHORIZATION TO CONSTRUCT / OPERATION PERMIT / EXISTING SYSTEM INSPECTION

2:00

PERMIT# 136497 PIN# 4639 42 0136.023 4639-32-6034

OWNER OR APPLICANT Justmore Homes

ADDRESS 180 West Montana Rd Mooresville NC 28115 PHONE: Business Rick → 704.799-9364 Home

DATE 6/27/07

LOCATION Perth Rd Fern Hill @ Blue Ridge Trail, Lot on Right

SUBDIVISION Woodleaf BLOCK / SECTION LOT 23 LOT AREA 1.23 Acre SITE CLASS P.S DESIGN FLOW 600 L.T.A.R. .50

Septic Tank: 1500 Gallons: STB 528 Date 8-6-01

Pump Tank: Gallons: PT Date

Pump Make: Model Serial No.

Nitrification Field: No Fields 1 Square Feet 1500 Linear Feet 500

No Lines 6@84 Trench Width 36" Max Trench Bottom Depth 36" Gravel Depth

☒ New System ☐ Repair ☐ Expansion System Type: I II III IV V VI

System Description: Gravity → 25% Reduced

Repair System Description: 54 ME

Maintenance Agreement Required: ☐ Yes ☒ No

☒ Gravity ☐ Pressure ☐ Slab ☐ Crawl Space ☒ Basement w/plumbing ☐ Basement wo/plumbing

☒ House/Mod. Home No. Bedrooms 3

☐ Mobile Home No. Persons

☐ Business No. Employees


☐ Other

Water Supply: ☒ Individual ☐ Public ☐ Community


Comments/Conditions: 1) Install lines (6@84' each) on contour 2) Keep D-Box & supply line(s) at least 5ft from prop. lines & drain lines 10ft from P.L. 3) 5T → = 150 gallons

Comments/Conditions: Yellow filter installed Use Quick 4 for Drainfield with "Built in drop boxes"

INITIAL SITE SKETCH

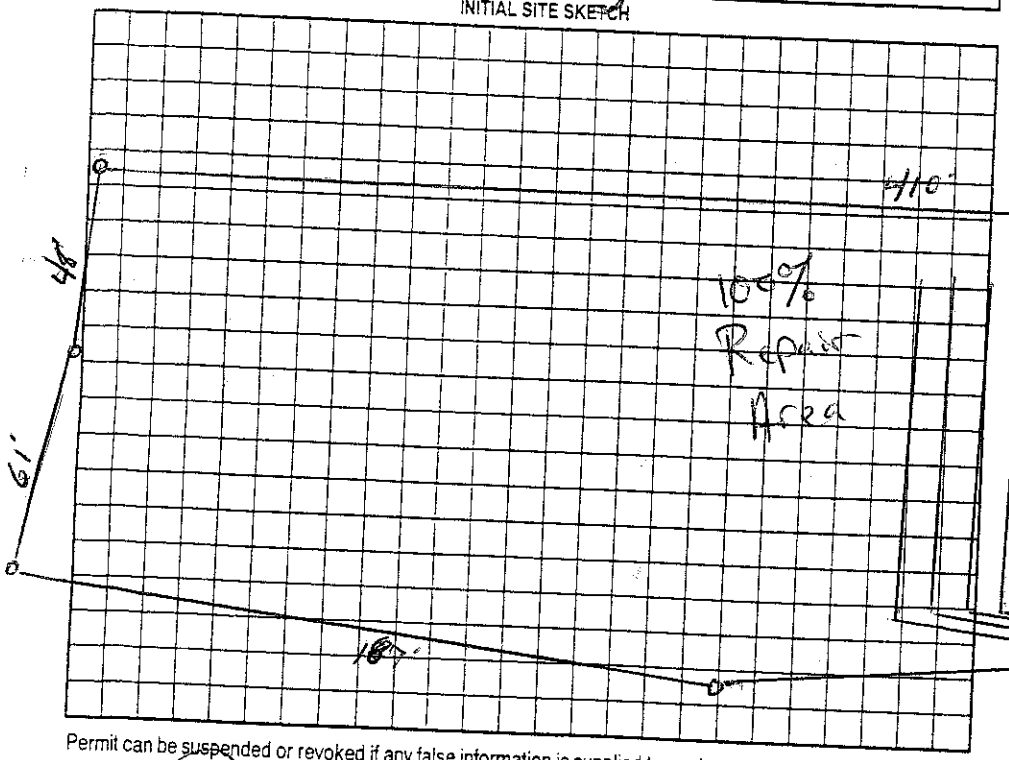

AS BUILT SKETCH

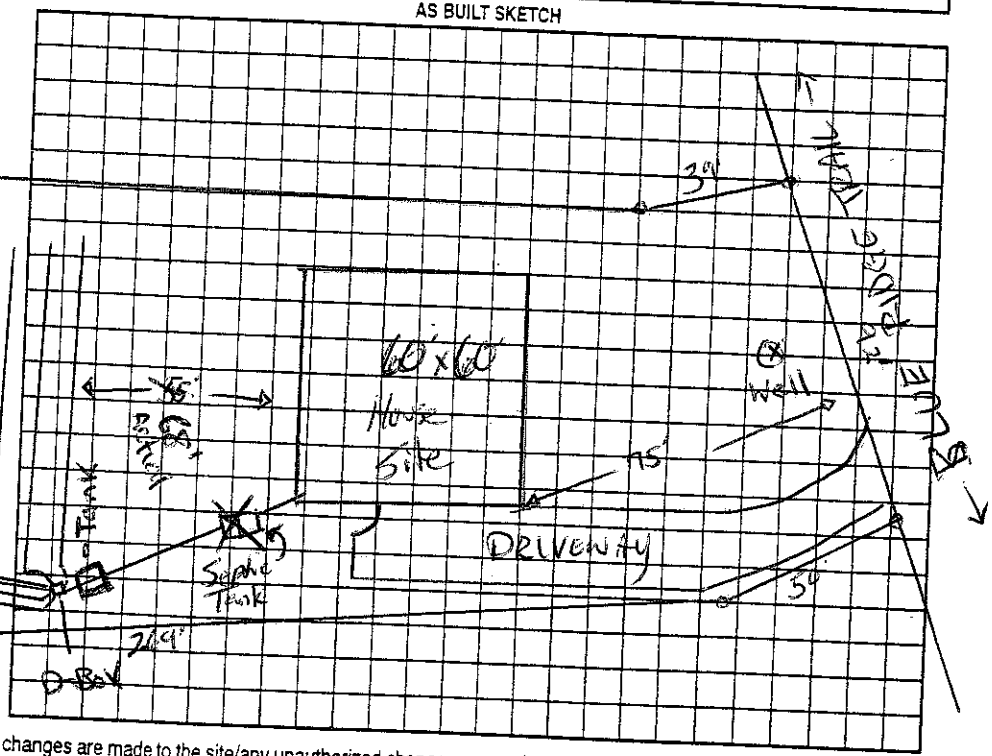

Permit can be suspended or revoked if any false information is supplied toward securing the permit/any unauthorized changes are made to the site/any unauthorized changes are made in the installation of the system. Improvement Permit with plat valid without expiration. ☐ Improvement Permit with site plan valid for sixty months ☒ Authorization to Construct is valid for a period equal to that of Improvement Permit – not to exceed sixty months.

Signed:

Improvement Permit by: Joh E Ayd date 6/28/2007

Authorization to Construct by: Joh E Ayd date 6/27/07

Installed by: C & S Grading date 12/17/07

Operation Permit by: Maria H Wolcott

Existing System Inspection by: date

HEALTH DEPT. COPY: WHITE OWNER COPY (FINAL): YELLOW OWNER COPY (INITIAL): PINK