IREDELL COUNTY HEALTH DEPARTMENT

STATESVILLE 704-878-5305 — MOORESVILLE 704-664-5281

IMPROVEMENT PERMIT / AUTHORIZATION TO CONSTRUCT / OPERATION PERMIT / EXISTING SYSTEM INSPECTION

2: 0C

PERMIT# 136497 PIN# 4639 42 0136.023 4639-32-6034 DATE 6/27/07

OWNER OR APPLICANT Justmore Homes PHONE: Business Kirk → 704-799-9367 Home

ADDRESS 140 West Montana Dr Mooresville NC 28115

LOCATION Depth 10 Feet Left @ Blue Ridge Trail, Lot on Right

SUBDIVISION Woodcliff BLOCK / SECTION LOT 23 LOT AREA 1.23 Acre SITE CLASS P3 DESIGN FLOW 600 L.T.A.R. .50

Septic Tank 1500 Gallons STB 528 Date 6-6-07

Pump Tank Gallons PT Date

Pump Make Model Serial No.

Nitrification Field: No Fields 1 Square Feet 1500 Linear Feet 500

No Lines 6@84 Trench Width 36" Max Trench Bottom Depth 36" Gravel Depth —

☒ New System ☐ Repair ☐ Expansion System Type: I II III IV V

System Description: Conv. → 25% Reduced

Repair System Description: STM

Maintenance Agreement Required: ☐ Yes ☒ No

☒ Gravity ☐ Pressure

☒ House/Mod. Home ☐ Mobile Home ☐ Business ☐ Other


No. Bedrooms 3 No. Persons No. Employees

Water Supply: ☒ Individual ☐ Public ☐ Community

☐ Slab ☐ Crawl Space ☒ Basement w/plumbing ☐ Basement w/o plumbing


Comments/Conditions: 1) Install lines (6@84' each) on contour 2) Keep D Box & supply line(s) at least 5ft from drop lines & drain lines 10ft from p.l. 3) S.F. = 150 sq ft/line

INITIAL SITE SKETCH

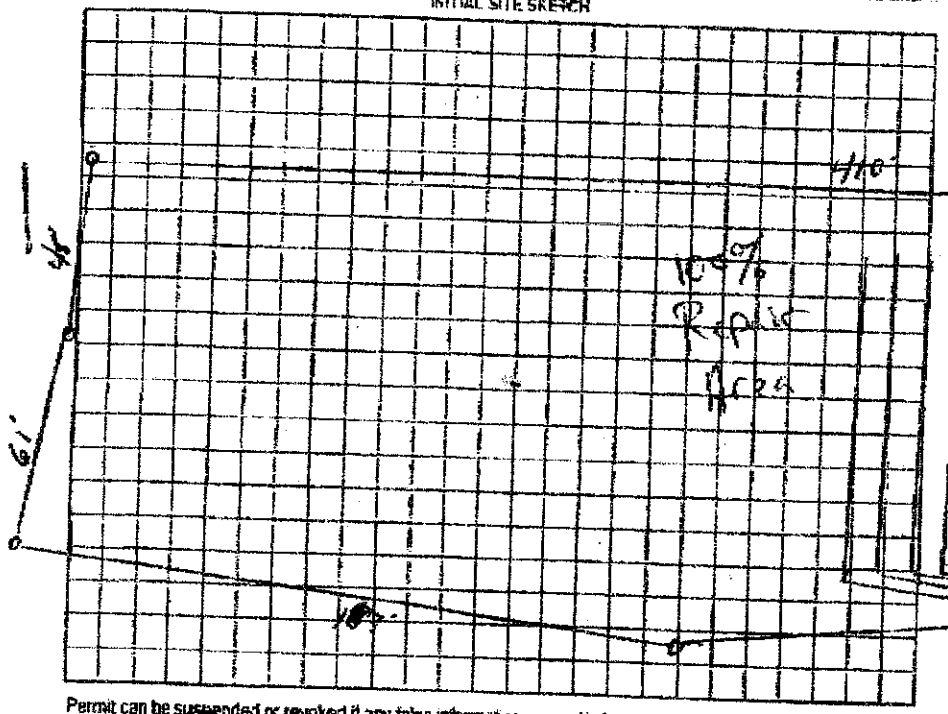

Comments/Conditions: Yellow fitter installed Use Quicky for Drainfield with "Built in drop boxes"

AS BUILT SKETCH

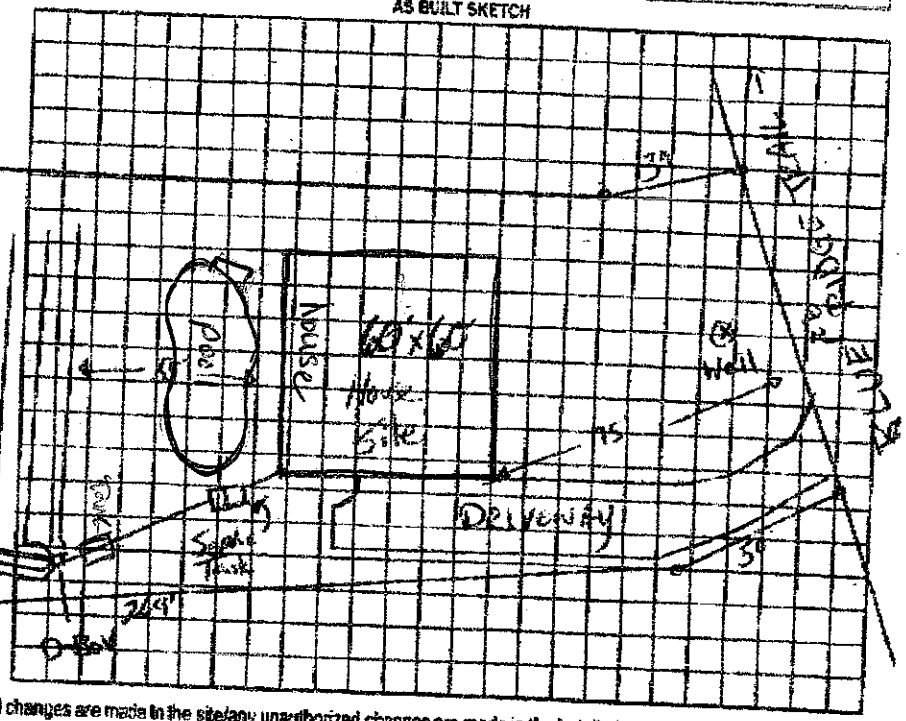

Permit can be suspended or revoked if any false information is supplied toward securing the permit/any unauthorized changes are made in the site/any unauthorized changes are made in the installation of the system. Improvement Permit with plat valid without expiration ☐ Improvement Permit with site plan valid for sixty months ☒ Authorization to Construct is valid for a period equal to that of Improvement Permit – not to exceed sixty months.

Signed:

Improvement Permit by: [signature] date 6/28/2007

Authorization to Construct by: [signature] date 6/27/07

Installed by: [signature] date

Operation Permit by: [signature] date 12/17/07

Existing System Inspection by: date

HEALTH DEPT COPY: WHITE OWNER COPY (FINAL): YELLOW OWNER COPY (INITIAL): PINK

PAGE 02