Existing System owner 120.00

IREDELL COUNTY HEALTH DEPARTMENT

STATESVILLE 704-878-5305 MOORESVILLE 704-664-5281

IMPROVEMENT PERMIT / AUTHORIZATION TO CONSTRUCT / OPERATION PERMIT / EXISTING SYSTEM INSPECTION

PERMIT # 154136 PIN # 4639329389.000 DATE 12/17/08

OWNER or APPLICANT Ed Findysz c/o Carolina Custom Remodeling PHONE: Business 704 516-1754 Home: 704 799-1755

OWNER or APPLICANT ADDRESS 143 Blue Ridge Trail Mooresville NC 28117

LOCATION / DIRECTIONS Perth Rd. (N) TR Farm Hill Rd. TL Blue Ridge Tr. on Left

SUBDIVISION Woodleaf BLOCK / SECTION LOT # 12 LOT AREA 1.06 DESIGN FLOW 480 (Exis.) L.T.A.R. .25

Septic Tank Exis 1000 Gallons: STB Date

Pump Tank Gallons: P T Date

Pump Make Model Serial #

Nitrification Field No Fields No Lines 6x6 Linear Feet Exis 480

Trench Width Ex. 36" Max. Trench Bottom Depth Ex. 36" Gravel Depth N/A

☐ New System ☐ Repair ☐ Expansion System Type I (II) III IV V VI

System Description: Existing Gravity 25% Reduction

Repair System Description:

Maintenance Agreement Required ☐ YES ☐ NO

☑ GRAVITY ☐ PRESSURE

☐ Residence No. Bedrooms

☐ Business No. Persons

☐ Other No. Employees

☐ Slab ☐ Crawl Space


☐ Basement w/plumbing ☐ Basement w/o plumbing

Water Supply: ☑ Private (Exis) ☐ Public ☐ Community


Comments / Conditions See Original Permit "Woodleaf Partners" 3/18/08 Permit # 136480

Comments / Conditions This permit is For a 20'x20' Storage/Garage building that is Not to have plumbing. * No Driving over septic system Building must be 5' min from Existing Drainfield.

INITIAL SITE SKETCH

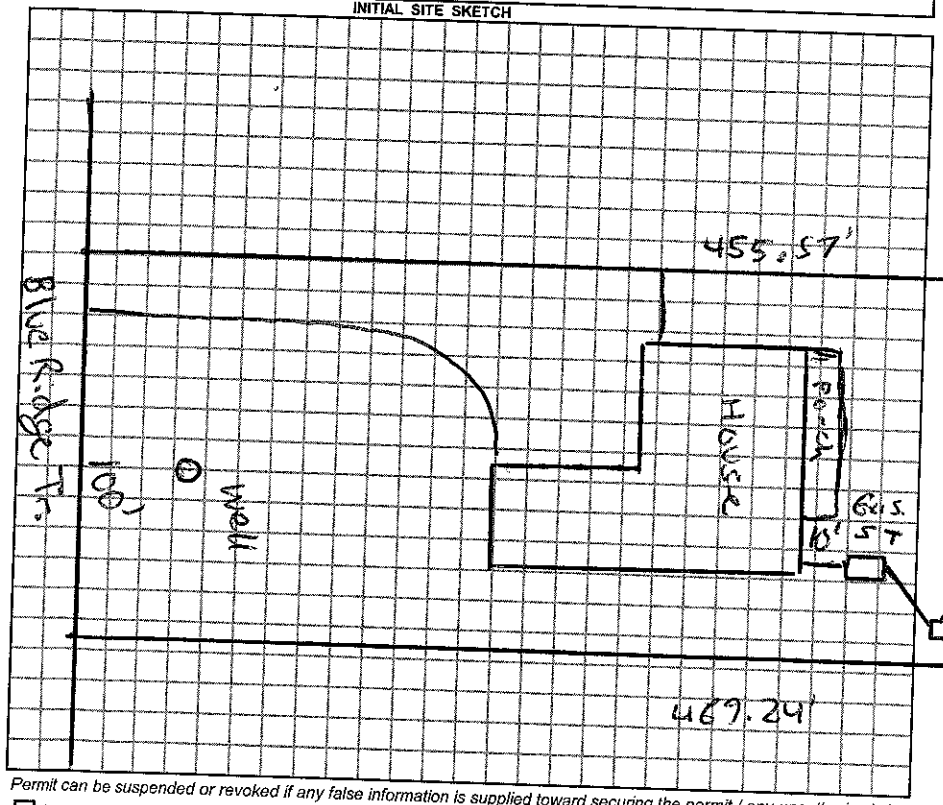

AS BUILT SKETCH

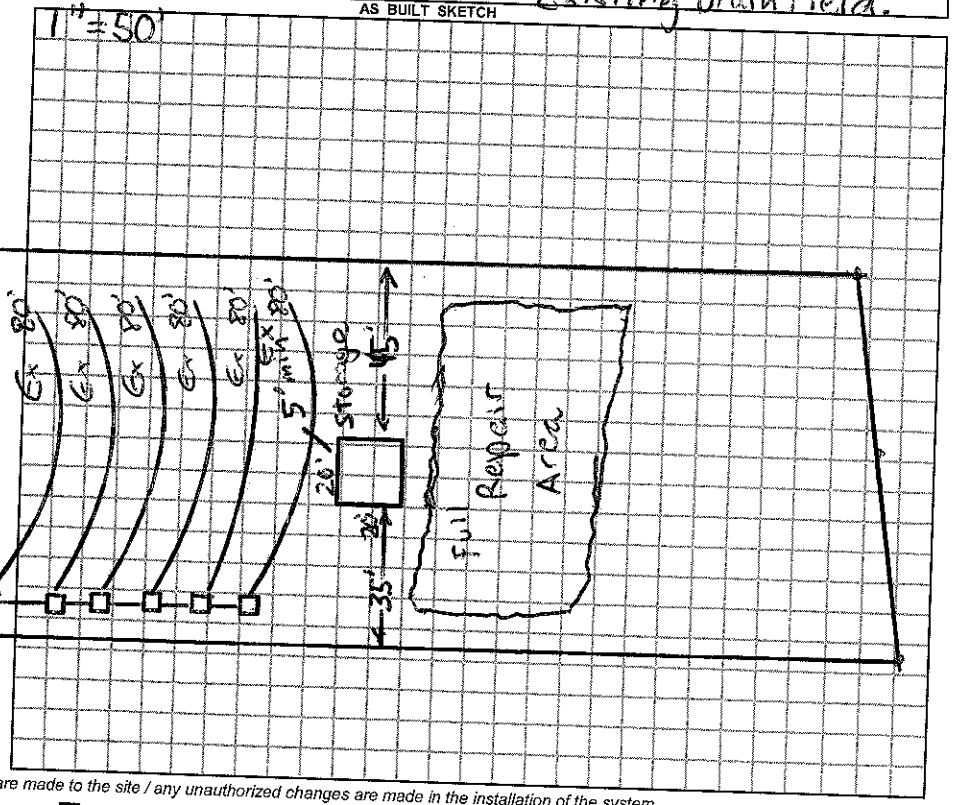

Permit can be suspended or revoked if any false information is supplied toward securing the permit / any unauthorized changes are made to the site / any unauthorized changes are made in the installation of the system.

☐ *IMPROVEMENT PERMIT w / plat valid without expiration.* ☐ *IMPROVEMENT PERMIT w / site plan valid for 60 mos.* ☐ *AUTHORIZATION TO CONSTRUCT valid for period equal to IMPROVEMENT PERMIT-not to exceed 60 mo.*

Owner / Applicant Signature: Date 12-17-08

Improvement Permit by: Date

Authorzation to Construct by: Date

YOU SHOULD CONTACT A LOCATOR SERVICE PRIOR TO ANY EXCAVATION.

Installed by:

Operation Permit by: Date:

Existing System Inspected by: Anthony Coker L.R.S. Date: 12/17/08

WHITE COPY Environmental Health YELLOW COPY (Final) Owner / Applicant PINK COPY (Initial) Owner / Applicant