IREDELL COUNTY HEALTH DEPARTMENT

Statesville Office (704) 878-5305 Mooresville Office (704) 660-3625 PERMIT # 207065

IMPROVEMENT PERMIT / AUTHORIZATION TO CONSTRUCT / OPERATION PERMIT / EXISTING SYSTEM

PIN # 4639-32-9389

APPLICANT: Vinnie Pellegrino APPLICANT ADDRESS: P.O. Box 3608 Mooresville, NC 28117

SITE ADDRESS: 143 Blue Ridge Trail Mooresville NC PHONE: ALT. PHONE:

SITE DIRECTIONS: Perth to L. Fern Hill, TL Blue Ridge, Lot on L

SUBDIVISION: Woodleaf SECTION: LOT # 12 LOT AREA: 1.06 Acre DESIGN FLOW: 480 GPD L.T.A.R.: .25 (Existing)

Septic Tank Ex. 1000 (gal) STB Date
Pump Tank (gal) PT Date
Pump Make Model Serial #
Nitrification Fields # Lines Ex 6 Linear Ft: Ex. 480
Trench Width Ex. 36" Max. Trench Bottom Depth Ex 36" Gravel Depth N/A

☐ New System ☐ Repair ☐ Expansion System Type: I II (III) IV V VI
System Description: Existing 25% Reduction - Grav.
Repair System Description:
Maintenance Agreement Required: ☐ YES ☑ NO
☑ GRAVITY ☐ PRESSURE

☑ Residence No. Bedrooms 4
☐ Business No. Persons 8
☐ Other No. Employees
☐ Slab ☑ Crawl Space
☐ Basement w/plumbing ☐ Basement w/o plumbing

Water Supply
☑ Private Ex.
☐ Public
☐ Community

Comments / Conditions: Install Pad 15' from Existing Septic

INITIAL SITE SKETCH

See Updated Site Plan from Kathleen Saunders

APPROVED NOV 24 2014

AS BUILT SKETCH

Permit can be suspended or revoked if any false information is supplied toward securing the permit / any unauthorized changes are made to the site / any unauthorized changes are made in the installation of the system. **CONTACT A LOCATOR SERVICE PRIOR TO ANY EXCAVATION**

☐ **IMPROVEMENT PERMIT** *with plat valid without expiration.* ☐ **IMPROVEMENT PERMIT** *with site plan valid for 60 mos.* ☐ **AUTHORIZATION TO CONSTRUCT** *valid for period equal to IMPROVEMENT PERMIT--not to exceed 60 mo.*

Owner / Applicant Signature: Kathleen Saunders Date: 12-5-14 Installed by:

IMPROVEMENT PERMIT by: Date: OPERATION PERMIT by: Date:

AUTHORIZATION TO CONSTRUCT by: Date: Existing System Inspected by: APPROVED Date: NOV 24 2014

Health Dept. Copy - WHITE Applicant (Final Approval) - YELLOW Applicant (Conditional Approval) - PINK


CONNECTGIS WEB HOSTING

IREDELL COUNTY NORTH CAROLINA

APPROVED NOV 24 2014
IredD

Search

1:60 Feet

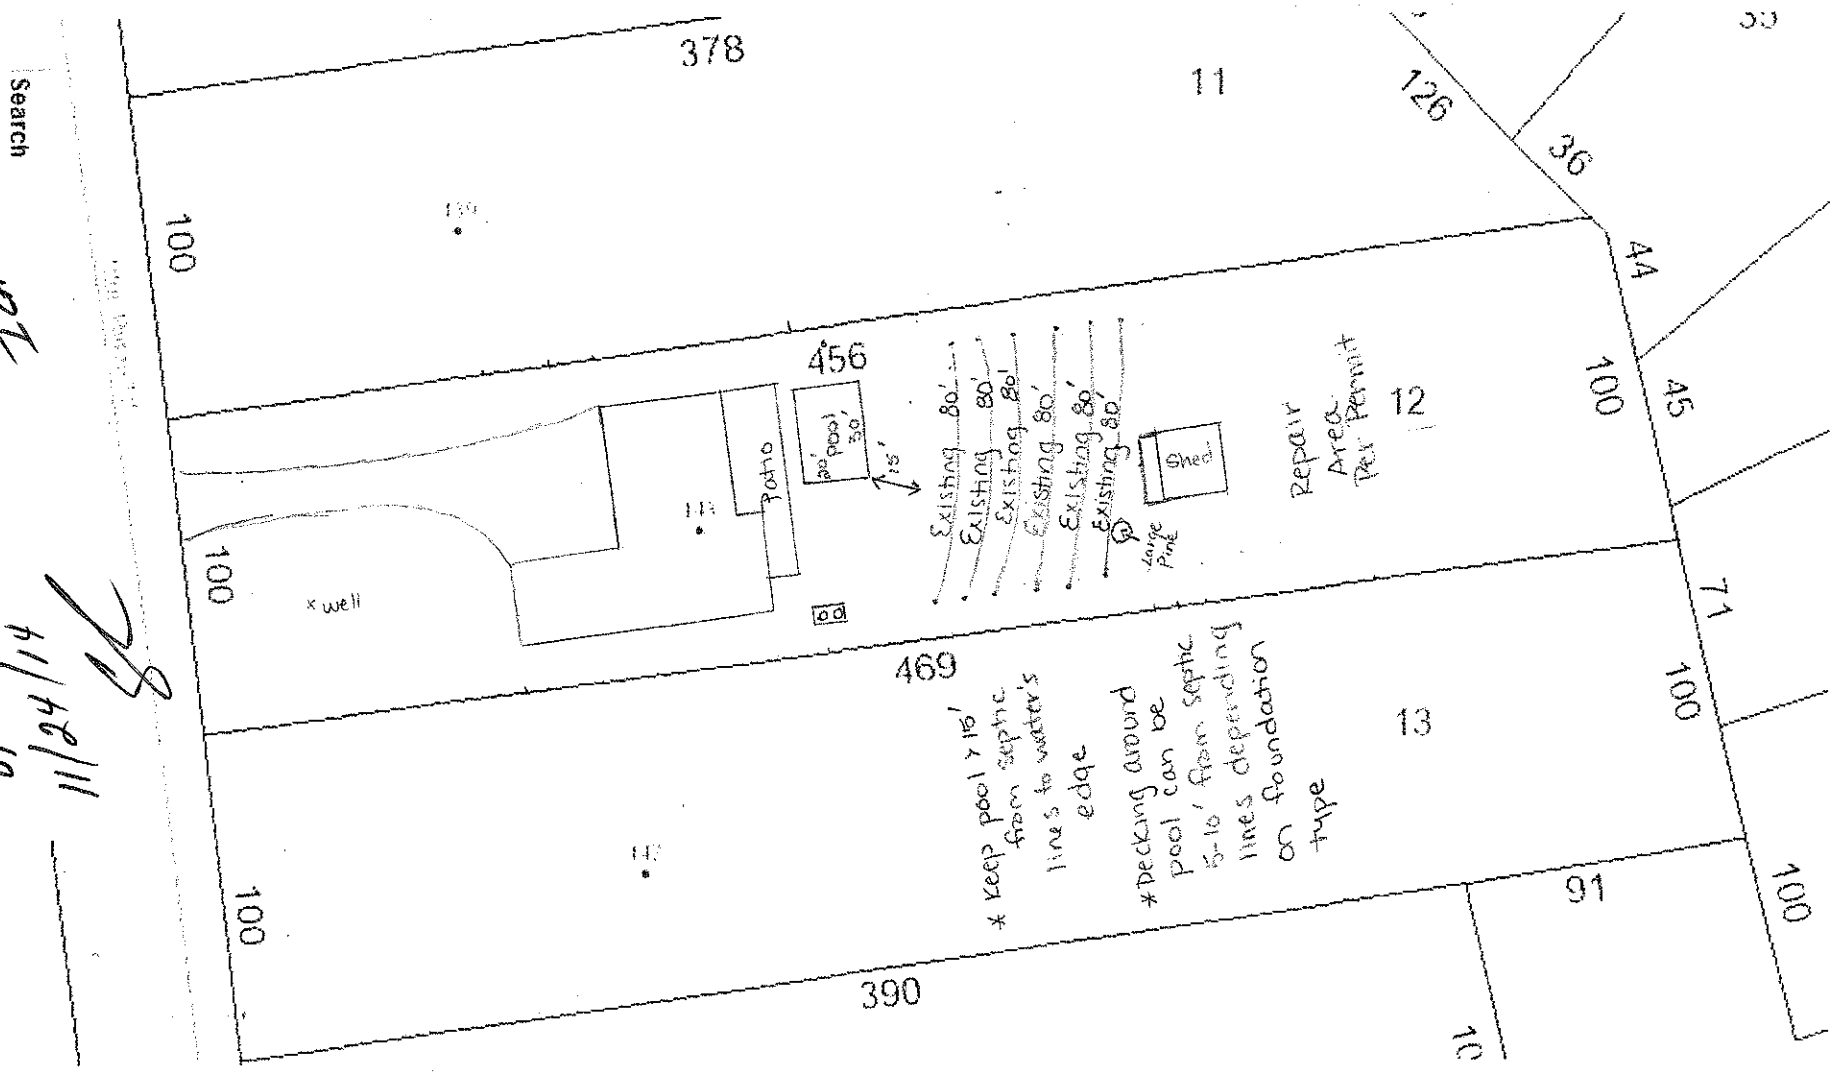

OK 11/24/14

Excel 2000/2003 **Results**

©2009-2014 Mobile311, LLC **Various icons by:** Silk Icons