IREDELL COUNTY HEALTH DEPARTMENT

Statesville Office (704) 878-5305 Mooresville Office (704) 660-3625 PERMIT # 136481

IMPROVEMENT PERMIT / AUTHORIZATION TO CONSTRUCT / OPERATION PERMIT / EXISTING SYSTEM

PIN # 4639320

APPLICANT: Titan Custom Builders APPLICANT ADDRESS: P.O. Box 3126 Mooresville, NC 28117

SITE ADDRESS: Blue Ridge Trail Mooresville, NC PHONE: 704 201 6705 ALT. PHONE:

SITE DIRECTIONS: Hwy 150 W TR Rorth Rd TL Fernhill TL Blue Ridge Trail 12th lot on left

SUBDIVISION: Woodleaf SECTION: LOT # 13 LOT AREA: 1.08Ac DESIGN FLOW: 600gpd L.T.A.R.: .25

Septic Tank 1500 (gal)	STB 1014?	Date 3-20-14	☒ New System ☐ Repair ☐ Expansion	System Type: I II III IV V VI	☒ Residence	No. Bedrooms 5	Water Supply
Pump Tank (gal)	PT	Date	System Description: Gravity 25% Reduction		☐ Business	No. Persons 10	☒ Private
Pump Make	Model	Serial #	Repair System Description: LPP PBPS		☐ Other	No. Employees	☐ Public
# Nitrification Fields 1	# Lines 6	Linear Ft: 600	Maintenance Agreement Required: ☐ YES ☒ NO		☐ Slab	☒ Crawl Space	☐ Community
Trench Width 36	Max. Trench Bottom Depth 36"	Gravel Depth N/A	☒ GRAVITY ☐ PRESSURE		☐ Basement w/ plumbing	☐ Basement w/o plumbing	

Comments / Conditions: This replaces previous permit dated 8-4-06.

* Septic installer needs to mark Supply Line or Ett can document for Future pool

* Must keep Pool "cut" at least 15ft from Stand Drainfield & at least 10ft from Supply line

INITIAL SITE SKETCH

Scale 1:50

ICHD-Environmental Health Division


The proposed / existing 14'X24' Detached Garage addition does not appear to impact the existing septic system.

**NOTE: Must Stay at least 5Ft from Septic

Maria Dotson R.S.

Date: 8/18/14

ICHD-Environmental Health Division

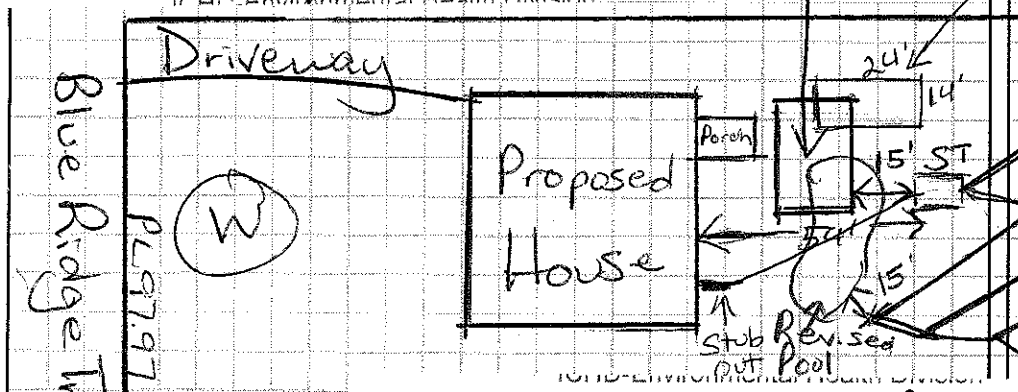


AS BUILT SKETCH

Use Infiltrator Quick 4

Installed essentially as drawn

Detached Garage

PL 469.24

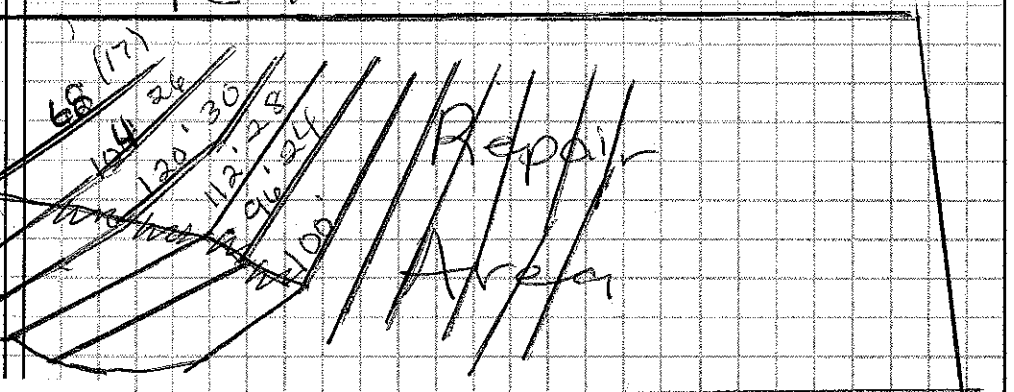

ICHD-Environmental Health Division

The proposed / existing Inground Pool addition does not appear to impact the existing septic system.

**NOTE: *Must Keep Pool cut at least 15ft from Septic System

Maria Dotson R.S.

Date: 8-18-14

ICHD-Environmental Health Division

Permit can be suspended or revoked if any false ... unauthorized changes are made in the installation of the system. CONTACT A LOCATOR SERVICE PRIOR TO ANY EXCAVATION

☐ IMPROVEMENT PERMIT *with plat* valid without expiration. ☐ IMPROVEMENT PERMIT *with site plan* valid for 60 mos. ☐ AUTHORIZATION TO CONSTRUCT valid for period equal to IMPROVEMENT PERMIT--not to exceed 60 mo.

Owner / Applicant Signature: Date: 5/22/2014 Installed by: Rowan Septic

IMPROVEMENT PERMIT by: Maria Dotson R.S. Date: 5/9/14 OPERATION PERMIT by: Maria Dotson R.S. Date: 6/18/14

AUTHORIZATION TO CONSTRUCT by: Maria Dotson Date: 5/9/14 Existing System Inspected by: Date:

Health Dept. Copy - WHITE Applicant (Final Approval) - YELLOW Applicant (Conditional Approval) - PINK