IREDELL COUNTY HEALTH DEPARTMENT

STATESVILLE 704-878-5305 MOORESVILLE 704-664-5281

IMPROVEMENT PERMIT / AUTHORIZATION TO CONSTRUCT / OPERATION PERMIT / EXISTING SYSTEM INSPECTION

PERMIT# 119056 PIN# 4639 23 5078.002 DATE 3/7/05

OWNER OR CONTRACTOR Craig Price PHONE: Business 336-658-4321 Home

ADDRESS 175 Carriage Club Dr. 8-207 Mooresville, NC 28117

LOCATION Perth Rd. N on Frost Hill Rd. TR Frost Cliff, 2nd lot on R

SUBDIVISION Beacon Point BLOCK / SECTION 4 LOT 2 LOT AREA 1.551 SITE CLASS. PS DESIGN FLOW 480 L.T.A.R. .25

Septic Tank: 1000 Gallons; STB Date

Pump Tank: — Gallons; PT Date

Pump Make: Model Serial No.

Nitrification Field: No Fields 1 Square Feet 1440 Linear Feet 480

No Lines 4@120 Trench Width 3' Max Trench Bottom Depth 30"± Gravel Depth NA

☒ New System ☐ Repair System Type: I, II, III, IV, V, VI

System Description: GRAVITY - 25% Reduced

Repair System Description: 16" PPBPS

Maintenance Agreement Required: ☐ Yes ☒ No

☒ House/Mod. Home No. Bedrooms 4

☐ Mobile Home No. Bathrooms 4

☐ Business No. Employees

☐ Other


☐ Slab ☐ Crawl Space ☒ Basement w/plumbing ☐ Basement wo/plumbing

Water Supply: ☒ Individual ☐ Public ☐ Community


Comments:/Conditions:

Comments:/Conditions:

INITIAL SITE SKETCH

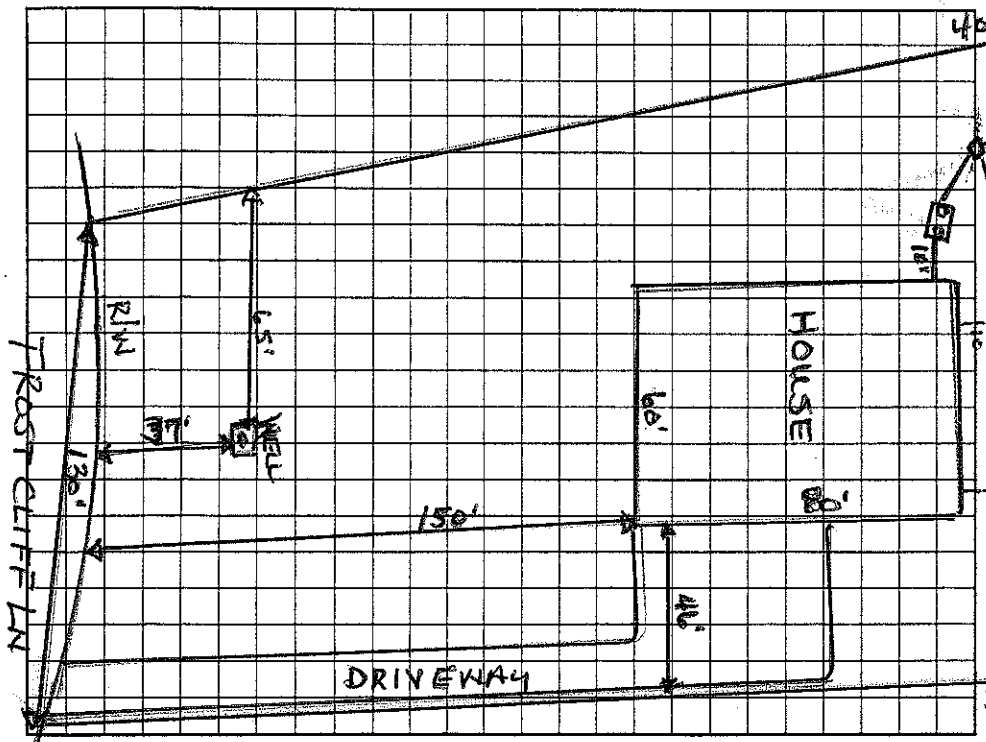

AS BUILT SKETCH

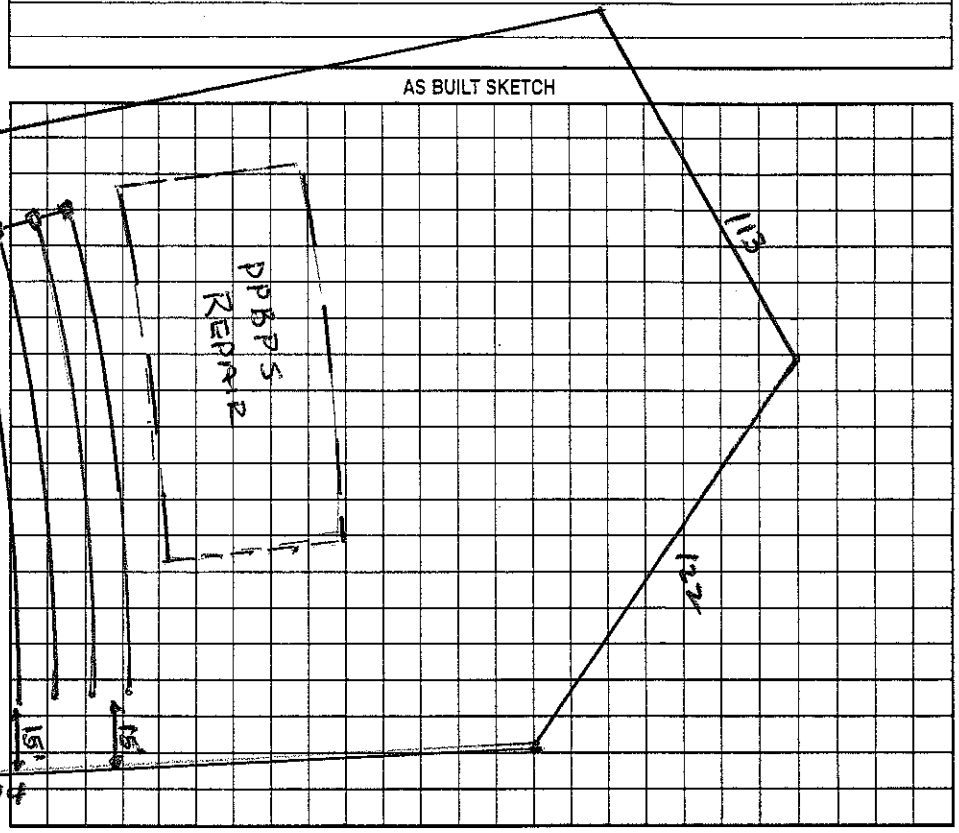

Permit can be suspended or revoked if any false information is supplied toward securing the permit/any unauthorized changes are made to the site/any unauthorized changes are made in the installation of the system. Improvement Permit with plat valid without expiration. Improvement Permit with site plan valid for sixty months. Authorization to Construct is valid for a period equal to that of Improvement Permit – not to exceed sixty months.

Signed: * Mailed copy to above address date

Improvement Permit by: Wally Sparks R.S. date 3/8/05

Authorization to Construct by: Wally Sparks R.S. date 3/8/05

Installed by:

Operation Permit by: date

Existing System Inspection by: date

HEALTH DEPT. COPY: WHITE OWNER COPY (FINAL): YELLOW OWNER COPY (INITIAL): PINK