# IREDELL COUNTY HEALTH DEPARTMENT

STATESVILLE 704-878-5305 MOORESVILLE 704-664-5281

## IMPROVEMENT PERMIT / AUTHORIZATION TO CONSTRUCT / OPERATION PERMIT / EXISTING SYSTEM INSPECTION

PERMIT# 092422 PIN# ~~4639 73 4457 (pt)~~ 4639337783 DATE March 6, 01

OWNER OR CONTRACTOR Crescent Resources, Inc. / Lake Norman Builders PHONE: Business _____ Home _____

ADDRESS P.O. Box 1033 Charlotte N.C. 28201 / 107 Kenway Loop.

LOCATION Perth Rd. N. TL Ferni Hill Rd. TL Kenway Loop 2nd Lot on left

SUBDIVISION Wildwood Cove BLOCK / SECTION _____ LOT 35 LOT AREA 35,536 ft² SITE CLASS. PS DESIGN FLOW 460 gpd L.T.A.R. .3

Septic Tank: 1000 Gallons; STB 794 Date 11/19/02

Pump Tank: _____ Gallons; PT _____ Date _____

Pump Make: _____ Model _____ Serial No. _____

Nitrification Field: No Fields 1 Square Feet 1620 Linear Feet 540

No Lines 5 Trench Width 36" Max Trench Bottom Depth 36" Gravel Depth 12"

☑ New System ☐ Repair System Type: I, II, III, IV, V, VI

System Description: Gravity Conventional

Repair System Description: Conventional / Innovative

Maintenance Agreement Required: ☐ Yes ☑ No

☑ House/Mod. Home No. Bedrooms 4

☐ Mobile Home No. Bathrooms 4

☐ Business No. Employees _____

☐ Other _____


☐ Slab ☑ Crawl Space ☐ Basement w/plumbing ☐ Basement wo/plumbing

Water Supply: ☑ Individual ☐ Public ☐ Community


Comments:/Conditions: 9/20/02 Revised Plan + it essentially complies with IP requirements. Aws

Comments:/Conditions:

INITIAL SITE SKETCH 1"=50'

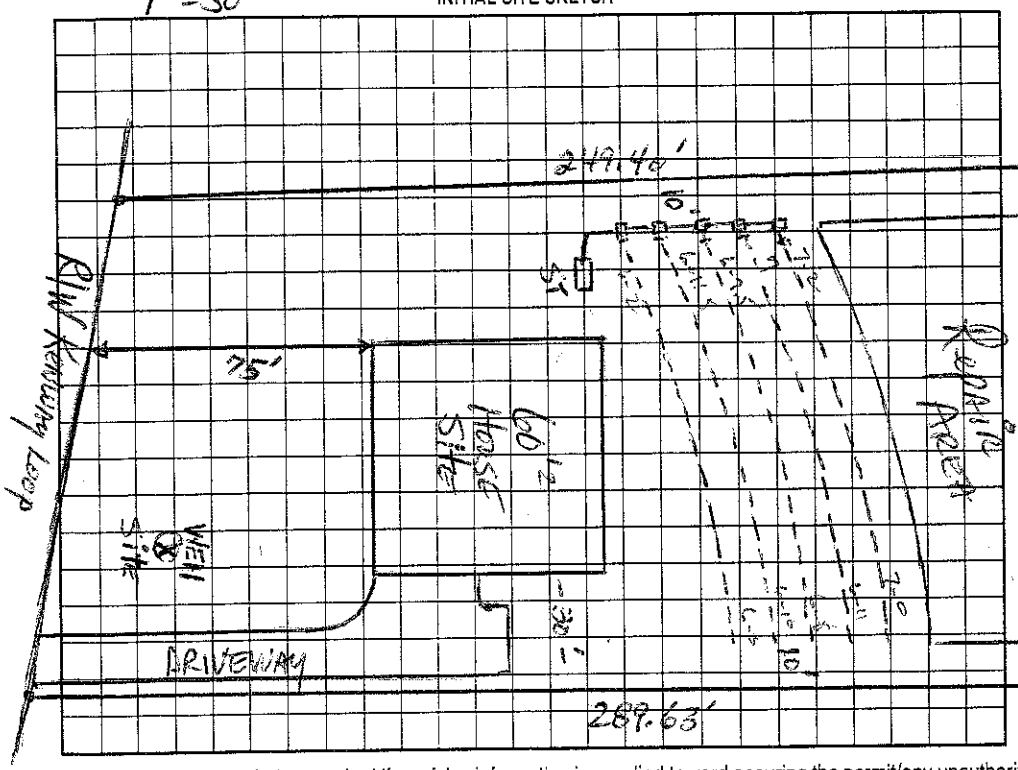


AS BUILT SKETCH

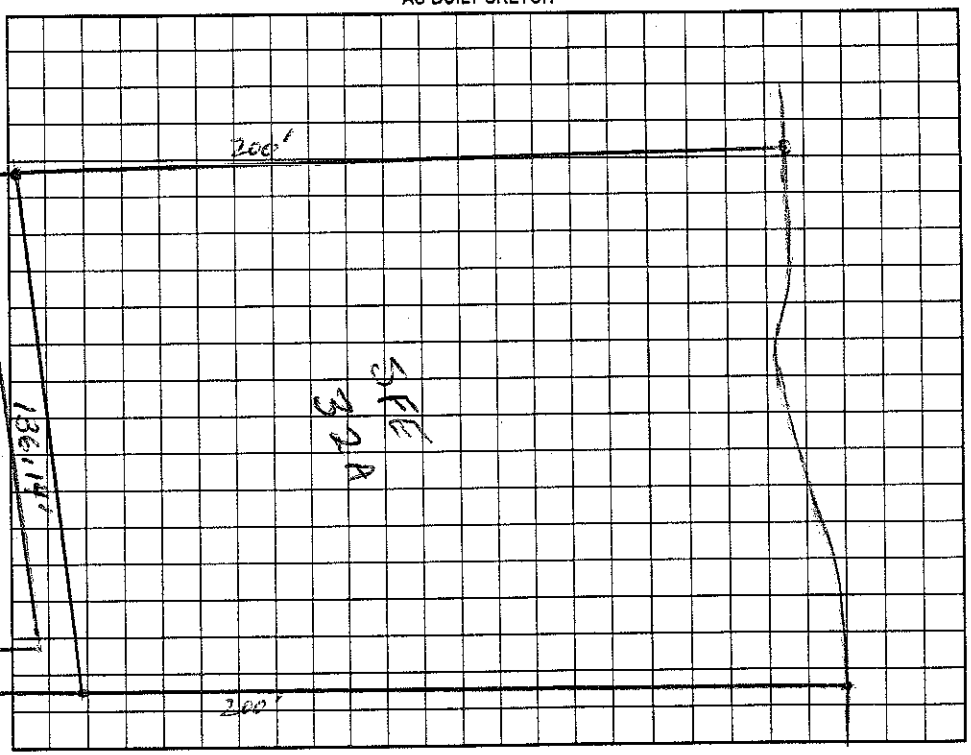


Permit can be suspended or revoked if any false information is supplied toward securing the permit/any unauthorized changes are made to the site/any unauthorized changes are made in the installation of the system. Improvement Permit with plat valid without expiration. Improvement Permit with site plan valid for sixty months. Authorization to Construct is valid for a period equal to that of Improvement Permit – not to exceed sixty months.

Signed: _____ date 3-21-01 Installed by: Dave Clark

Improvement Permit by: _____ date 3-6-01 Operation Permit by: Wesley Sparks RS date 3/13/03

Authorization to Construct by: Wesley Sparks RS date 9/20/02 Existing System Inspection by: _____ date _____

WHITE COPY - CUSTOMER COPY (FINAL); YELLOW _____ OWNER COPY (FINAL); PINK _____ OWNER COPY (INITIAL); PINK