# IREDELL COUNTY HEALTH DEPARTMENT

Statesville Office (704) 878-5305 Mooresville Office (704) 660-3625 PERMIT # 209550

## IMPROVEMENT PERMIT / AUTHORIZATION TO CONSTRUCT / OPERATION PERMIT / EXISTING SYSTEM

PIN # 4639-33-7995

APPLICANT: DERIK BALTICH APPLICANT ADDRESS: 127 GREYCLIFF DR.

SITE ADDRESS: 103 KENWAY LOOP PHONE: 704-578-4951 ALT. PHONE:

SITE DIRECTIONS: FERN HILL, TL KENWAY, CORNER W/ KENWAY & FERN HILL

SUBDIVISION: WILDWOOD COVE SECTION: LOT # 34 LOT AREA: 1.942 AC DESIGN FLOW: 600 L.T.A.R.: .25 (.3R)

| | | | | | | | | | |
|---|---|---|---|---|---|---|---|---|---|
| Septic Tank | 1500 (gal) | STB | 190 | Date | 9-15-15 | ☒ New System ☐ Repair ☐ Expansion | System Type: I II (III) IV V VI | ☒ Residence | No. Bedrooms 5 |
| Pump Tank | (gal) | PT | | Date | | System Description: | 25% REDUCTION | ☐ Business | No. Persons |
| Pump Make | | Model | | Serial # | | Repair System Description: | PANEL BLOCK | ☐ Other | No. Employees |
| # Nitrification Fields | 1 | # Lines | 6 | Linear Ft: | 600' | Maintenance Agreement Required: | ☐ YES ☒ NO | ☐ Slab | ☒ Crawl Space |
| Trench Width | 36" | Max. Trench Bottom Depth | * 32" * | Gravel Depth | — | | ☒ GRAVITY ☐ PRESSURE | ☐ Basement w/plumbing | ☐ Basement w/o plumbing |

Water Supply: ☒ Private ☐ Public ☐ Community

Comments / Conditions:

12/7/15 OK to feed at end caps & not use separate drop boxes

INITIAL SITE SKETCH

SEE PLAN FROM KATHLEEN SAUNDERS

AS BUILT SKETCH

*Permit can be suspended or revoked if any false information is supplied toward securing the permit / any unauthorized changes are made to the site / any unauthorized changes are made in the installation of the system.* **CONTACT A LOCATOR SERVICE PRIOR TO ANY EXCAVATION**

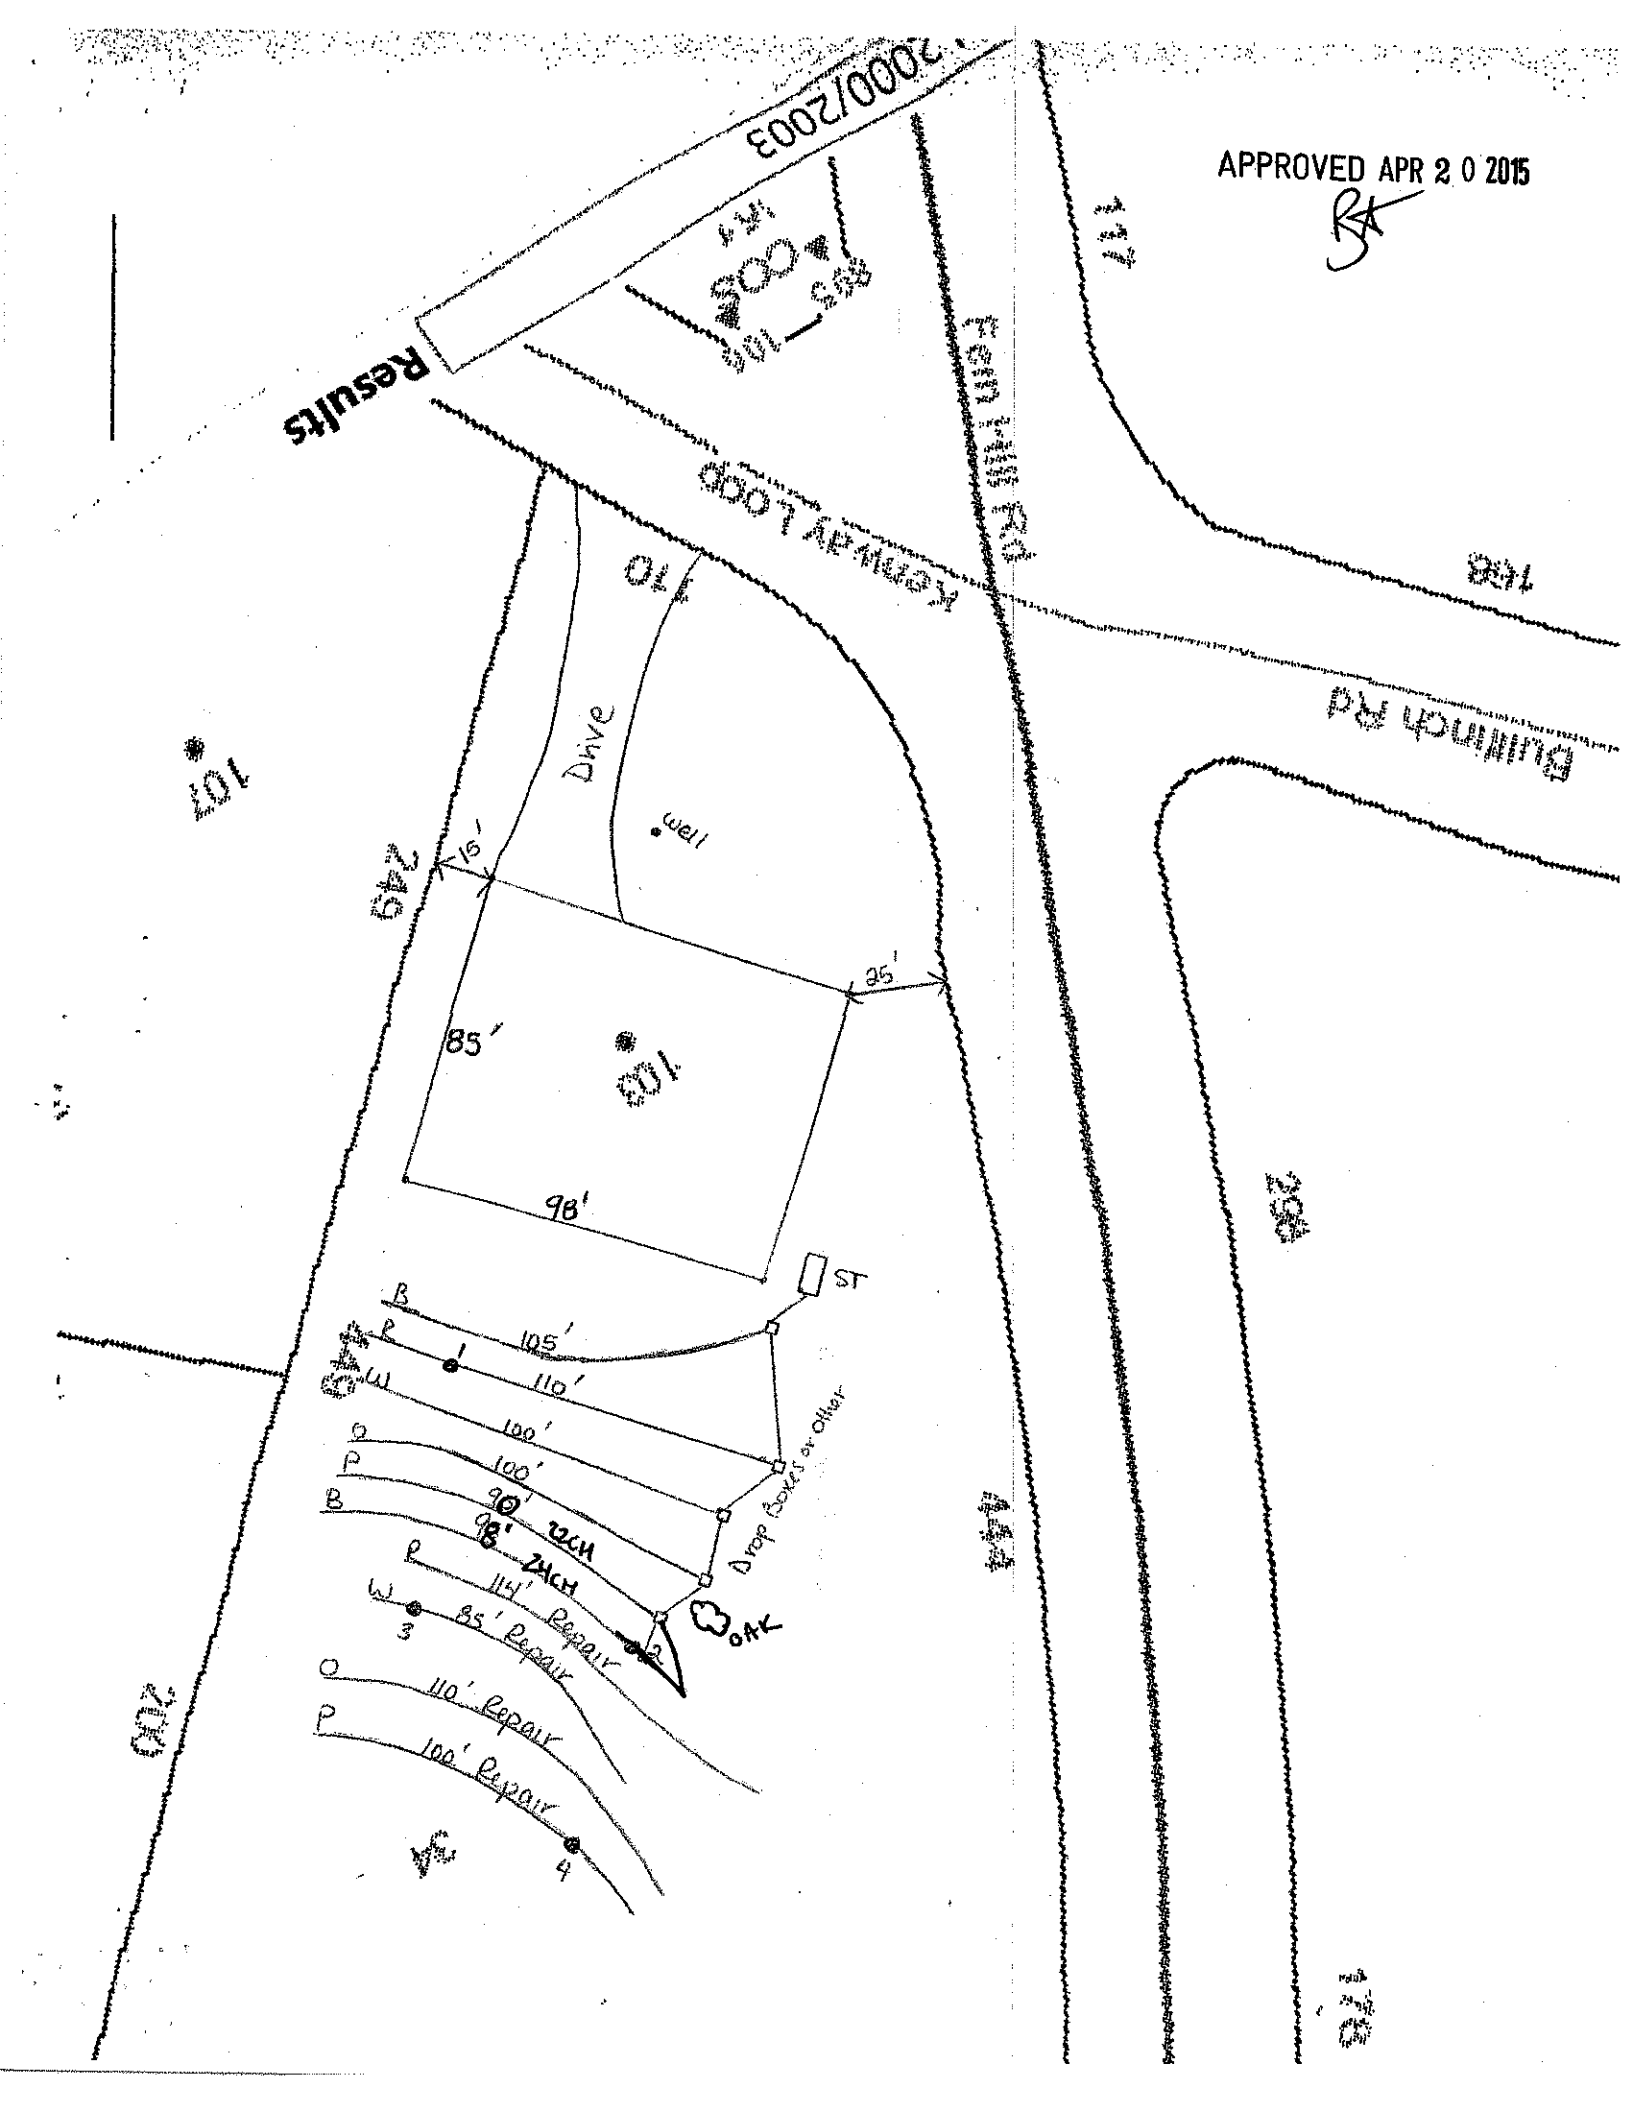
☐ **IMPROVEMENT PERMIT** *with plat valid without expiration.* ☐ **IMPROVEMENT PERMIT** *with site plan valid for 60 mos.* ☒ **AUTHORIZATION TO CONSTRUCT** *valid for period equal to IMPROVEMENT PERMIT--not to exceed 60 mo.*

Owner / Applicant Signature: Kathleen Saunders Date: 4-23-15 Installed by: K & M GRADING

IMPROVEMENT PERMIT by: APPROVED Date: APR 20 2015 OPERATION PERMIT by: APPROVED DEC 09 2015 Date:

AUTHORIZATION TO CONSTRUCT by: APPROVED Date: APR 20 2015 Existing System Inspected by: Date:

Health Dept. Copy - WHITE Applicant (Final Approval) - YELLOW Applicant (Conditional Approval) - PINK


APPROVED APR 2 0 2015
Results
2000/2003
Drive
well
15'
35'
85'
98'
ST
B
105'
110'
100'
100'
90'
98' 24CH
114' Repair
85' Repair
110' Repair
100' Repair
Drop Boxes or Other
OAK
Pleinmont Rd