IREDELL COUNTY HEALTH DEPARTMENT

STATESVILLE 704-878-5305 MOORESVILLE 704-664-5281

IMPROVEMENT PERMIT / AUTHORIZATION TO CONSTRUCT / OPERATION PERMIT / EXISTING SYSTEM INSPECTION

PERMIT# 136460 PIN# 4639422 0136.006 4639338045 DATE July 31, 2006

OWNER OR APPLICANT Woodbridge PARTNERS / Precision PHONE: Business _____ Home _____

ADDRESS P.O. Box 3688 Mooresville N.C. 28117

LOCATION Perth Rd. (N) TL FERNHILL TL Blue Ridge Trail 5th lot on left

SUBDIVISION Woodleaf BLOCK / SECTION _____ LOT 6 LOT AREA 1.66 ac SITE CLASS. PSI DESIGN FLOW 480gpd L.T.A.R. e3

Septic Tank: 1000 Gallons; STB 1000 Date 6-22-07
Pump Tank: 1000 Gallons; PT 294 Date 5-17-07
Pump Make: Goulds Model 1/2HP Serial No. _____
Nitrification Field: No Fields 1 Square Feet 1200 Linear Feet 400
No Lines 4 Trench Width 36" Max Trench Bottom Depth 36"

☒ New System ☐ Repair ☐ Expansion System Type: I II III IV V VI
System Description: OM 25% Reduction
Repair System Description: LPP&RS
Maintenance Agreement Required: ☐ Yes ☒ No initially

☒ House/Mod. Home No. Bedrooms 4
☐ Mobile Home No. Persons ____
☐ Business No. Employees ____
☐ Other _____

Water Supply: ☒ Individual ☐ Public ☐ Community

Gravel Depth N/A ☐ Gravity ☒ Pressure ☐ Slab ☒ Crawl Space ☐ Basement w/plumbing ☐ Basement wo/plumbing

Comments/Conditions:

Comments/Conditions: 8/20/07 Checked tanks & lines
10/11/07 C&S did pressure, elect & alarm

INITIAL SITE SKETCH

SEE PLAN from S&ME


AS BUILT SKETCH

Permit can be suspended or revoked if any false information is supplied toward securing the permit/any unauthorized changes are made to the site/any unauthorized changes are made in the installation of the system. Improvement Permit with plat valid without expiration ☐ Improvement Permit with site plan valid for sixty months ☒ Authorization to Construct is valid for a period equal to that of Improvement Permit – not to exceed sixty months

Signed: Kathleen Saunders date 8/11/06
Improvement Permit by: _____ date 7-31-06
Authorization to Construct by: _____ date 3/9/07

Installed by: Brad Johnson C&S
Operation Permit by: _____ date 10/11/07
Existing System Inspection by: _____ date _____

HEALTH DEPT. COPY: WHITE OWNER COPY (FINAL): YELLOW OWNER COPY (INITIAL): PINK

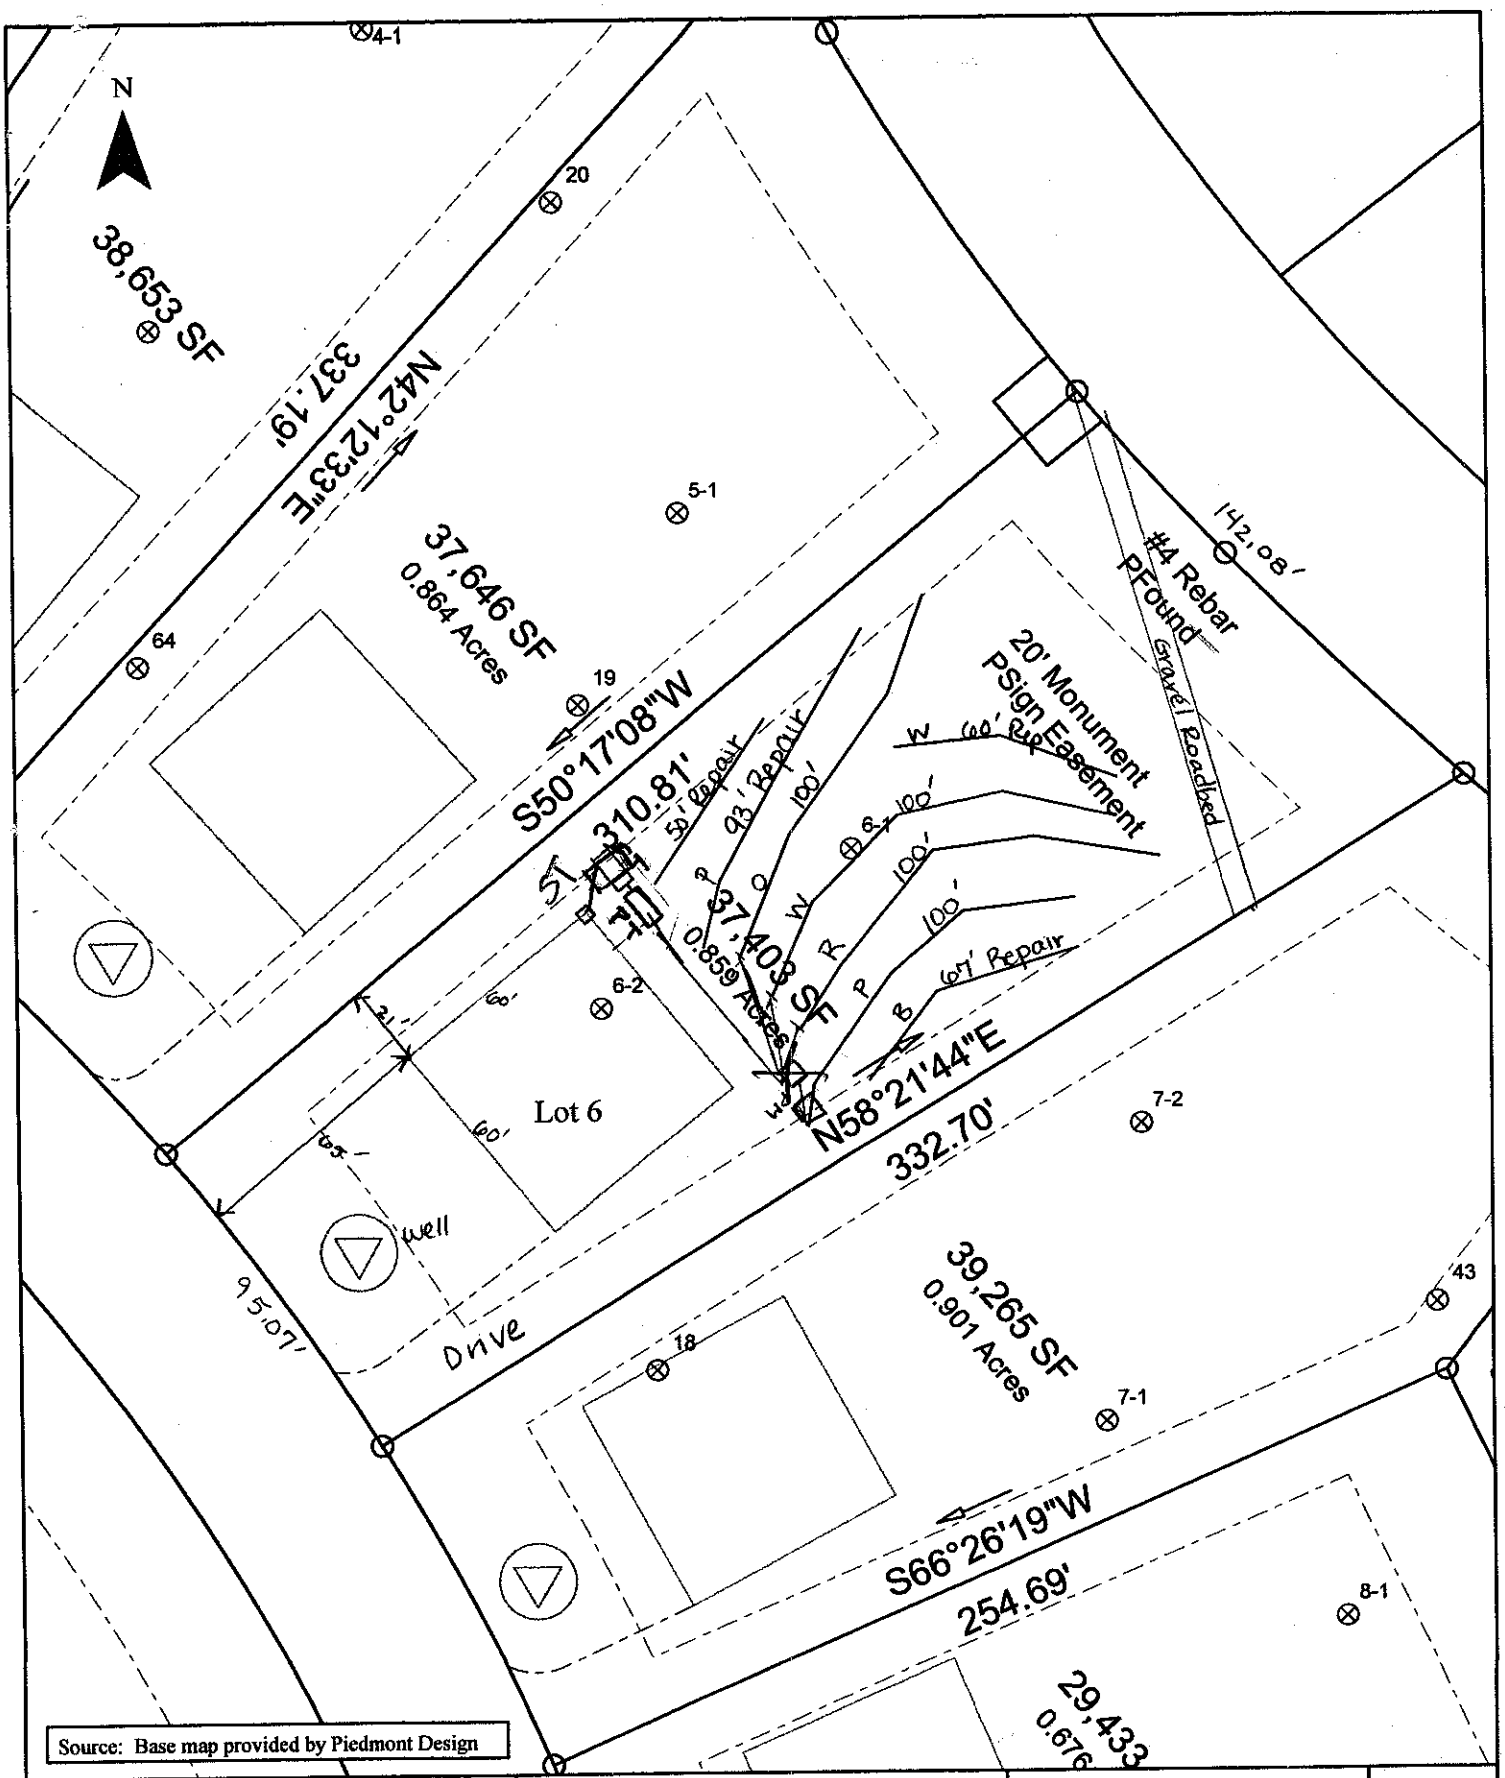

Source: Base map provided by Piedmont Design

Scale: 1 inch equals 50 feet	S&ME	Woodleaf Subdivision	FIGURE
Drawn by: JBP		Lot 6 Septic Lines	1
Reviewed by: PGP		Iredell County, NC	
Date: July, 2006	ENVIRONMENTAL SERVICES • ENGINEERING • TESTING	S&ME Project #1588-05-121	