IREDELL COUNTY HEALTH DEPARTMENT

As Built

STATESVILLE 704-878-5305 MOORESVILLE 704-664-5281

IMPROVEMENT PERMIT / AUTHORIZATION TO CONSTRUCT / OPERATION PERMIT / EXISTING SYSTEM INSPECTION

PERMIT # ~~[illegible]~~ 14726 | PIN # ~~4639345868.000~~ 4639345845 | DATE 11/4/08

OWNER or APPLICANT Corinthian Builders Ltd. | PHONE: Business 704 400-1258 | Home:

OWNER or APPLICANT ADDRESS P.O. Box 990 Denver NC 28037

LOCATION / DIRECTIONS North Rd. (N) to Fern Hill Dr Marietta Rd.

SUBDIVISION Marietta Ridge | BLOCK / SECTION | LOT # 2 | LOT AREA .862 | DESIGN FLOW 480 | L.T.A.R. .3

Septic Tank 1800 Gallons: STB 786 Date 6-08

Pump Tank 1800 Gallons: PT 37 Date 5-23-08

Pump Make Quid ½ HP Model WE05111H Serial # 1PWE0511

Nitrification Field No Fields 1 No Lines 4 Linear Feet 280

Trench Width 24 Max. Trench Bottom Depth 31 Gravel Depth N/A

☑ New System ☐ Repair ☐ Expansion System Type I II III (IV) V VI

System Description: LP pipes

Repair System Description: Same

Maintenance Agreement Required ☑ YES ☐ NO

☐ GRAVITY ☐ PRESSURE

☑ Residence No. Bedrooms 4

☐ Business No. Persons

☐ Other No. Employees

☐ Slab ☑ Crawl Space


☐ Basement w/plumbing ☐ Basement w/o plumbing

Water Supply: ☑ Private ☐ Public ☐ Community


Comments / Conditions

Comments / Conditions

INITIAL SITE SKETCH

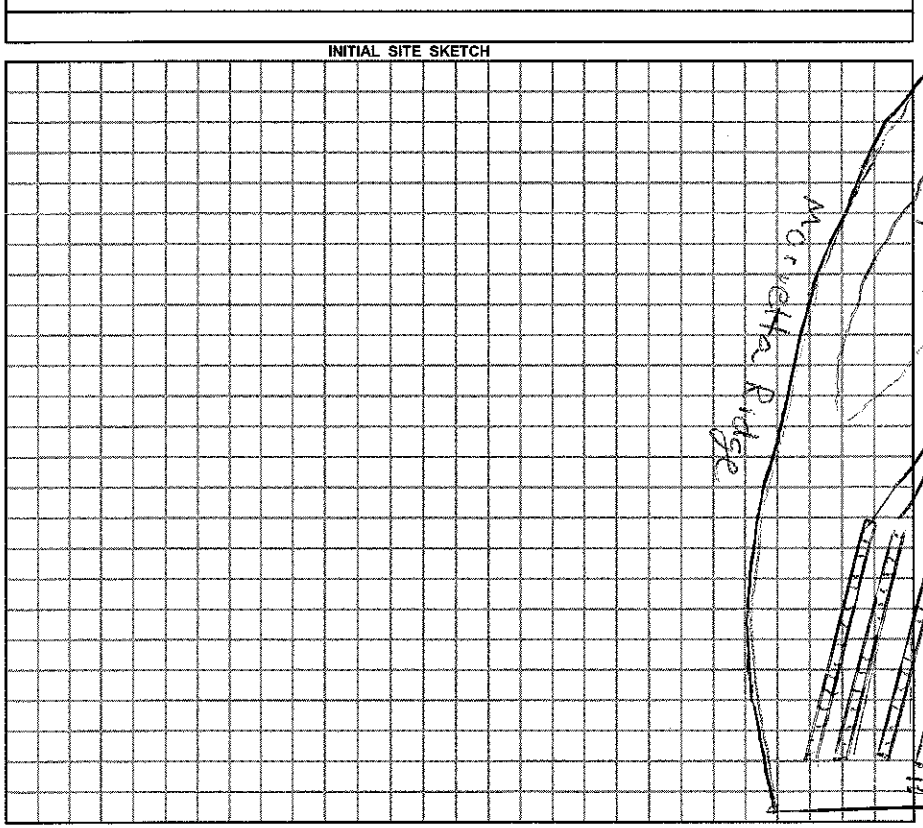

AS BUILT SKETCH

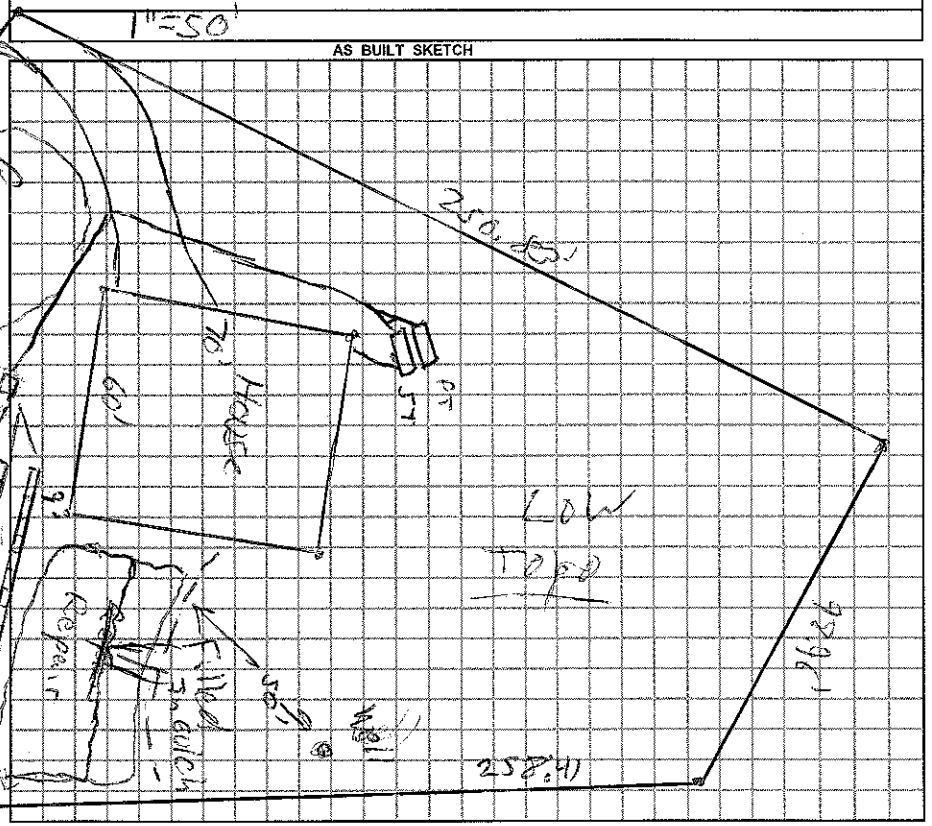

Permit can be suspended or revoked if any false information is supplied toward securing the permit / any unauthorized changes are made to the site / any unauthorized changes are made in the installation of the system.

☐ *IMPROVEMENT PERMIT w / plat valid without expiration.* ☐ *IMPROVEMENT PERMIT w / site plan valid for 60 mos.* ☑ *AUTHORIZATION TO CONSTRUCT valid for period equal to IMPROVEMENT PERMIT-not to exceed 60 mo.*

Owner / Applicant Signature: _____ Date _____

Improvement Permit by: _____ Date _____

Authorization to Construct by: _____ Date _____

Installed by: _____

Operation Permit by: Anthony Coker L.R.S. Date: 11/4/08

Existing System Inspected by: _____ Date: _____

YOU SHOULD CONTACT A LOCATOR SERVICE PRIOR TO ANY EXCAVATION.

WHITE COPY Environmental Health YELLOW COPY (Final) Owner / Applicant PINK COPY (Initial) Owner / Applicant