Limited . . A[illegible] owes 90.00

IREDELL COUNTY HEALTH DEPARTMENT

STATESVILLE 704-878-5305 MOORESVILLE 704-664-5281

IMPROVEMENT PERMIT / AUTHORIZATION TO CONSTRUCT / OPERATION PERMIT / EXISTING SYSTEM INSPECTION

PERMIT# 147261 PIN# 4639345808.002 DATE 8/7/08

OWNER OR APPLICANT Corinthian Builders Ltd. PHONE: Business 704 400-1258 Home

ADDRESS PO Box 990 Denver NC 28037

LOCATION Perth Rd (N) TL Fern Hill Rd. TR Mariette Rd.

SUBDIVISION Mariette Ridge BLOCK / SECTION ____ LOT 2 LOT AREA .862 SITE CLASS. PS DESIGN FLOW 480 L.T.A.R. .3

Septic Tank: 1000 Gallons: STB 786 Date 6-08
Pump Tank: 1000 Gallons: PT 33 Date 5-23-06
Pump Make: Goulds Model WE0511HH Serial No. 1PWE0511,
Nitrification Field: No Fields 1 Square Feet 560 Linear Feet 280
No Lines 4 Trench Width 24 Max Trench Bottom Depth 36" Gravel Depth N/A

☑ New System ☐ Repair ☐ Expansion System Type: I II III (IV) V VI
System Description: LP PPBPS
Repair System Description: same
Maintenance Agreement Required: ☑ Yes ☐ No
☐ Gravity ☑ Pressure ☐ Slab ☑ Crawl Space ☐ Basement w/plumbing ☐ Basement wo/plumbing


☑ House/Mod. Home No. Bedrooms 4
☐ Mobile Home No. Persons ____
☐ Business No. Employees ____
☐ Other ____

Water Supply: ☑ Individual ☐ Public ☐ Community

Comments:/Conditions: Supply line under driveway must be buried 30" deep min/or sleeved in ductile iron or equivalent

Comments:/Conditions: All field terraces uneven topo needs to be leveled in proposed drainfield area by blending high spots
Well must be min 100' from system & repair
min 50' from tanks

INITIAL SITE SKETCH

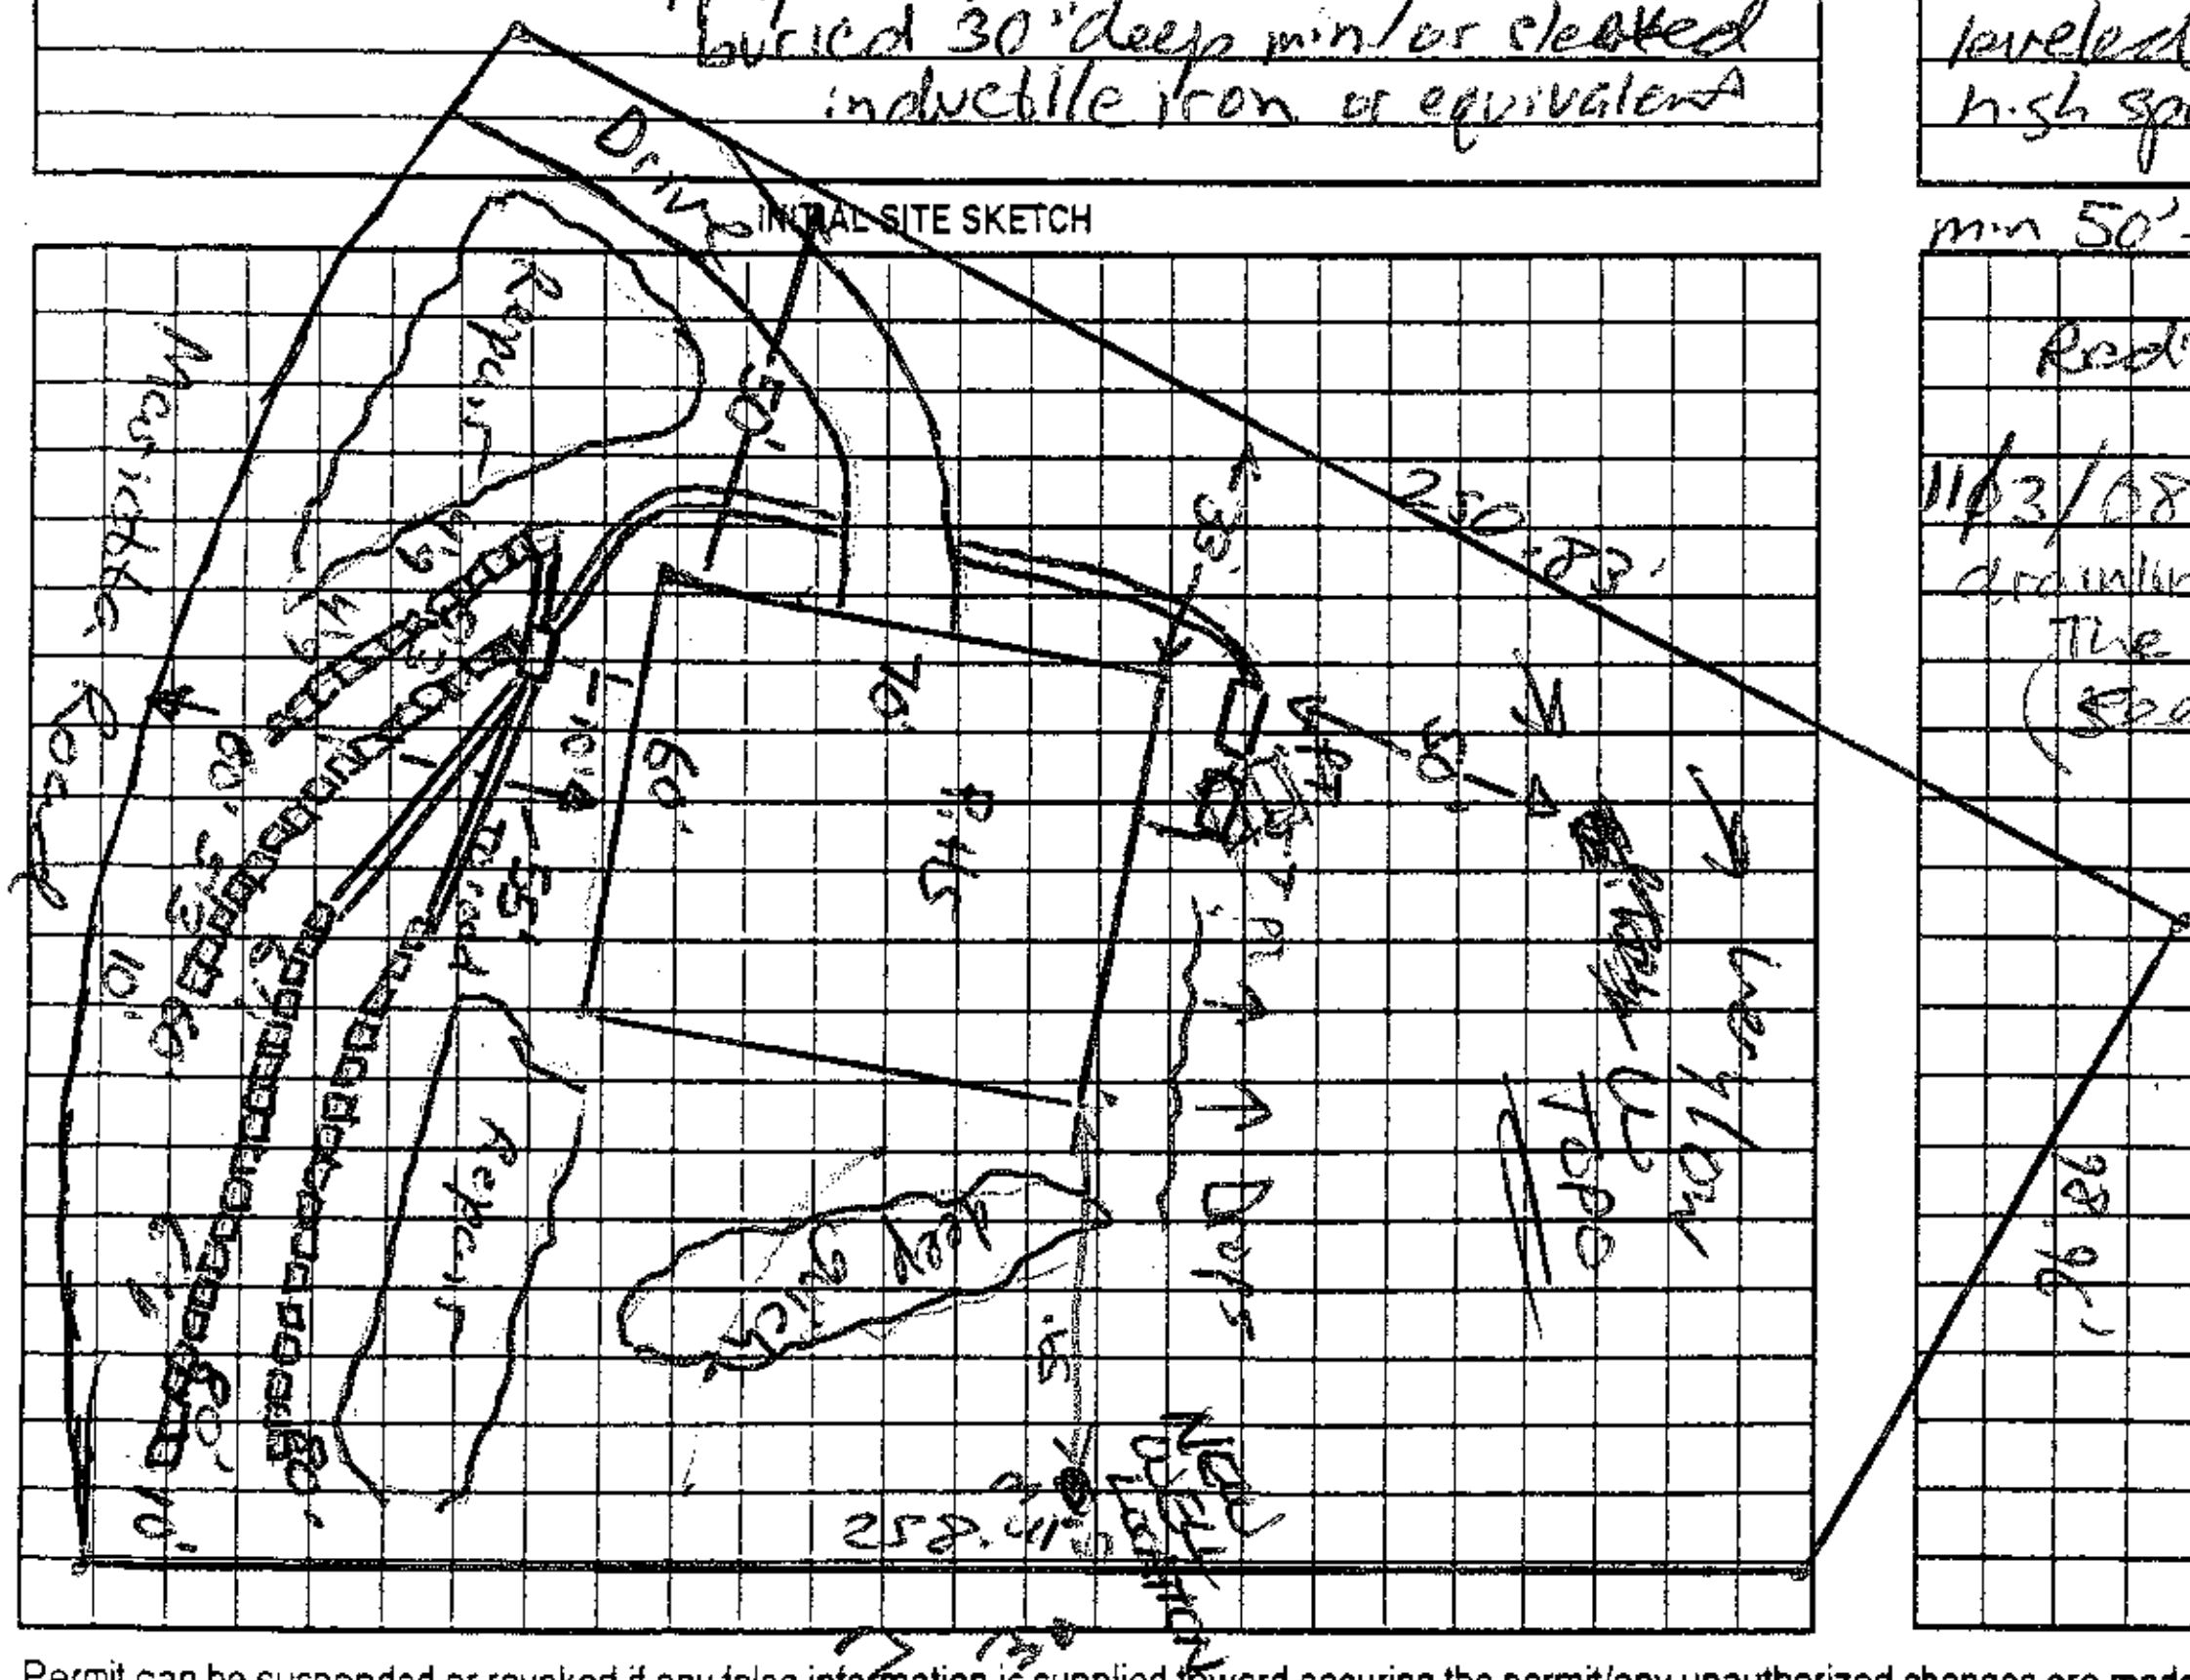

AS BUILT SKETCH

Redrawn for new house size 57'x 69'

11/03/08 OK to put well 50' min from Repair + 2 (80') drainlines based on pit #1 soil evaluation.
The 2 60' lines need to remain 100' min from well.
(See well permit)

Permit can be suspended or revoked if any false information is supplied toward securing the permit/any unauthorized changes are made to the site/any unauthorized changes are made in the installation of the system. Improvement Permit with plat valid without expiration ☐ Improvement Permit with site plan valid for sixty months ☐ Authorization to Construct is valid for a period equal to that of Improvement Permit – not to exceed sixty months.

Signed: [signature] date 8/13/08

Improvement Permit by: Anthony Coley Jr. RS. date 8/7/08

Authorization to Construct by: Anthony Coley Jr. RS. date 8/7/08

Installed by: Corinthian

Operation Permit by: See Asbuilt Anthony Coley Jr. RS date 11/7/08

Existing System Inspection by: ____ date ____

HEALTH DEPT. COPY: WHITE OWNER COPY (FINAL): YELLOW OWNER COPY (INITIAL): PINK