Redraw. Yes O

IREDELL COUNTY HEALTH DEPARTMENT

STATESVILLE 704-878-5305 MOORESVILLE 704-664-5281

IMPROVEMENT PERMIT / AUTHORIZATION TO CONSTRUCT / OPERATION PERMIT / EXISTING SYSTEM INSPECTION

PERMIT # 147260 PIN # ~~4639345808.000~~ 4639347606 DATE 10/30/08

OWNER or APPLICANT Corinthian Builders Ltd. PHONE: Business 704 400-1258 Home:

OWNER or APPLICANT ADDRESS PO Box 910 Denver NC 28037

LOCATION / DIRECTIONS Perth Rd. TR Fern Hill TR Marietta Rd on Right

SUBDIVISION Marietta Ridge BLOCK / SECTION LOT # 1 LOT AREA .865 DESIGN FLOW 480 L.T.A.R. .3

Septic Tank 1000 Gallons: STB 786 Date 5/12/08

Pump Tank 1000 Gallons: PT 32 Date 5/17/08

Pump Make Govlds Model WE0511HB Serial #

Nitrification Field No Fields 1 No Lines 5 Linear Feet 270'

Trench Width 24 Max. Trench Bottom Depth 36 Gravel Depth N/A

☑ New System ☐ Repair ☐ Expansion System Type I II III (IV) V VI

System Description: LP PPBPS

Repair System Description: same

Maintenance Agreement Required ☑ YES ☐ NO

☐ GRAVITY ☑ PRESSURE

☑ Residence No. Bedrooms 4

☐ Business No. Persons

☐ Other No. Employees

☐ Slab ☑ Crawl Space


☐ Basement w/plumbing ☐ Basement w/o plumbing

Water Supply: ☑ Private ☐ Public ☐ Community

Comments / Conditions 1"=50'

Comments / Conditions 10/14/08 Drainlines checked AC.
10/29/08 - Pressure Set checked by Merica Dotson + Electrical

INITIAL SITE SKETCH

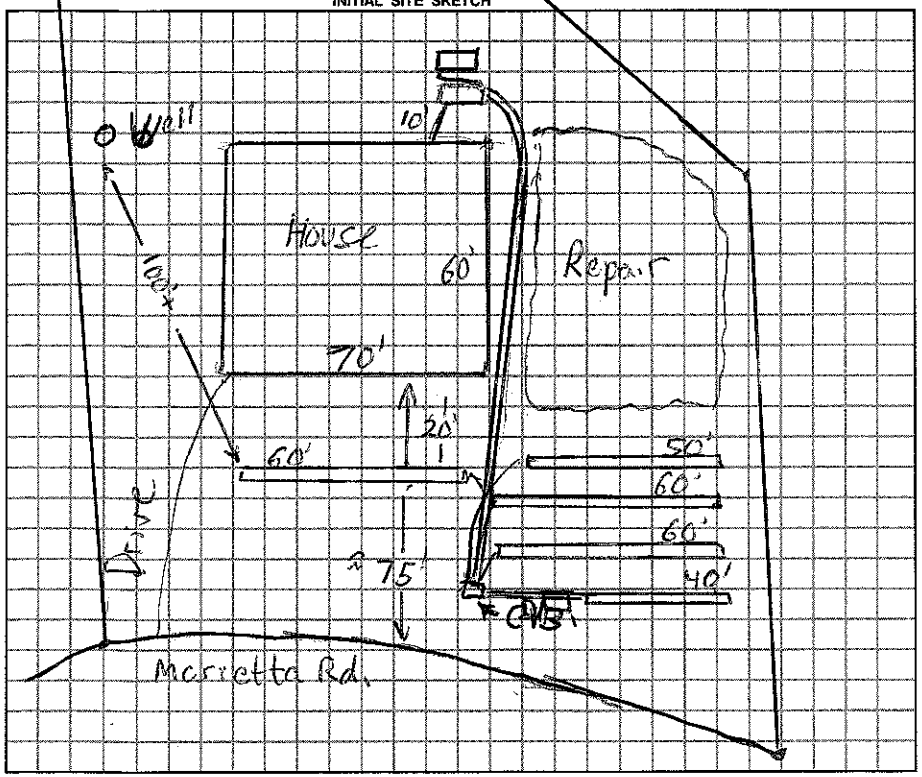

AS BUILT SKETCH

System Installed as shown
10/29/08

Permit can be suspended or revoked if any false information is supplied toward securing the permit / any unauthorized changes are made to the site / any unauthorized changes are made in the installation of the system.

☐ *IMPROVEMENT PERMIT w / plat valid without expiration.* ☑ *IMPROVEMENT PERMIT w / site plan valid for 60 mos.* ☐ *AUTHORIZATION TO CONSTRUCT valid for period equal to IMPROVEMENT PERMIT-not to exceed 60 mo.*

Owner / Applicant Signature: Date 10-30-08

Improvement Permit by: Anthony Coker Jr. R.S. Date 10/30/08

Authorization to Construct by: Anthony Coker Jr R.S Date 10/30/08

YOU SHOULD CONTACT A LOCATOR SERVICE PRIOR TO ANY EXCAVATION.

Installed by: Corinthian

Operation Permit by: Anthony Coker Jr. R.S. Date: 10/30/08

Existing System Inspected by: Date:

WHITE COPY Environmental Health YELLOW COPY (Final) Owner / Applicant PINK COPY (Initial) Owner / Applicant