IREDELL COUNTY HEALTH DEPARTMENT

IMPROVEMENT PERMIT / AUTHORIZATION TO CONSTRUCT / OPERATION PERMIT / EXISTING SYSTEM INSPECTION

720.00

STATESVILLE 704-878-5305 MOORESVILLE 704-664-5281

PERMIT# 131192 PIN# ~~4634 75 0254.003~~ 4639349714.000

OWNER OR APPLICANT Regent Blvd. PHONE: Business 872-5458 Home

ADDRESS PO Box 5142 Concord NC 28027 DATE 10/6/06

LOCATION Perth Rd TL Fora Hill, TR Nantical Pt., on Lt

SUBDIVISION Nantical Pt BLOCK / SECTION LOT 2 LOT AREA 1.41Ac SITE CLASS. PS DESIGN FLOW 480 L.T.A.R. 0.3

Septic Tank: 1000 Gallons; STB 1012 Date

Pump Tank: 1000 Gallons; PT 273 Date

Pump Make: Model Serial No.

Nitrification Field: No Fields Square Feet 1200 Linear Feet 400

No Lines 5@80' Trench Width 36" Max Trench Bottom Depth 36"

☒ New System ☐ Repair ☐ Expansion System Type: I II III IV V VI

System Description: 25% Reduction

Repair System Description: LP Panel Block

Maintenance Agreement Required: ☐ Yes ☒ No

Gravel Depth — ☐ Gravity ☒ Pressure

☒ House/Mod. Home ☐ Mobile Home ☐ Business ☐ Other

No. Bedrooms No. Persons No. Employees


Water Supply: ☒ Individual ☐ Public ☐ Community

☐ Slab ☒ Crawl Space ☐ Basement w/plumbing ☐ Basement wo/plumbing


Comments:/Conditions: May be installed in 6 lines 6' eq)

Comments:/Conditions:

Scale 1:60 INITIAL SITE SKETCH

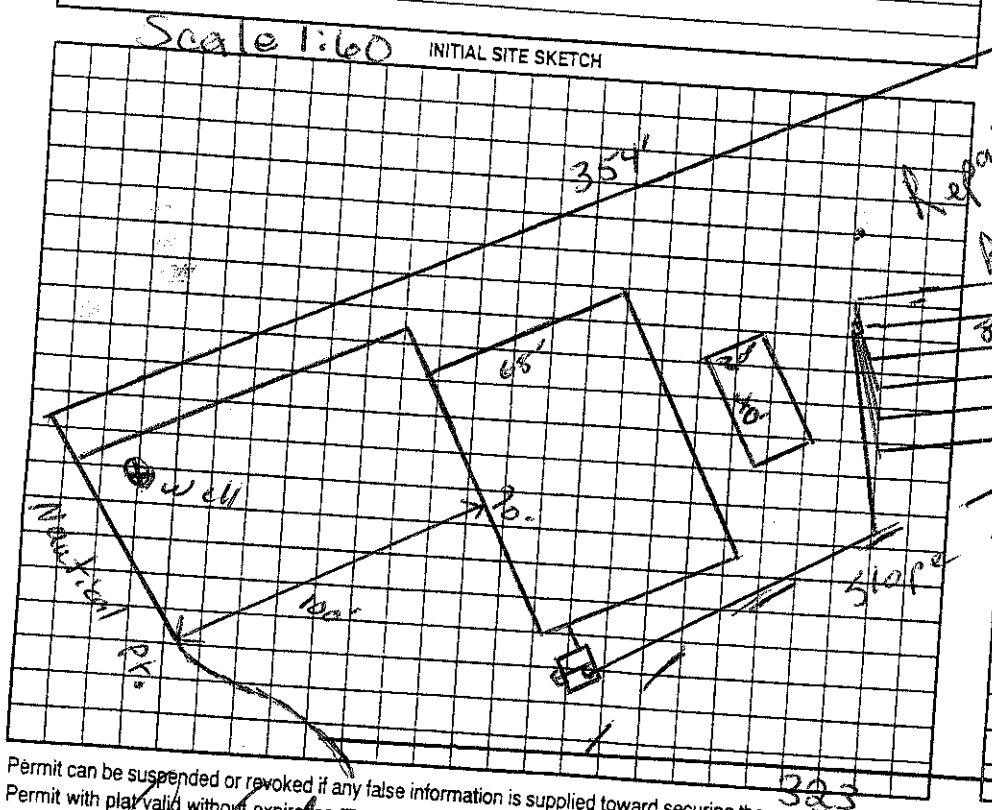

AS BUILT SKETCH

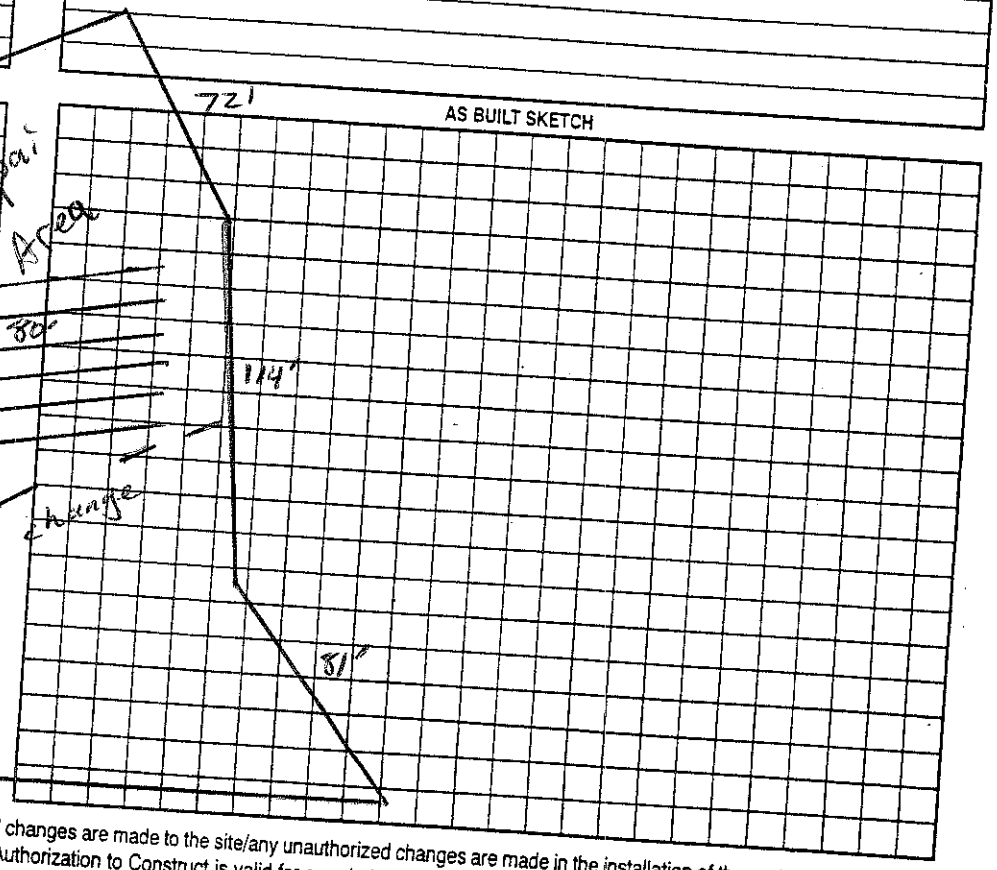

Permit can be suspended or revoked if any false information is supplied toward securing the permit/any unauthorized changes are made to the site/any unauthorized changes are made in the installation of the system. Improvement Authorization to Construct is valid for a period equal to that of Improvement Permit – not to exceed sixty months.

Permit with plan valid without expiration ☐ Improvement Permit with site plan valid for sixty months ☐

Signed:

Improvement Permit by: date 10/24/06

Authorization to Construct by: RS date 10/6/06

Installed by: C+S

Operation Permit by: date 6-19-07

Existing System Inspection by: date

HEALTH DEPT. COPY: WHITE OWNER COPY (FINAL): YELLOW OWNER COPY (INITIAL): PINK