720.00

IREDELL COUNTY HEALTH DEPARTMENT

STATESVILLE 704-878-5305 MOORESVILLE 704-664-5281

IMPROVEMENT PERMIT / AUTHORIZATION TO CONSTRUCT / OPERATION PERMIT / EXISTING SYSTEM INSPECTION

PERMIT# 131192 PIN# ~~4651 75 0254.002~~ 4639347714.000 DATE 10/6/06

OWNER OR APPLICANT Regent Bldrs. PHONE: Business 922-5458 Home

ADDRESS PO Box 5142 Concord NC 28027

LOCATION Perth NW, TL Fern Hill, TR Nautical Pt, on Lt

SUBDIVISION Nautical Pt BLOCK / SECTION LOT 2 LOT AREA 1.41 ac SITE CLASS. PS DESIGN FLOW 450 L.T.A.R. 0.3

Septic Tank: Lowe's Gallons: STB 1012 Date

Pump Tank: Lowe's Gallons: PT 273 Date

Pump Make: Model Serial No.

Nitrification Field: No Fields Square Feet 1200 Linear Feet 400

No Lines 5 @ 80' Trench Width 36" Max Trench Bottom Depth 36" Gravel Depth —

☒ New System ☐ Repair ☐ Expansion System Type: I II III IV V VI

System Description: 25% Reduction

Repair System Description: LP Panel Black

Maintenance Agreement Required: ☐ Yes ☒ No

☒ House/Mod. Home ☐ Mobile Home ☐ Business ☐ Other

No. Bedrooms No. Persons No. Employees


Water Supply: ☒ Individual ☐ Public ☐ Community

☐ Gravity ☒ Pressure ☐ Slab ☒ Crawl Space ☐ Basement w/plumbing ☐ Basement wo/plumbing


Comments:/Conditions: May be installed in 6 lines 67' ea

Comments:/Conditions:

Scale 1:60 INITIAL SITE SKETCH

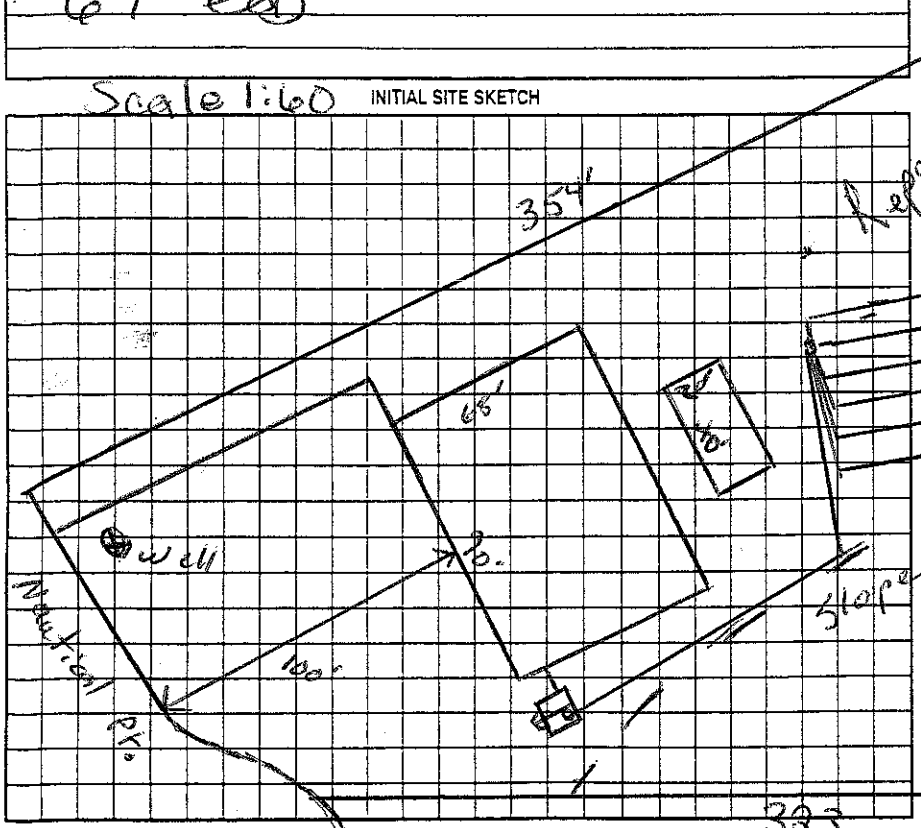

AS BUILT SKETCH

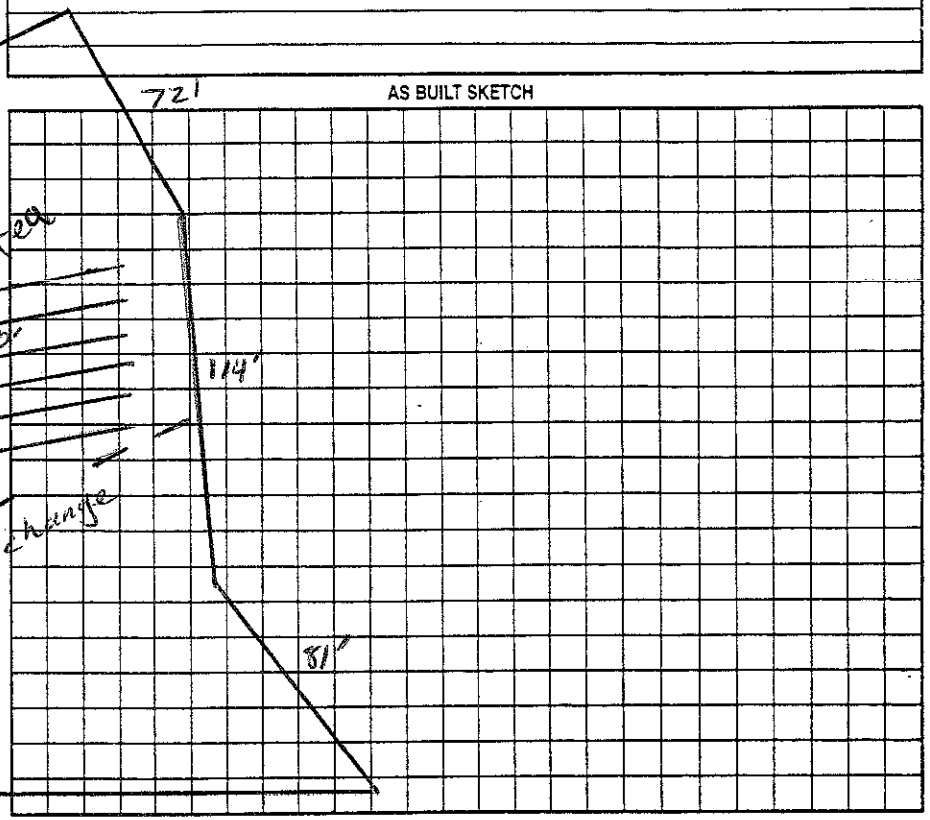

Permit can be suspended or revoked if any false information is supplied toward securing the permit/any unauthorized changes are made to the site/any unauthorized changes are made in the installation of the system. Improvement Permit with plat valid without expiration ☐ Improvement Permit with site plan valid for sixty months ☐ Authorization to Construct is valid for a period equal to that of Improvement Permit – not to exceed sixty months.

Signed: date 10/24/06 Installed by: C+S

Improvement Permit by: RS date 10/6/06 Operation Permit by: Joh E Aapl date 6-19-07

Authorization to Construct by: RS date 10/6/06 Existing System Inspection by: date

HEALTH DEPT. COPY: WHITE OWNER COPY (FINAL): YELLOW OWNER COPY (INITIAL): PINK