# IREDELL COUNTY HEALTH DEPARTMENT

STATESVILLE 704-878-5305 MOORESVILLE 704-664-5281

## IMPROVEMENT PERMIT / AUTHORIZATION TO CONSTRUCT / OPERATION PERMIT / EXISTING SYSTEM INSPECTION

PERMIT# 143811 PIN# 4639351116 4639350199 DATE 7-18-07

OWNER OR APPLICANT All Star Home Builders PHONE: Business 704-622-7376 Home 704-528-0996

ADDRESS 147 Marietta Rd

LOCATION Perth Rd N TL Fern Hill TR Marietta Rd around curve on left 185 Marietta

SUBDIVISION Marietta Overlook BLOCK / SECTION ____ LOT 3 LOT AREA .579Ac SITE CLASS. PS DESIGN FLOW 480gpd L.T.A.R. .3 gpd/ft²

1/2 HP

Septic Tank: 1000 Gallons: STB 1007 Date 8-21-07
Pump Tank: 1000 Gallons: PT 274 Date 8-9-07
Pump Make: Zoeller Model 98 0005 Serial No. ____
Nitrification Field: No Fields 1 Square Feet ____ Linear Feet 275
No Lines 5 Trench Width 24"min Max Trench Bottom Depth 36" Gravel Depth NA ☐ Gravity ☒ Pressure

☒ New System ☐ Repair ☐ Expansion System Type: I II III (IV) V VI
System Description: LP PPBPS
Repair System Description: LP PPBPS
Maintenance Agreement Required: ☒ Yes ☐ No

☒ House/Mod. Home ☐ Mobile Home ☐ Business ☐ Other
No. Bedrooms 4 No. Persons 8 No. Employees ____


Water Supply: ☒ Individual ☐ Public ☐ Community

☐ Slab ☒ Crawl Space ☐ Basement w/plumbing ☐ Basement wo/plumbing

Comments/Conditions: Septic system min. 100' distance from well
Place tanks in swale level with ground and add cover

Comments/Conditions:
Bowco Filter
STw/ risers & marker

INITIAL SITE SKETCH

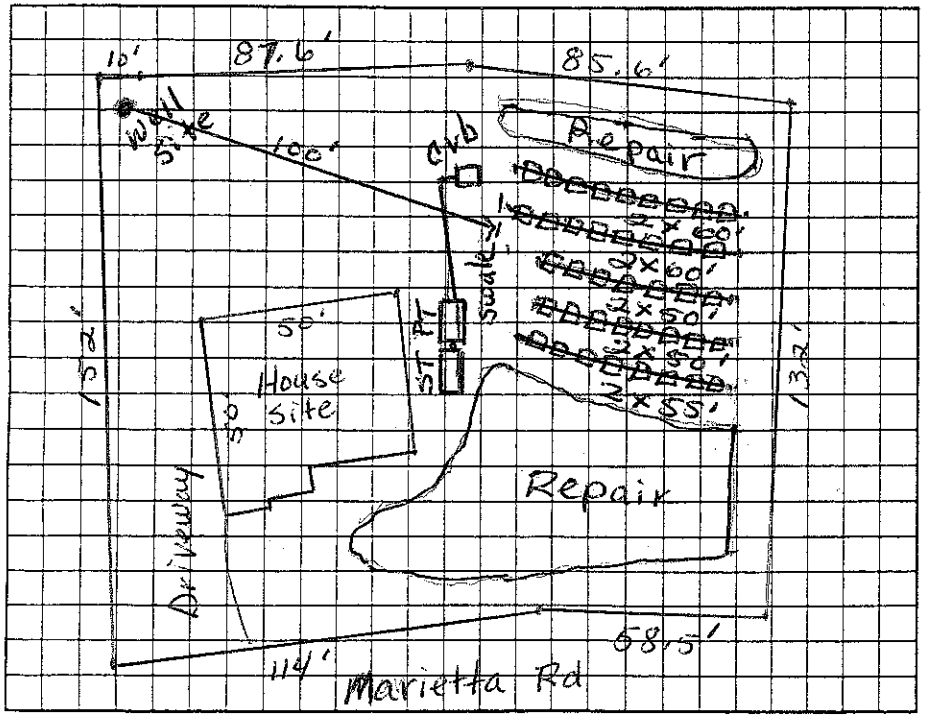


AS BUILT SKETCH

Installed essentially as drawn

Top of Hill →
L1 57'
L2 60'
L3 60'
L4 52'
L5 52'

Permit can be suspended or revoked if any false information is supplied toward securing the permit/any unauthorized changes are made to the site/any unauthorized changes are made in the installation of the system. Improvement Permit with plat valid without expiration ☐ Improvement Permit with site plan valid for sixty months ☒ Authorization to Construct is valid for a period equal to that of Improvement Permit – not to exceed sixty months.

Signed: [signature] date 7-19-07 Installed by: Lamberth Grading

Improvement Permit by: Judy Melville date 7-18-07 Operation Permit by: Judy Melville date 12-21-07

Authorization to Construct by: Judy Melville date 7-19-07 Existing System Inspection by: ____ date ____

HEALTH DEPT. COPY: WHITE OWNER COPY (FINAL): YELLOW OWNER COPY (INITIAL): PINK