IREDELL COUNTY HEALTH DEPARTMENT

STATESVILLE 704-878-5305 375.00 Paid MOORESVILLE 704-664-5281

IMPROVEMENT PERMIT / AUTHORIZATION TO CONSTRUCT / OPERATION PERMIT / EXISTING SYSTEM INSPECTION

PERMIT# 117705 PIN# 4639 35 4375 DATE 1/21/04

OWNER OR CONTRACTOR Christopher Anderson PHONE: Business 704-713-0047 Home

ADDRESS 4022 Centerbrook Dr. Charlotte, NC 28269

LOCATION Post Rd. N, TL Fern Hill TR Marietta Rd. # 156 on (R) just across the hill

SUBDIVISION CL+T BLOCK / SECTION 16 LOT 57 (935) LOT AREA ~.9 SITE CLASS PS DESIGN FLOW 360 L.T.A.R. .3

Septic Tank: 1000 Gallons; STB 317 Date 3/04

Pump Tank: 1000 Gallons; PT 27 Date 3/04

Pump Make: Cowles Model WEO-5 Serial No. EC4476C

Nitrification Field: No Fields 1 Square Feet 420/630 Linear Feet 210

No Lines 3 Trench Width 2-3' Max Trench Bottom Depth 36" Gravel Depth No

[X] New System [ ] Repair System Type: I, II, III, (IV) V, VI

System Description: Pressdosed 16" PPBPS

Repair System Description: <1983 CL+T LOT

Maintenance Agreement Required: [X] Yes [ ] No

[X] House/Mod. Home No. Bedrooms 3

[ ] Mobile Home No. Bathrooms 4.5

[ ] Business No. Employees

[ ] Other

[X] Slab [ ] Crawl Space [X] Basement w/plumbing [ ] Basement wo/plumbing


Water Supply: [X] Individual [ ] Public [ ] Community

Comments:/Conditions: 2' on 8' centers, 3' on 9' centers.
3/16" holes turned to 10:00 and 2:00 in each panel


NO CHANGES WITHOUT ICHD APPROVAL.

Comments:/Conditions:

INITIAL SITE SKETCH

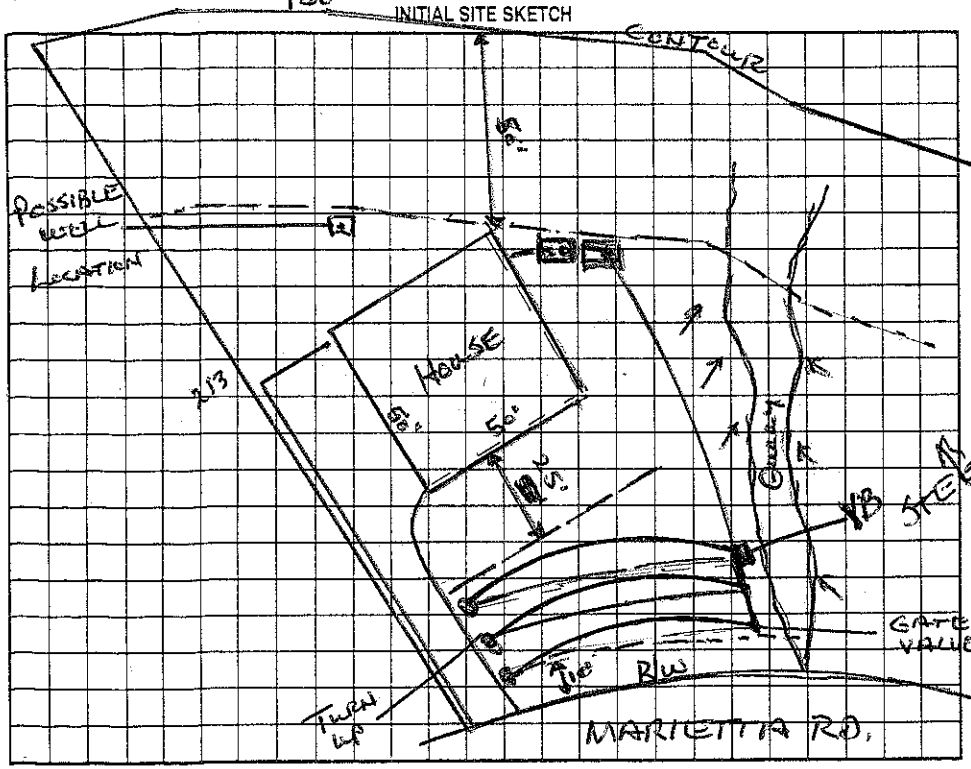

AS BUILT SKETCH

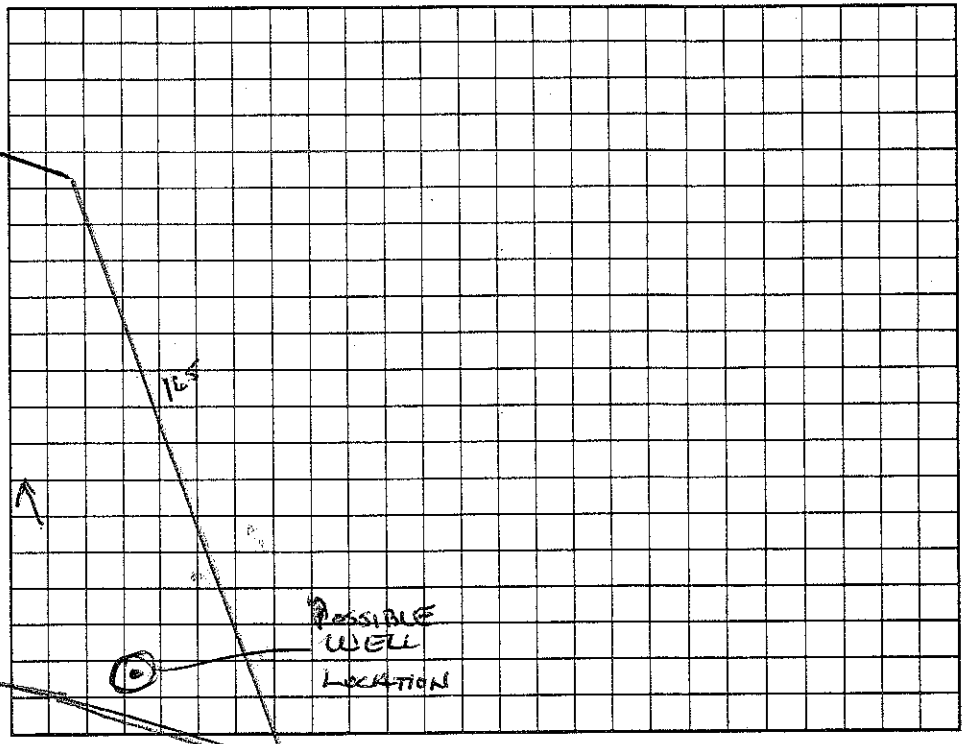

Permit can be suspended or revoked if any false information is supplied toward securing the permit/any unauthorized changes are made to the site/any unauthorized changes are made in the installation of the system. Improvement Permit with plat valid without expiration. Improvement Permit with site plan valid for sixty months. Authorization to Construct is valid for a period equal to that of Improvement Permit – not to exceed sixty months.

Signed: [signature] date 1/21/04

Improvement Permit by: Wesley Sparks RS. date 1/21/04

Authorization to Construct by: Wesley Sparks RS date 1/21/04

Installed by: Dellinger Grading Co.

Operation Permit by: Wesley Sparks RS date 11/24/04

Existing System Inspection by: date

HEALTH DEPT. COPY: WHITE OWNER COPY (FINAL): YELLOW OWNER COPY (INITIAL): PINK