Paid 9:30

IREDELL COUNTY HEALTH DEPARTMENT

STATESVILLE 704-878-5305 MOORESVILLE 704-664-5281

IMPROVEMENT PERMIT / AUTHORIZATION TO CONSTRUCT / OPERATION PERMIT / EXISTING SYSTEM INSPECTION

PERMIT# 131209 PIN# ~~4639450254~~ 4639-35-9322 DATE 3-2-07

OWNER OR APPLICANT David Atkinson PHONE: Business 660-0669 Home 660-0598

ADDRESS 111 Windy Run Ln Mooresville NC 28117 cell (620 226-8319

LOCATION Perth Rd TL Fern Hill TR Nautical Pt at end

SUBDIVISION Nautical Pt BLOCK / SECTION ____ LOT 5 LOT AREA 2.63 Acre SITE CLASS. PS DESIGN FLOW 600 gpd L.T.A.R. .3

Septic Tank: 1500 Gallons: STB 338 Date 9-1-07

Pump Tank: 1500 Gallons: PT 477 Date 9-9-07

Pump Make: Goulds Model WE1012H Serial No. 1HP

Nitrification Field: No Fields 1 Square Feet 672' Linear Feet 336'

No Lines 3@112ft Trench Width 24" min. Max Trench Bottom Depth 36" Gravel Depth N/A ☐ Gravity ☐ Pressure

☒ New System ☐ Repair ☐ Expansion System Type: I II III IV V VI

System Description: Pump-LP-Panel Blk

Repair System Description: Same

Maintenance Agreement Required: ☒ Yes ☐ No

☒ House/Mod. Home ☐ Mobile Home ☐ Business ☐ Other

No. Bedrooms 5 No. Persons ____ No. Employees ____


Water Supply: ☒ Individual ☐ Public ☐ Community

☐ Slab ☐ Crawl Space ☒ Basement w/plumbing ☐ Basement wo/plumbing

Comments:/Conditions: Must keep future pool at least 15Ft from Septic System
Note: Okay to install in 6 lines @ 56 Ft And Centered. Keep any Cut that's 72Ft 15Ft From Septic System.


Comments:/Conditions: Keep well at least 25Ft from House & 100ft From Septic System
Soil evaluation performed by Gm
In line filter installed

INITIAL SITE SKETCH Scale 1:100

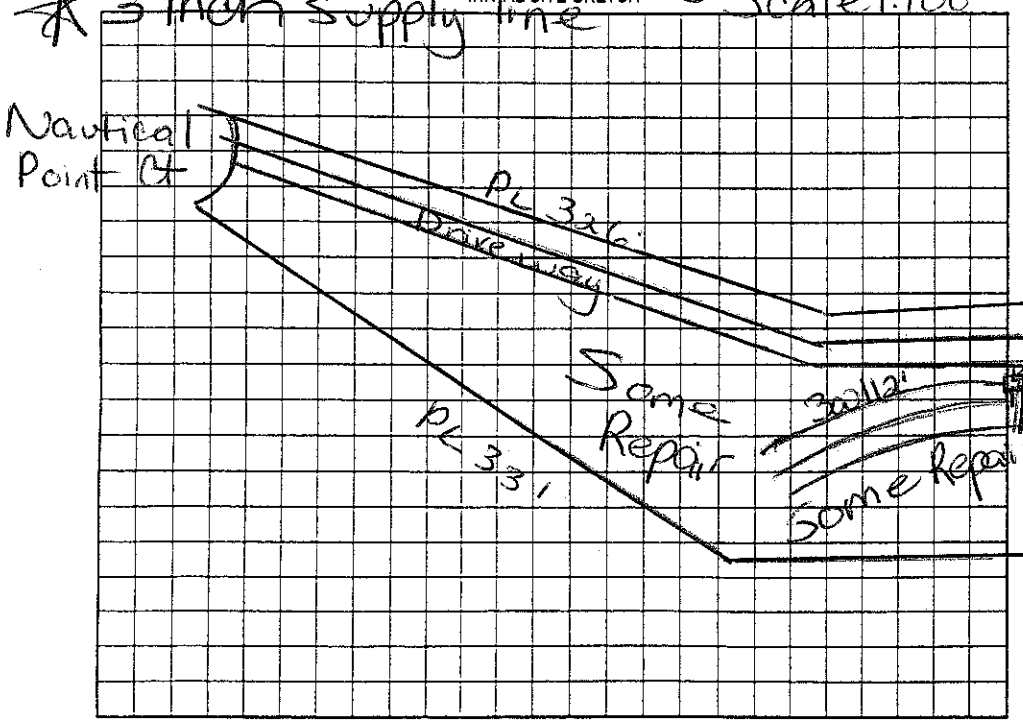

AS BUILT SKETCH

9/21/07 Checked lines
11/19/07 Tanks & pressure checked.

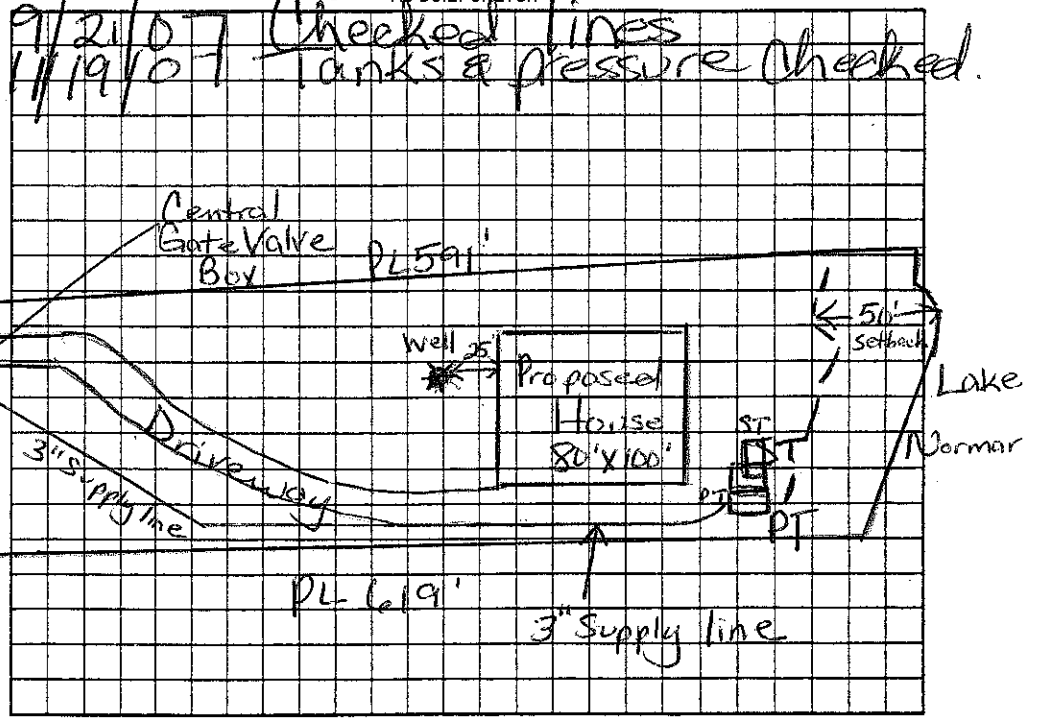

Permit can be suspended or revoked if any false information is supplied toward securing the permit/any unauthorized changes are made to the site/any unauthorized changes are made in the installation of the system. Improvement Permit with plat valid without expiration ☐ Improvement Permit with site plan valid for sixty months ☐ Authorization to Construct is valid for a period equal to that of Improvement Permit – not to exceed sixty months.

Signed: [signature] date 3/2/07. Installed by: C. Wayne Orbison

Improvement Permit by: Maria H. Dolan RS date 3/2/07 Operation Permit by: Wally Sparks R.S. date 2/25/08

Authorization to Construct by: Maria H. Dolan RS date 3/2/07 Existing System Inspection by: ____ date ____

HEALTH DEPT. COPY: WHITE OWNER COPY (FINAL): YELLOW OWNER COPY (INITIAL): PINK