IREDELL COUNTY HEALTH DEPARTMENT

STATESVILLE 704-878-5305 MOORESVILLE 704-664-5281

IMPROVEMENT PERMIT / AUTHORIZATION TO CONSTRUCT / OPERATION PERMIT / EXISTING SYSTEM INSPECTION

PERMIT # 162336 PIN # 4639-36-1660 ✓ DATE 9-13-10

OWNER or APPLICANT REBECCA & STEVEN BRANT PHONE: Business 704-528-1274 Home:

OWNER or APPLICANT ADDRESS 291 TENNESSEE CR

LOCATION / DIRECTIONS PERTH, FERN HILL, TENNESSEE

SUBDIVISION TENNESSEE CIRCLE BLOCK / SECTION LOT # 13 LOT AREA .91AC DESIGN FLOW 360GPD L.T.A.R.

Septic Tank EXISTING Gallons: STB Date

Pump Tank Gallons: PT Date

Pump Make Model Serial #

Nitrification Field No Fields No Lines Linear Feet EXISTING

Trench Width Max Trench Bottom Depth Gravel Depth

☐ New System ☐ Repair ☐ Expansion System Type I (II) III IV V VI

System Description: GRAVITY GRAVEL

Repair System Description: PANEL BLOCK

Maintenance Agreement Required ☐ YES ☒ NO

☐ GRAVITY ☐ PRESSURE

☒ Residence No. Bedrooms 3 ☐ Business No. Persons ☒ Other No. Employees


☐ Slab ☒ Crawl Space ☐ Basement w/plumbing ☐ Basement w/o plumbing

Water Supply: ☒ Private ☐ Public ☐ Community


Comments / Conditions
1. EXISTING IS 400' GRAVITY GRAVEL
2. MEASURED FOR PANEL REPAIR, PLENTY OF ROOM
3. SYSTEM LOOKS GOOD @ TIME OF INSPECTION
4. 5' SETBACK AROUND BUILDING

Comments / Conditions
DETACHED GARAGE

INITIAL SITE SKETCH

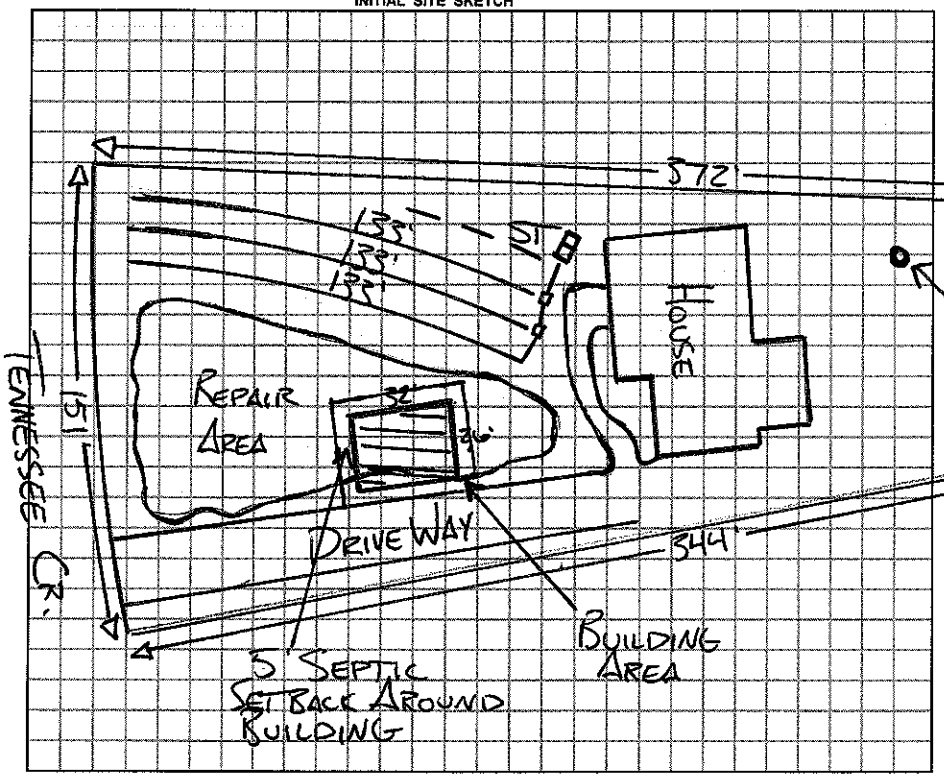

AS BUILT SKETCH

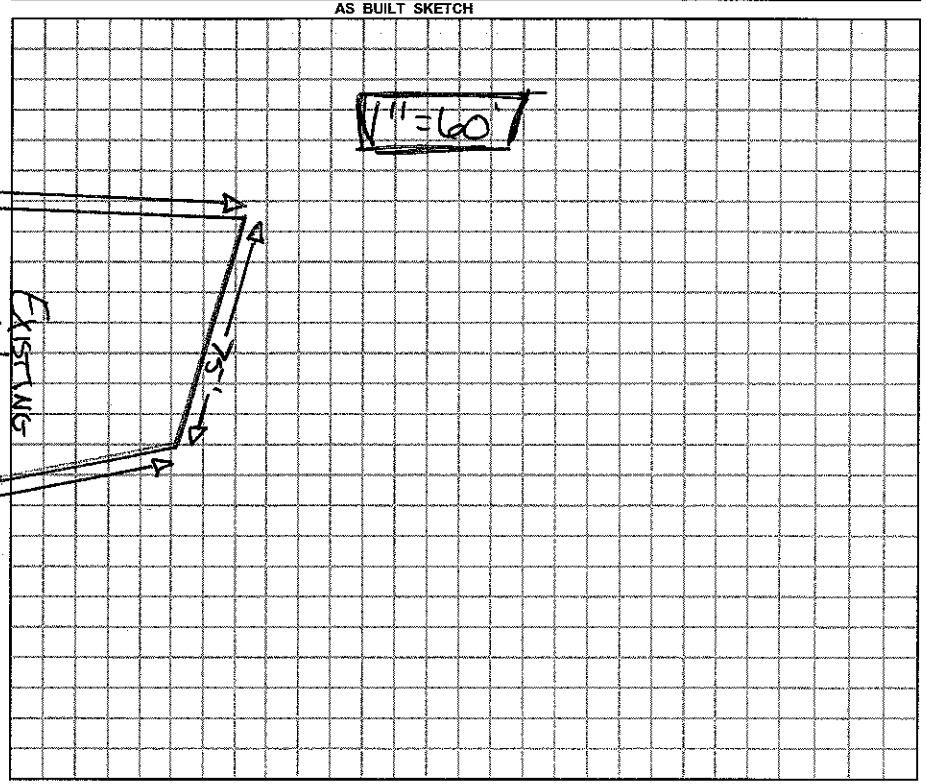

Permit can be suspended or revoked if any false information is supplied toward securing the permit / any unauthorized changes are made to the site / any unauthorized changes are made in the installation of the system.

☐ *IMPROVEMENT PERMIT w / plat valid without expiration.* ☐ *IMPROVEMENT PERMIT w / site plan valid for 60 mos.* ☐ *AUTHORIZATION TO CONSTRUCT valid for period equal to IMPROVEMENT PERMIT-not to exceed 60 mo.*

Owner / Applicant Signature: [signature] Date 9/14/10

Improvement Permit by: Date

Authorization to Construct by: Date

YOU SHOULD CONTACT A LOCATOR SERVICE PRIOR TO ANY EXCAVATION.

Installed by:

Operation Permit by: Date:

Existing System Inspected by: [signature] REHS Date: 9-13-10

WHITE COPY Environmental Health YELLOW COPY (Final) Owner / Applicant PINK COPY (Initial) Owner / Applicant


TENNESSEE CR
Well
1 inch = 60 feet