(2:30)

IREDELL COUNTY HEALTH DEPARTMENT

STATESVILLE 704-878-5305 MOORESVILLE 704-664-5281

IMPROVEMENT PERMIT / CERTIFICATE OF COMPLETION / OPERATION PERMIT / EXISTING SYSTEM INSPECTION

PROPERTY DESCRIPTION NO. 22946 DATE Feb 12, '96 TAX MAP NO. 3C 1A 13 Watershed: ☒ Yes ☐ No WS4CA

OWNER OR CONTRACTOR David Boyd (Ken Rose) PHONE: Business 4659-36-1660 Home

ADDRESS 1970 A Hwy 73 Davidson

LOCATION Path Rd NO Jct Fern Hill Rd. TR Tennessee Circle

SUBDIVISION Tennessee BLOCK / SECTION LOT 13 LOT AREA .91Ac SITE CLASS RS DESIGN FLOW 360gpd L.T.A.R. .3

Septic Tank: 1000 Gallons; STB ~~0~~ 794 Date ~~7/94~~ 12/3/00 ☑ New System ☐ Repair System Type: I. II. III. IV. V. VI

Pump Tank: Gallons; PT Date System Description: gravity conventional

Pump Make: Model Serial No. Repair System Description: same

Nitrification Field: No Fields 1 Square Feet 1200 Linear Feet 400 Maintenance Agreement Required: ☐ Yes ☒ No

No Lines 3 Trench Width 36" Max Trench Bottom Depth ~24" Gravel Depth 12"

☑ House/Mod. Home No. Bedrooms 3
☐ Mobile Home No. Bathrooms 2½
☐ Business No. Employees
☐ Other

☐ Slab ☑ Crawl Space ☐ Basement w/plumbing ☐ Basement wo/plumbing


Water Supply:
☑ Individual
☐ Community
☐ Public

Comments: POLYLOK FOOTER


Comments:

1" = 50'

INITIAL SITE SKETCH

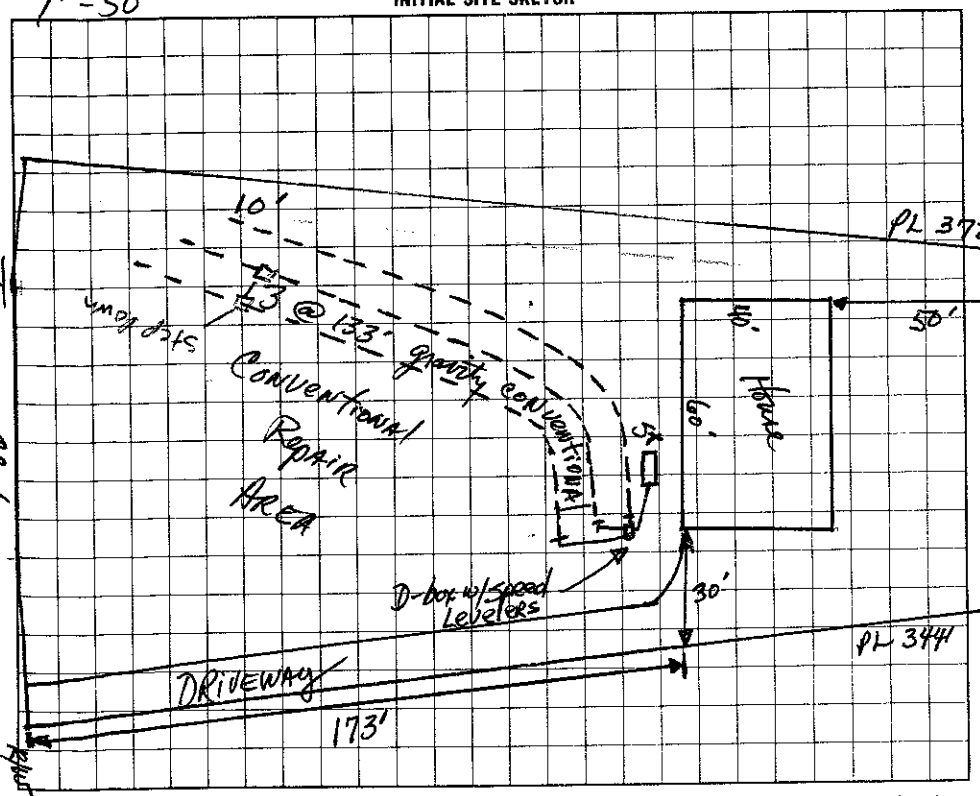

AS BUILT SKETCH

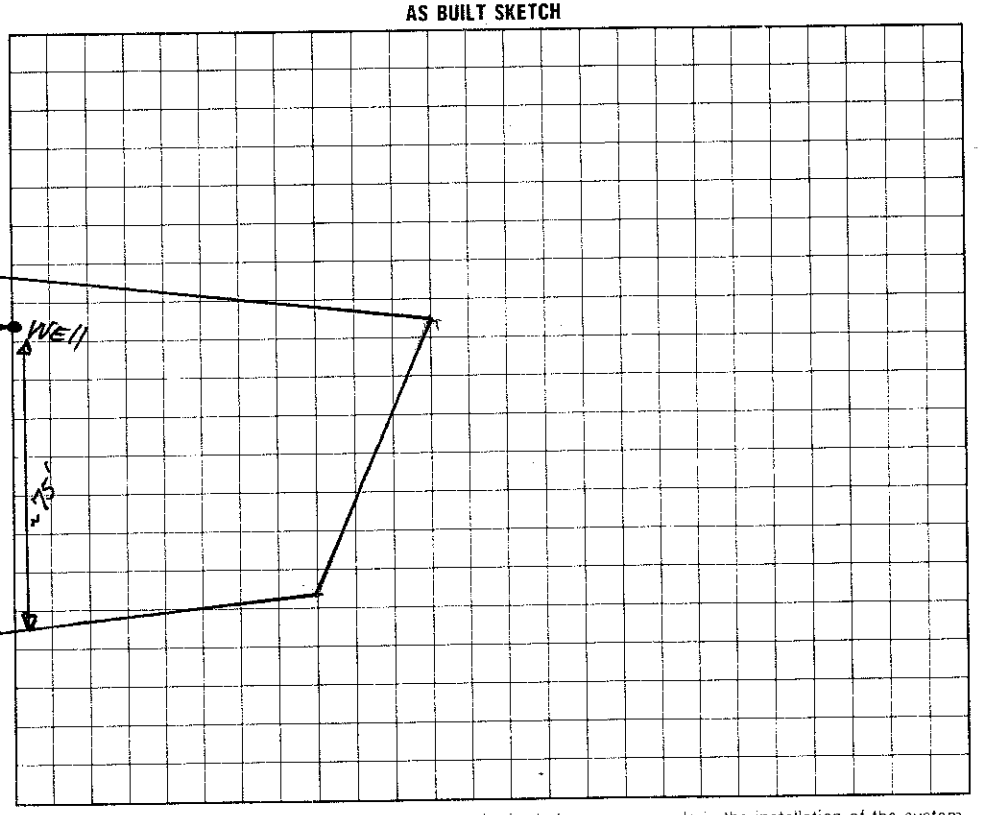

I understand that this permit can be suspended or revoked if any false information is supplied toward securing the permit/any unauthorized changes are made to the site/any unauthorized changes are made in the installation of the system.

Signed: A Thompson Boyd Jr

Improvement Permit by: Jackie D. Hinson, RS date 2-12-96

Existing System Inspection by: Wesley Sparks R.S. date 8/16/00

Installed by: Buddy Chaney

Certificate of Completion by: date

Operation Permit by: C. B. T RS date 2/20/01

HEALTH DEPT. COPY: WHITE INSPECTION COPY (FINAL): GREEN OWNER COPY (FINAL): YELLOW INSPECTION COPY (INITIAL): PINK OWNER COPY (INITIAL): GOLD