[illegible] COUNTY HEALTH DEPARTMENT

STATESVILLE 704-878-5305 MOORESVILLE 704-664-5281

IMPROVEMENT PERMIT / CERTIFICATE OF COMPLETION / OPERATION PERMIT / EXISTING SYSTEM INSPECTION

PROPERTY DESCRIPTION NO. 21238 DATE 6/26/95 TAX MAP NO. 25-A-51 Pt of. Watershed: ☐ Yes ☒ No

OWNER OR CONTRACTOR Tony + Brenda Pasta PHONE: Business Home 543-7375

ADDRESS 10800 Blue Heron Dr. Charlotte, NC. 28226 4639361721

LOCATION Tennessee Cir. to lot 12

SUBDIVISION Tennessee Cir BLOCK / SECTION LOT 12 LOT AREA .94 SITE CLASS. P DESIGN FLOW 360. L.T.A.R. .3

Septic Tank: 1000 Gallons; STB 794 Delanger Date 7-24-96

Pump Tank: Gallons; PT Date

Pump Make: Model Serial No.

Nitrification Field: No Fields 1 Square Feet 1200 Linear Feet 300 (400)

No Lines 5 Trench Width 36" Max Trench Bottom Depth 36" Gravel Depth N/A

☒ New System ☐ Repair System Type: I, II, III, IV, V, VI

System Description: GRAV - INFILTRATOR

Repair System Description:

Maintenance Agreement Required: ☐ Yes ☒ No

☒ House/Mod. Home No. Bedrooms 3

☐ Mobile Home No. Bathrooms 2

☐ Business No. Employees

☐ Other


☐ Slab ☒ Crawl Space ☐ Basement w/plumbing ☐ Basement wo/plumbing

Water Supply: ☒ Individual ☐ Community ☐ Public


Comments:

Comments: 4 lines, 75' long installed

INITIAL SITE SKETCH

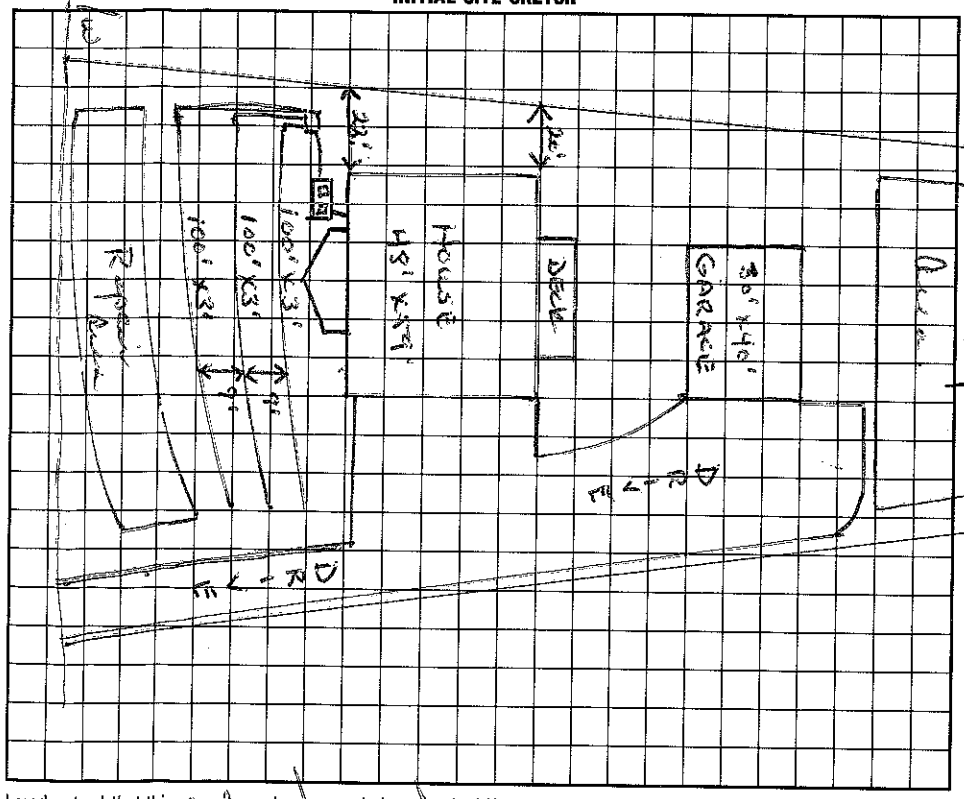

AS BUILT SKETCH

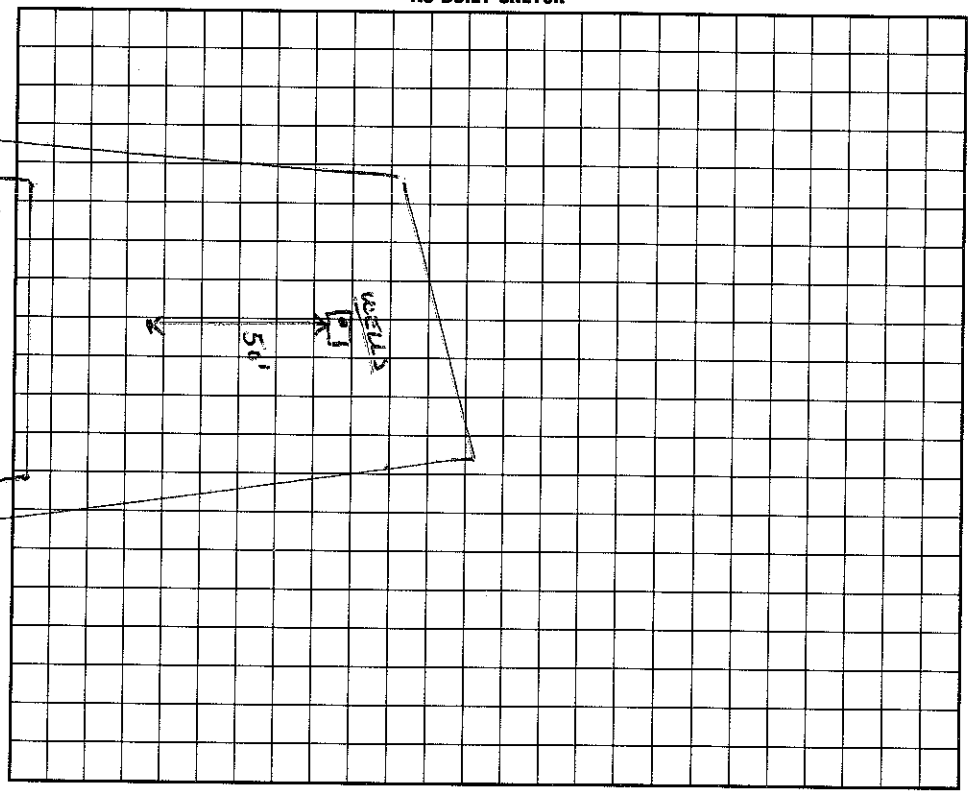

I understand that this permit can be suspended or revoked if any false information is supplied toward securing the permit/any unauthorized changes are made to the site/any unauthorized changes are made in the installation of the system. Improvement Permit is valid for 60 months from date of issuance.

Signed: X

Improvement Permit by: Wesley Sparks R.S. date 6/26/95

Existing System Inspection by: date

Installed by: MacLeod Const.

Certificate of Completion by: date

Operation Permit by: date 9-24-96

HEALTH DEPT. COPY: WHITE INSPECTION COPY (FINAL): GREEN OWNER COPY (FINAL): YELLOW INSPECTION COPY (INITIAL): PINK OWNER COPY (INITIAL): GOLD