IREDELL COUNTY HEALTH DEPARTMENT

STATESVILLE 704-878-5305 MOORESVILLE 704-664-5281

IMPROVEMENT PERMIT / CERTIFICATE OF COMPLETION / OPERATION PERMIT / EXISTING SYSTEM INSPECTION

PROPERTY DESCRIPTION NO. 22718 DATE 12/7/95 TAX MAP NO. 3C 1A 4 4639365865 Watershed: ☐ Yes ☒ No

OWNER OR CONTRACTOR Chalmers Turnerdale PHONE: Business 361-868-3528 Home

ADDRESS 9929 Lichfield Pl. Clinton Md.

LOCATION Tennessee Cir. 4th lot on (L)

SUBDIVISION Tennessee Cir BLOCK / SECTION LOT 4 LOT AREA 1.2 Ac SITE CLASS. P3 DESIGN FLOW 480 L.T.A.R. 3

Septic Tank: 1000 Gallons; STB 794 Date 9-15-97

Pump Tank: Gallons; PT Date

Pump Make: Model Serial No.

Nitrification Field: No Fields 1 Square Feet 1600 Linear Feet 400

No Lines 4 Trench Width 36" Max Trench Bottom Depth 36" Gravel Depth 6" stone

☒ New System ☐ Repair System Type: I, II, III, IV, V, VI

System Description: County sh filtration

Repair System Description: None

Maintenance Agreement Required: ☐ Yes ☒ No

☒ House/Mod. Home ☐ Mobile Home ☐ Business ☐ Other

No. Bedrooms 4 No. Bathrooms 3 No. Employees

☐ Slab ☒ Crawl Space ☐ Basement w/plumbing ☐ Basement wo/plumbing


Water Supply: ☒ Individual ☐ Community ☐ Public

Comments: Lines on slope contour in Chamber shown. ☒ 25% reduction for use of sh filtration

Comments: ☒ Well Not installed at time of INSPECTION

Installed as drawn EXCEPT driveway on other side of lot.

INITIAL SITE SKETCH

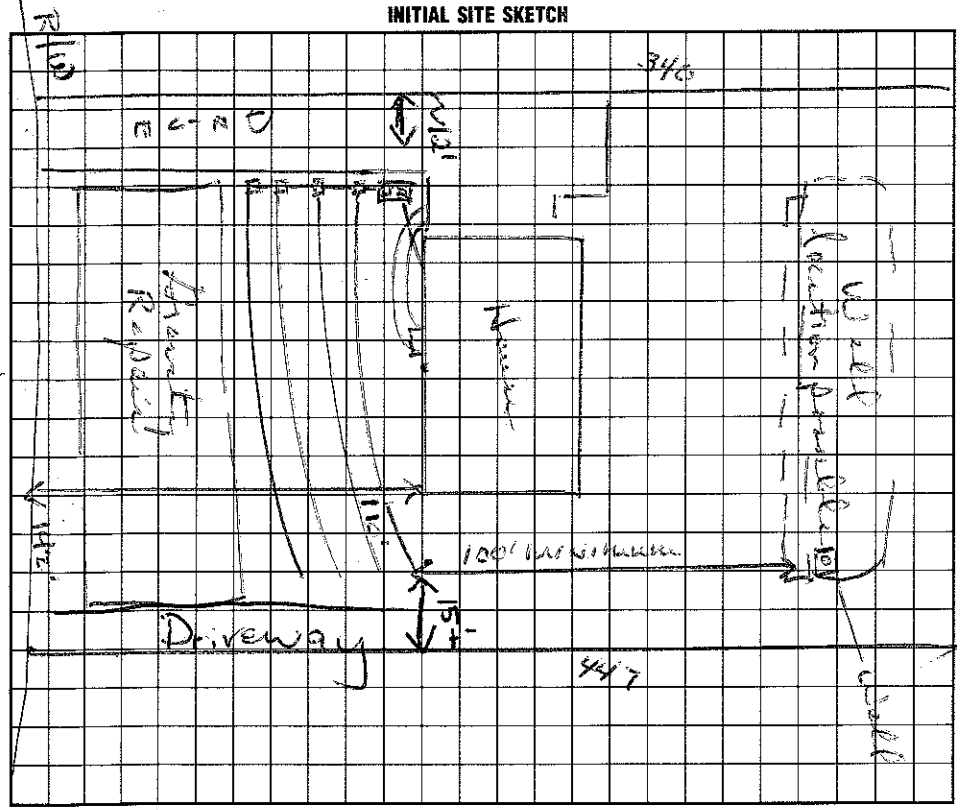

AS BUILT SKETCH

I understand that this permit can be suspended or revoked if any false information is supplied toward securing the permit/any unauthorized changes are made to the site/any unauthorized changes are made in the installation of the system.

Signed: ☒ Judy M. Bruce

Improvement Permit by: Wesley Sparks RS date 12/7/95

Existing System Inspection by: Wesley Sparks RS date 12/7/95

Installed by: D.C Construction

Certificate of Completion by: Maintained by Johnson date 12/3/97

Operation Permit by: Maintained by Johnson date 12/3/97

HEALTH DEPT. COPY: WHITE INSPECTION COPY (FINAL): GREEN OWNER COPY (FINAL): YELLOW INSPECTION COPY (INITIAL): PINK OWNER COPY (INITIAL): GOLD