IREDELL COUNTY HEALTH DEPARTMENT

Auth to Construct

STATESVILLE 704-878-5305 MOORESVILLE 704-664-5281

4639367500

IMPROVEMENT PERMIT / ~~CERTIFICATE OF COMPLETION~~ / OPERATION PERMIT / EXISTING SYSTEM INSPECTION

PROPERTY DESCRIPTION NO. 22949 DATE 1/30/96 TAX MAP NO. 3C 1A 18 Watershed: X Yes ☐ No

OWNER OR CONTRACTOR Allen Tolar PHONE: Business 713-479-9791 Home

ADDRESS 214 Ex. ST. Deer Park, Tx. 77536

LOCATION Tennessee Cir - South TL From Mill TR Tenn. Cir, (L) fork, 3 RD lot on R

SUBDIVISION Tenn. Circle BLOCK / SECTION LOT 18 LOT AREA .94 AC SITE CLASS. PS DESIGN FLOW 360 L.T.A.R. .3

Septic Tank: 1000 Gallons; STB 794 Date 12/6/98

Pump Tank: Gallons; PT Date

Pump Make: Model Serial No.

Nitrification Field: No Fields 1 Square Feet 1200 Linear Feet 400

No Lines 5 Trench Width 36" Max Trench Bottom Depth 36" Gravel Depth 12"

X New System ☐ Repair System Type: I (II) III. IV. V. VI

System Description: CONV

Repair System Description: SAME

Maintenance Agreement Required: ☐ Yes X No

X House/Mod. Home No. Bedrooms 3

☐ Mobile Home No. Bathrooms 2

☐ Business No. Employees

☐ Other


☐ Slab X Crawl Space ☐ Basement w/plumbing ☐ Basement wo/plumbing

Water Supply: X Individual ☐ Community ☐ Public


Comments:

Comments:

INITIAL SITE SKETCH

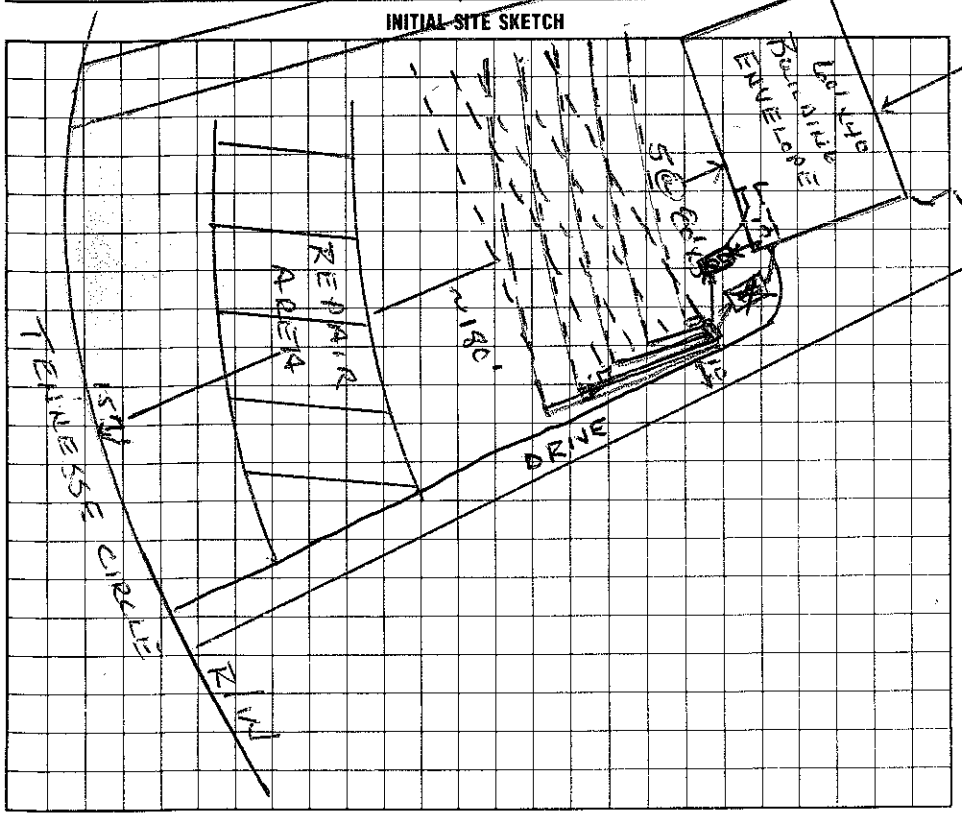

AS BUILT SKETCH

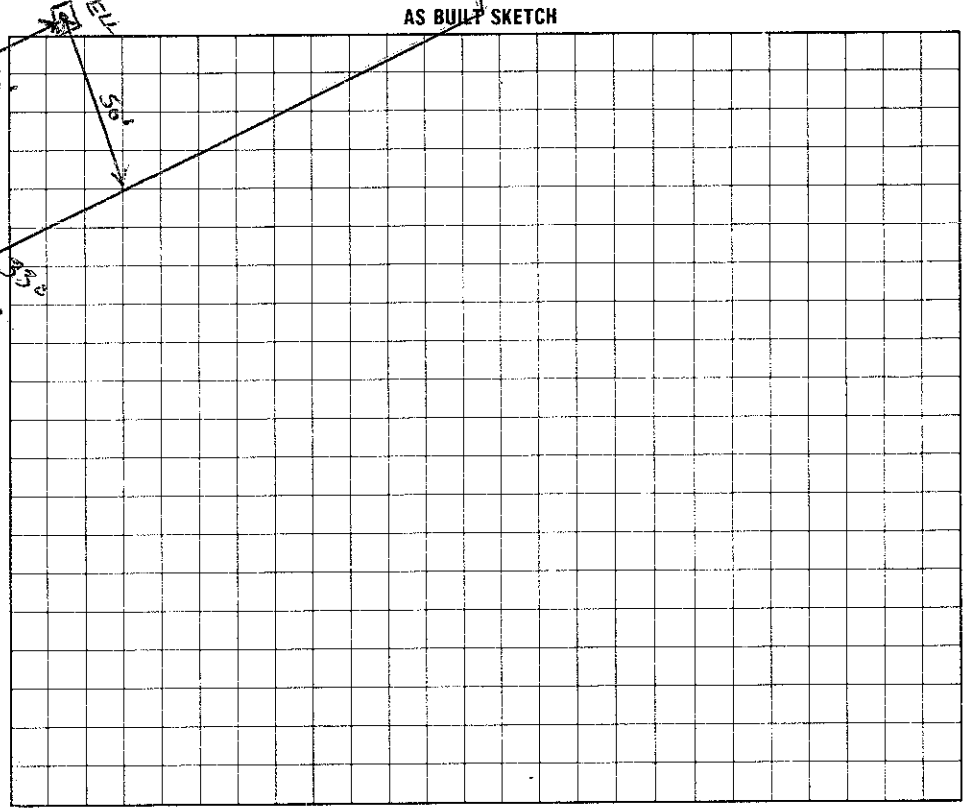

I understand that this permit can be suspended or revoked if any false information is supplied toward securing the permit/any unauthorized changes are made to the site/any unauthorized changes are made in the installation of the system.

Auth Inspection to Construct valid 5 years.

Signed: X

Improvement Permit by: Wesley Sparks R.S. date 1/30/96

~~Certificate of Completion by:~~ Auth to Construct Wesley Sparks R.S. date 1/30/96

Installed by: Champs Septic Service

Certificate of Completion by: Wesley Sparks R.S. date 5/5/99

Operation Permit by: Wesley Sparks R.S. date 5/5/99

HEALTH DEPT. COPY: WHITE INSPECTION COPY (FINAL): GREEN OWNER COPY (FINAL): YELLOW INSPECTION COPY (INITIAL): PINK OWNER COPY (INITIAL): GOLD