IREDELL COUNTY HEALTH DEPARTMENT

STATESVILLE 704-878-5305 155.00 Paid 1130 MOORESVILLE 704-664-5281

IMPROVEMENT PERMIT / AUTHORIZATION TO CONSTRUCT / OPERATION PERMIT / EXISTING SYSTEM INSPECTION

PERMIT# 103 604 PIN# 4639 - 36 - 8168 DATE 4/2/02

OWNER OR CONTRACTOR Gallery Homes PHONE: Business _____ Home _____

ADDRESS Po Box 1227 Waxhaw NC 28173

LOCATION Perth, TL Fern Hill, TR Tennesse Cir, TL Tennesse Cir on Lt 330 Tennesse Cir

SUBDIVISION CL+T BLOCK / SECTION 16 LOT 931 LOT AREA 1.55 AC. SITE CLASS. PS DESIGN FLOW 360 L.T.A.R. 0.5

Septic Tank: 1000 Gallons; STB 317 Date 4/23/02
Pump Tank: 1000 Gallons; PT _____ Date 4/31/02
Pump Make: Gould Model WE0-511HH Serial No. G0244144
Nitrification Field: No. Fields 1 Square Feet 900 Linear Feet 300
No Lines 3 @ 10' Trench Width 36" Max Trench Bottom Depth 24" Gravel Depth —

☒ New System ☐ Repair System Type: I, II, (III), IV, V, VI
System Description: Pump 25% Reduction
Repair System Description: same
Maintenance Agreement Required: ☐ Yes ☒ No


☒ House/Mod. Home ☐ Mobile Home ☐ Business ☐ Other
No. Bedrooms 3 No. Bathrooms 2½ No. Employees ____
☐ Slab ☐ Crawl Space ☐ Basement w/plumbing ☒ Basement wo/plumbing

Water Supply: ☒ Individual ☐ Public ☐ Community
Existing


Comments:/Conditions:

Comments:/Conditions:

INITIAL SITE SKETCH Not to Scale

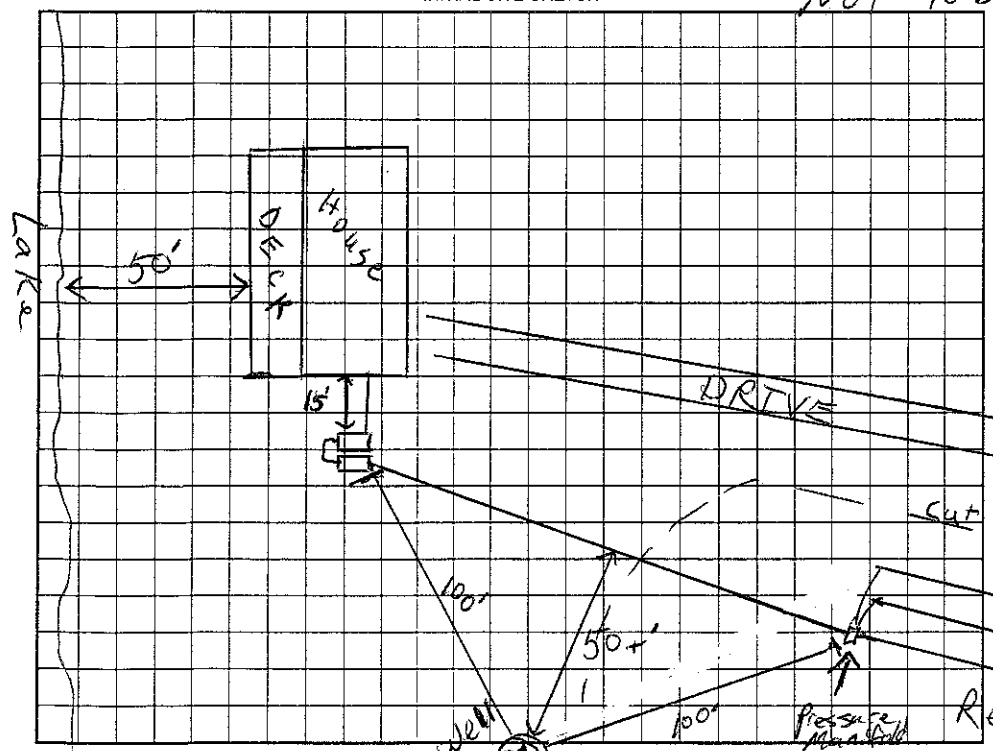

AS BUILT SKETCH

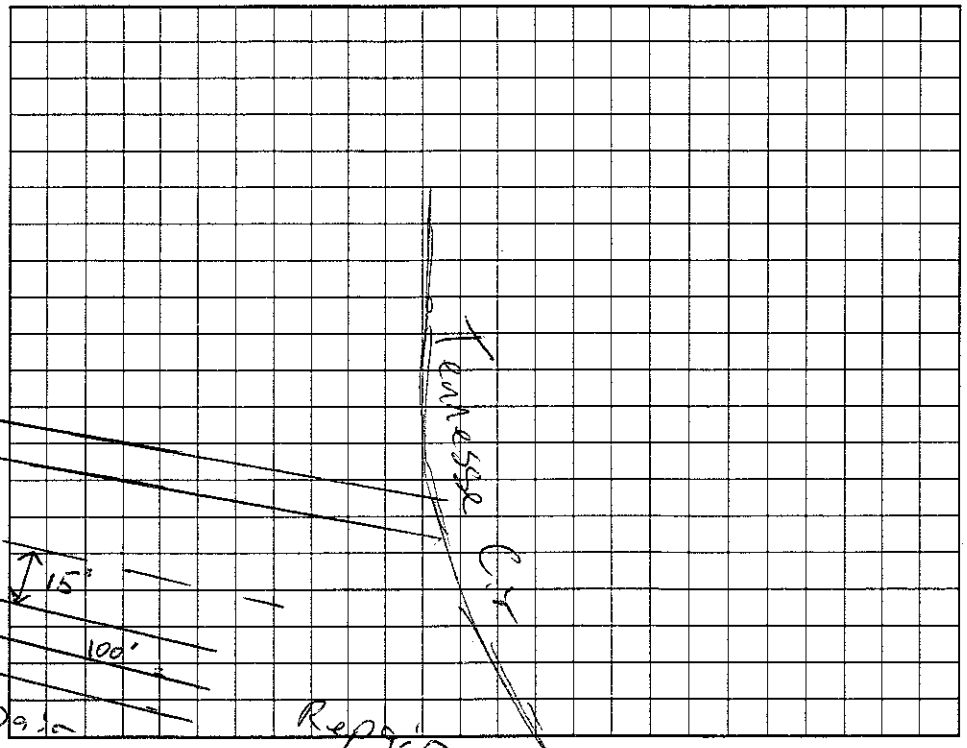

Permit can be suspended or revoked if any false information is supplied toward securing the permit/any unauthorized changes are made to the site/any unauthorized changes are made in the installation of the system. Improvement Permit with plat valid without expiration. Improvement Permit with site plan valid for sixty months. Authorization to Construct is valid for a period equal to that of Improvement Permit – not to exceed sixty months.

Signed: Melody Caudill for Gallery Homes date 4-3-02 Installed by: Bob McCarver

Improvement Permit by: RS date 4/2/02 Operation Permit by: RS date 8/8/02

Authorization to Construct by: RS date 4/2/02 Existing System Inspection by: _____ date _____

HEALTH DEPT. COPY: WHITE OWNER COPY (FINAL): YELLOW OWNER COPY (INITIAL): PINK