4639368565 1.30

IREDELL COUNTY HEALTH DEPARTMENT Const. Auth. STATESVILLE 704-878-5305 MOORESVILLE 704-664-5281

IMPROVEMENT PERMIT / ~~CERTIFICATE OF COMPLETION~~ / OPERATION PERMIT / EXISTING SYSTEM INSPECTION

PROPERTY DESCRIPTION NO. 22947 DATE Feb 12, '96 TAX MAP NO. 3C1A20 Watershed: ✓ Yes ☐ No

OWNER OR CONTRACTOR Rick Knight // Charles Spangler PHONE: Business _____ Home _____ WS4CA

ADDRESS 184 Freeman Loop, Mooresville

LOCATION Beth Rd. N. TL Fern Hill Rd. TR Tennessee Circle Bear left @ forks 2nd lot on Right

SUBDIVISION Tennessee Circle BLOCK / SECTION _____ LOT 20 LOT AREA .53Ac SITE CLASS. PS ~~PS~~ DESIGN FLOW 360gpd L.T.A.R. .3

Septic Tank: 1000 Gallons; STB 794 Date 1/25/94

Pump Tank: _____ Gallons; PT _____ Date _____

Pump Make: _____ Model _____ Serial No. _____

Nitrification Field: No Fields 1 Square Feet 900 Linear Feet 300

No Lines 3@100' Trench Width 36" Max Trench Bottom Depth 24" Gravel Depth NA

~~New System~~ ☐ Repair System Type: I, II, III, IV, V, VI

System Description: gravity Infiltrator

Repair System Description: ~~Stone~~

Maintenance Agreement Required: ☐ Yes ~~No~~

~~House/Mod. Home~~ ☐ Mobile Home ☐ Business ☐ Other

No. Bedrooms 3 No. Bathrooms 2½ No. Employees _____

☐ Slab ~~Crawl Space~~ ☐ Basement w/plumbing ☐ Basement wo/plumbing


Water Supply: ~~Individual~~ ☐ Community ☐ Public

Comments: 11-17-98 House plan reviewed. Move house site towards REAR 5'. Would appear compliant w/ I.T. DRH

Comments:

1"=50'

INITIAL SITE SKETCH

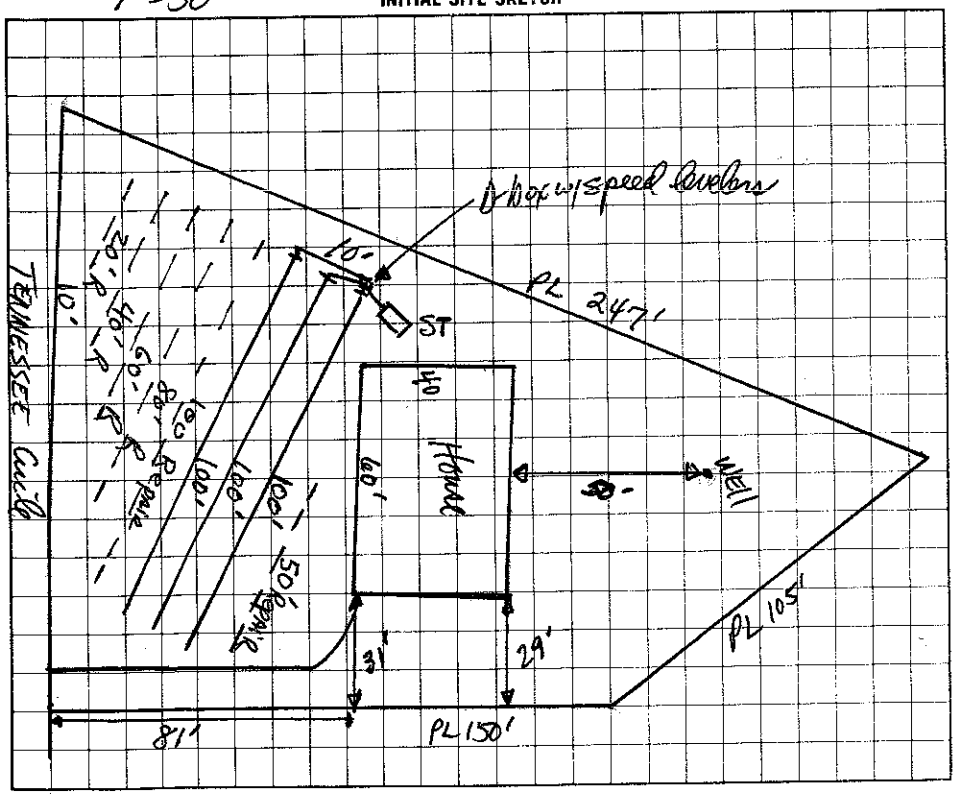

AS BUILT SKETCH

I understand that this permit can be suspended or revoked if any false information is supplied toward securing the permit/any unauthorized changes are made to the site/any unauthorized changes are made in the installation of the system.

Signed: A Thornton // N/ Brooks Jr

Improvement Permit by: _____ date 2-12-96

~~Construction~~ ~~Existing System~~ Inspection by: _____ date 11-17-98

Installed by: LARRY BEAM

Certificate of Completion by: _____ date _____

Operation Permit by: _____ date 7/9/97

~~Authorization~~ HEALTH DEPT. COPY: WHITE INSPECTION COPY (FINAL): GREEN OWNER COPY (FINAL): YELLOW INSPECTION COPY (INITIAL): PINK OWNER COPY (INITIAL): GOLD