10:30 - 11:00

IREDELL COUNTY HEALTH DEPARTMENT

STATESVILLE 704-878-5305 MOORESVILLE 704-664-5281

IMPROVEMENT PERMIT / AUTHORIZATION TO CONSTRUCT / OPERATION PERMIT / EXISTING SYSTEM INSPECTION

PERMIT# 22942 PIN# 3C1A2 4639368747 DATE 11/24/99

OWNER OR CONTRACTOR ZAREN HOMES PHONE: Business 370-7707 Home

ADDRESS 1043 E MOOREHEAD ST CHARLOTTE

LOCATION PERTH RD - TL FERNHILL TR TENNESSEE CIRCLE ON LT

SUBDIVISION TENNESSEE CIRCLE BLOCK / SECTION LOT 2 LOT AREA .56 AC SITE CLASS. KS DESIGN FLOW 360 gpd L.T.A.R. .3 gpd/ft²

Septic Tank: 1000 Gallons; STB 1160 Date 12-22-99
Pump Tank: Gallons; PT Date
Pump Make: Model Serial No.
Nitrification Field: No Fields 1 Square Feet 600 Linear Feet 200
No Lines 4@50' Trench Width 36" Max Trench Bottom Depth 30"

☑ New System ☐ Repair System Type: I, II, III, IV, V, VI
System Description: GRAVITY FANCL
Repair System Description: SAME
Maintenance Agreement Required: ☐ Yes ☑ No
Gravel Depth


☑ House/Mod. Home No. Bedrooms 3
☐ Mobile Home No. Bathrooms 2
☐ Business No. Employees
☐ Other
☐ Slab ☑ Crawl Space ☐ Basement w/plumbing ☐ Basement wo/plumbing

Water Supply: ☑ Individual ☐ Public ☐ Community


Comments:/Conditions:

Comments:/Conditions:

INITIAL SITE SKETCH 1"=50'

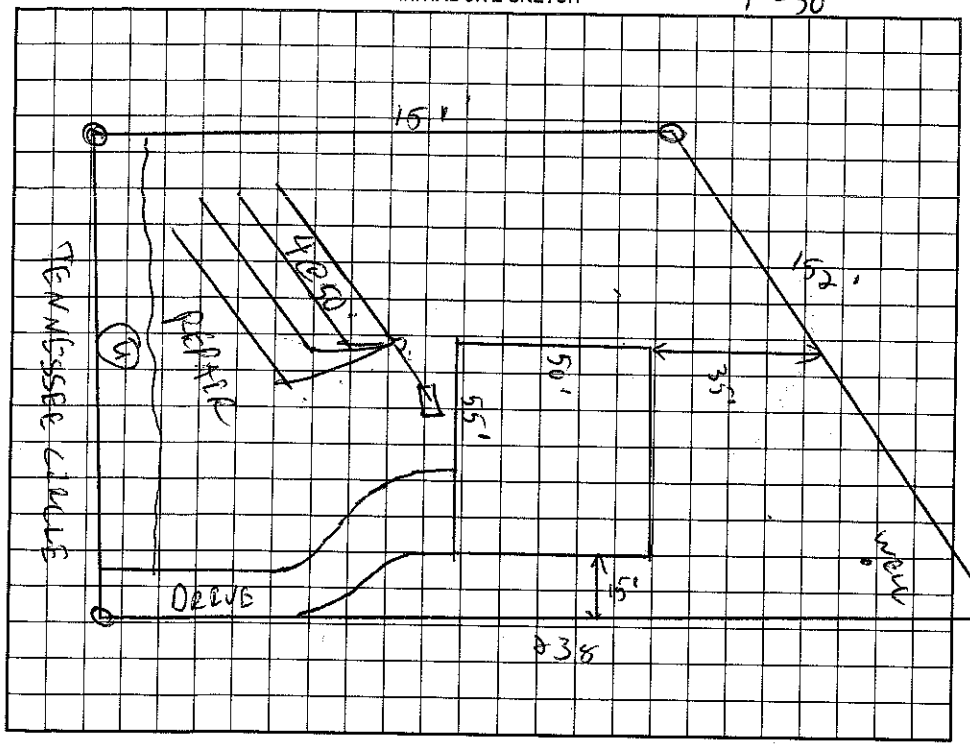

AS BUILT SKETCH

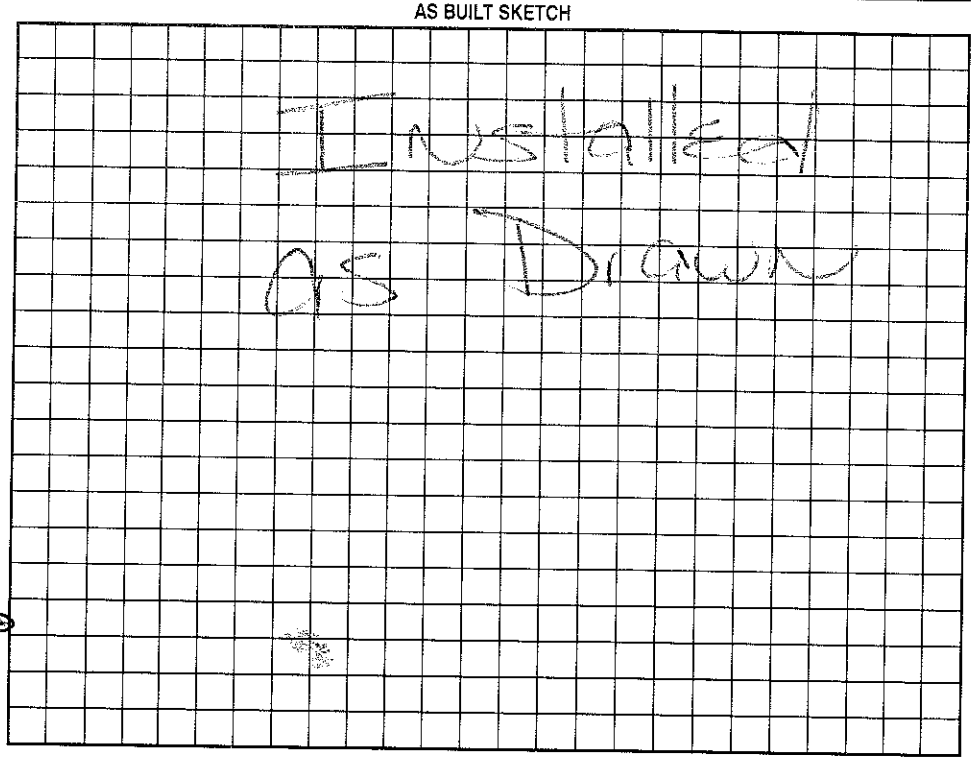

Permit can be suspended or revoked if any false information is supplied toward securing the permit/any unauthorized changes are made to the site/any unauthorized changes are made in the installation of the system. Improvement Permit with plat valid without expiration. Improvement Permit with site plan valid for sixty months. Authorization to Construct is valid for a period equal to that of Improvement Permit – not to exceed sixty months.

Signed: date

Improvement Permit by: C. [illegible] KS date 11/24/99

Authorization to Construct by: C. [illegible] KS date 11/24/99

Installed by: Mac Land Construction

Operation Permit by: [illegible] KS date 2/10/2000

Existing System Inspection by: date

HEALTH DEPT. COPY: WHITE OWNER COPY (FINAL): YELLOW OWNER COPY (INITIAL): PINK