IREDELL COUNTY HEALTH DEPARTMENT

Authorization to Construct 4639373125

STATESVILLE 704-878-5305 MOORESVILLE 704-664-5281

IMPROVEMENT PERMIT / CERTIFICATE OF COMPLETION / OPERATION PERMIT / EXISTING SYSTEM INSPECTION

PROPERTY DESCRIPTION NO. 21233 DATE 11/18/97 TAX MAP NO. Pt of 25 A 51 Watershed: [X] Yes [ ] No

OWNER OR CONTRACTOR Fritts Construction PHONE: Business 483-8750 Home

ADDRESS 3968 Blades Trail Denver, NC 28037

LOCATION Hwy 150 TR Perth Rd (L) of Fern Hill Rd TR Tennessee Circle, Lot is on (L)

SUBDIVISION Tennessee Circle BLOCK / SECTION LOT 7 LOT AREA 21,780 ft² SITE CLASS. PS DESIGN FLOW 360 L.T.A.R. .3

Septic Tank: 1000 Gallons; STB 794 Date 4/13/98
Pump Tank: Gallons; PT Date
Pump Make: Model Serial No.
Nitrification Field: No Fields 1 Square Feet 900± Linear Feet 300±
No Lines 3 Trench Width 36" Max Trench Bottom Depth 36" Gravel Depth SAND.

[X] New System [ ] Repair System Type: I, II, (III), IV, V, VI
System Description: GRAY - CH PLASTIC
Repair System Description: CH - PLASTIC
Maintenance Agreement Required: [ ] Yes [X] No


[X] House/Mod. Home No. Bedrooms 3
[ ] Mobile Home No. Bathrooms 3
[ ] Business No. Employees
[ ] Other
[ ] Slab [ ] Crawl Space [ ] Basement w/plumbing [ ] Basement wo/plumbing

Water Supply:
[X] Individual
[ ] Community
[ ] Public

Comments:

Comments:

INITIAL SITE SKETCH

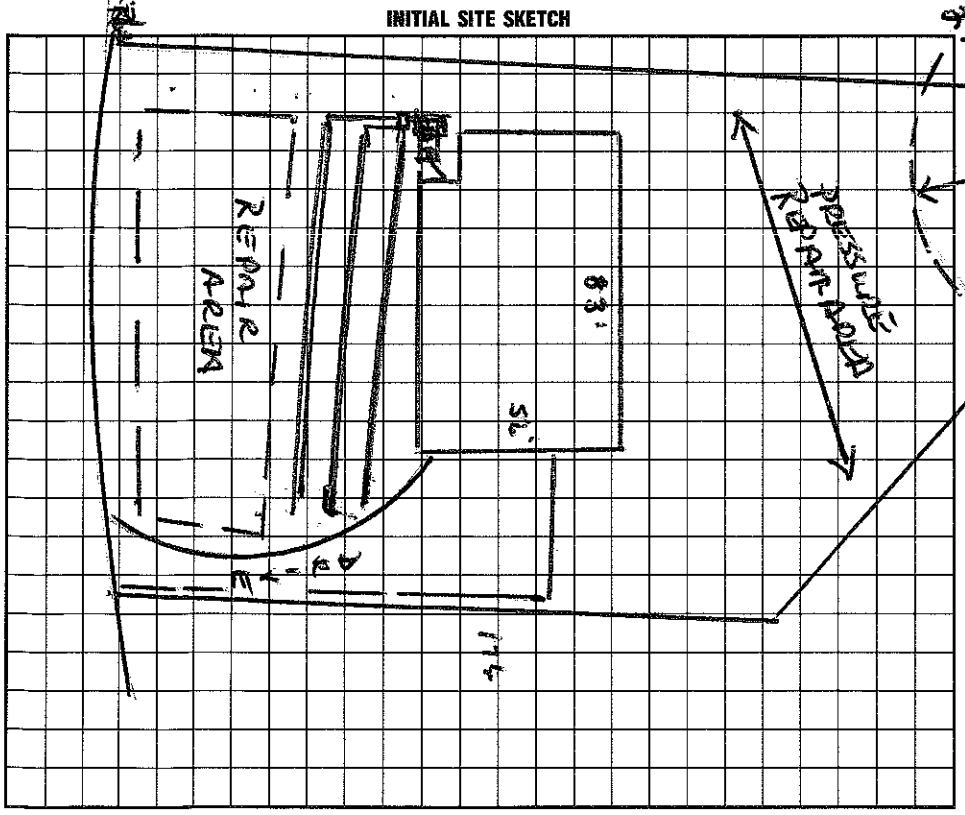

AS BUILT SKETCH

I understand that this permit can be suspended or revoked if any false information is supplied toward securing the permit/any unauthorized changes are made to the site/any unauthorized changes are made in the installation of the system. Improvement Permit is valid for 60 months from date of issuance.

Signed: [signature]

Improvement Permit by: Wesley Sparks R.S. date 11/18/97

Existing System Inspection by: Wesley Sparks R.S. date 11/18/97

Installed by: Dwight Avery

Certificate of Completion by: Wesley Sparks R.S. date 7/9/98

Operation Permit by: Wesley Sparks RS date 7/9/98

HEALTH DEPT. COPY: WHITE INSPECTION COPY (FINAL): GREEN OWNER COPY (FINAL): YELLOW INSPECTION COPY (INITIAL): PINK OWNER COPY (INITIAL): GOLD