IREDELL COUNTY HEALTH DEPARTMENT

Statesville Office (704) 878-5305 Mooresville Office (704) 660-3625 PERMIT # 213061

IMPROVEMENT PERMIT / AUTHORIZATION TO CONSTRUCT / OPERATION PERMIT / EXISTING SYSTEM

PIN # 4639-40-3599.000

APPLICANT: Wesley Cleckley APPLICANT ADDRESS: 4525 Stryker Dr Wilmington NC 28409

SITE ADDRESS: 291 Kenway Ln Mooresville NC PHONE: 843-821-9679 ALT. PHONE: 704-776-5852 *

SITE DIRECTIONS: From N. Tl Fernhill, Tl Kenway Ln, Site on L

SUBDIVISION: C.S.T SECTION: 15 LOT # 10 LOT AREA: .730 Acre DESIGN FLOW: Existing L.T.A.R.: Existing

Septic Tank Existing (gal) STB Date

Pump Tank (gal) PT Date

Pump Make Model Serial #

Nitrification Fields Ex # Lines Ex Linear Ft: Ex

Trench Width Ex Max. Trench Bottom Depth Ex Gravel Depth Ex

☐ New System ☐ Repair ☐ Expansion System Type: I II III IV V VI

System Description: Existing PPSPS + Conventional

Repair System Description: Exempt

Maintenance Agreement Required: ☐ YES ☒ NO

☒ GRAVITY ☐ PRESSURE

☒ Residence ☐ Business ☐ Other ☐ Slab ☒ Basement w/plumbing

No. Bedrooms Ex 4 No. Persons Ex 8 No. Employees ☐ Crawl Space


☐ Basement w/o plumbing

Water Supply: ☒ Private ☐ Public ☐ Community


Comments / Conditions: System Appeared To Be Functioning At Time Of Inspection.

INITIAL SITE SKETCH

1" = 40'

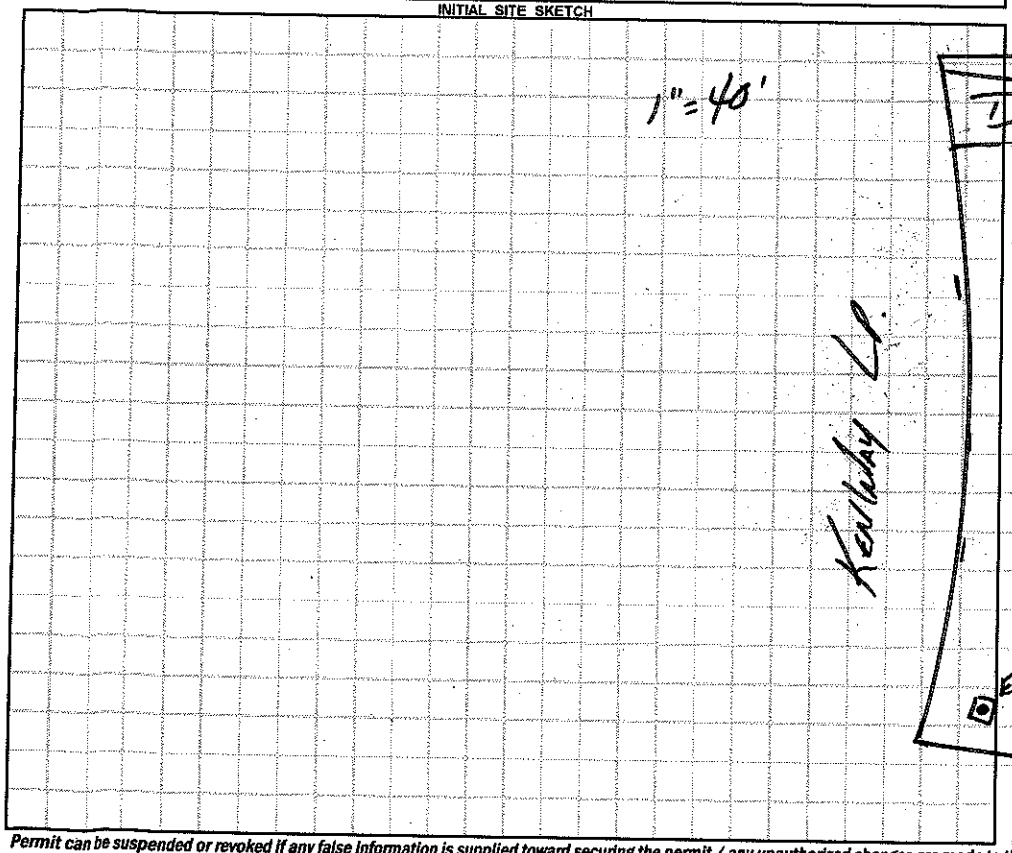

AS BUILT SKETCH

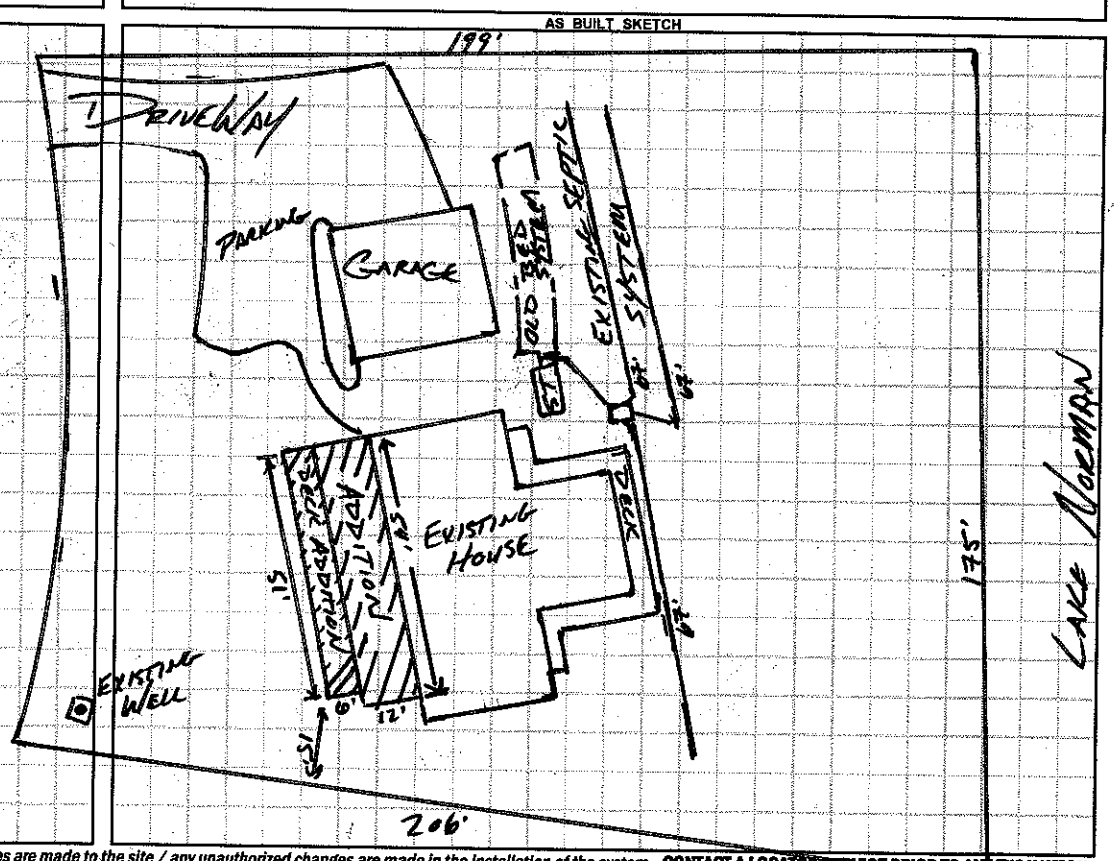

Permit can be suspended or revoked if any false information is supplied toward securing the permit / any unauthorized changes are made to the site / any unauthorized changes are made in the installation of the system. **CONTACT A LOCATOR SERVICE PRIOR TO ANY EXCAVATION**

☐ **IMPROVEMENT PERMIT** *with plat valid without expiration.* ☐ **IMPROVEMENT PERMIT** *with site plan valid for 60 mos.* ☐ **AUTHORIZATION TO CONSTRUCT** *valid for period equal to IMPROVEMENT PERMIT--not to exceed 60 mo.*

Owner / Applicant Signature: Wesley Cleckley Date: 11/10/2015 Installed by:

IMPROVEMENT PERMIT by: Date: OPERATION PERMIT by: Date:

AUTHORIZATION TO CONSTRUCT by: Date: Existing System Inspected by: APPROVED OCT 29 2015

Health Dept. Copy - WHITE Applicant (Final Approval) - YELLOW Applicant (Conditional Approval) - PINK