IREDELL COUNTY HEALTH DEPARTMENT

Statesville Office (704) 878-5305 Mooresville Office (704) 660-3625 PERMIT # 3:00 20156 ✓ Plat

IMPROVEMENT PERMIT / AUTHORIZATION TO CONSTRUCT / OPERATION PERMIT / EXISTING SYSTEM

PIN # 4639404763

APPLICANT: James Ray APPLICANT ADDRESS: 8619 Barclay Woods Ct

SITE ADDRESS: 285 Kenway LP PHONE: 704-877-1178 ALT. PHONE: N/A

SITE DIRECTIONS: 150W TR Perth Rd. TL Fernhill Rd. TL Kenway LP.


SUBDIVISION: CL+T SECTION: 15 LOT # 9 LOT AREA: 0.73 acres DESIGN FLOW: 360gpd L.T.A.R.: Existing

Septic Tank	1000	(gal)	STB	760	Date	3-26-13	☐ New System	☑ Repair	☐ Expansion	System Type: I ☒ III IV V VI	☑ Residence	No. Bedrooms	3	Water Supply
Pump Tank		(gal)	PT		Date		System Description:				☐ Business	No. Persons	6	☑ Private
Pump Make		Model			Serial #		Repair System Description:	TANK			☐ Other	No. Employees		☐ Public
# Nitrification Fields	6x	# Lines	6x		Linear Ft:	6x	Maintenance Agreement Required:	☐ YES	☑ NO		☐ Slab	☑ Crawl Space		☐ Community
Trench Width	6x	Max. Trench Bottom Depth	6x		Gravel Depth	6x		☐ GRAVITY	☐ PRESSURE		☐ Basement w/plumbing		☐ Basement w/o plumbing	

Comments / Conditions: Install a new septic tank @ location shown below + connect to existing drainfield. Pump + crush existing septic tank. Install risers if septic tank is deeper than 6" below grade.

3 lines

INITIAL SITE SKETCH

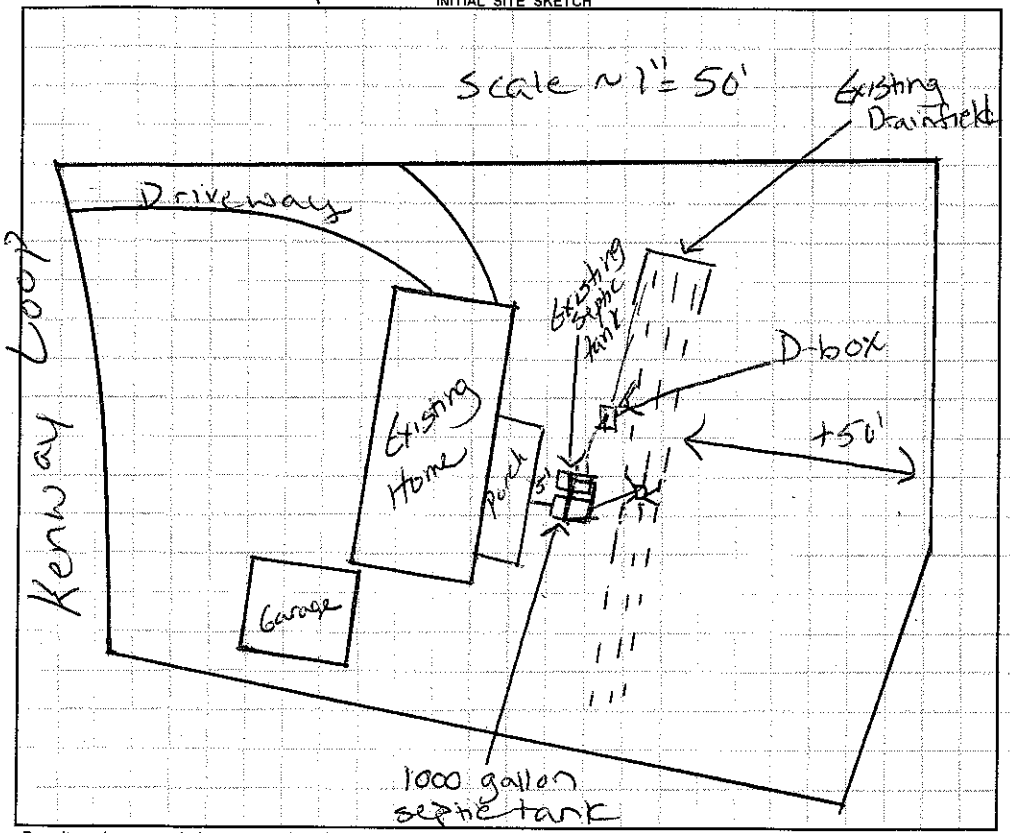

AS BUILT SKETCH

New ST 8'6" from porch

~~Pond~~

Lake

Permit can be suspended or revoked if any false information is supplied toward securing the permit / any unauthorized changes are made to the site / any unauthorized changes are made in the installation of the system. **CONTACT A LOCATOR SERVICE PRIOR TO ANY EXCAVATION**

☐ **IMPROVEMENT PERMIT** *with plat valid without expiration.* ☑ **IMPROVEMENT PERMIT** *with site plan valid for 60 mos.* ☑ **AUTHORIZATION TO CONSTRUCT** *valid for period equal to IMPROVEMENT PERMIT--not to exceed 60 mo.*

Owner / Applicant Signature: LENTZ WASTEWATER Date: 3-5-14 Installed by: Lentz Septic

IMPROVEMENT PERMIT by: Justin Henderson Date: 3-5-14 OPERATION PERMIT by: Mariah Hobson Date: 4/1/14

AUTHORIZATION TO CONSTRUCT by: Justin Henderson Date: 3-5-14 Existing System Inspected by: Date:

per Justin H. 3/5. OK for Lentz to plug per Home Owner

Health Dept. Copy - WHITE Applicant (Final Approval) - YELLOW Applicant (Conditional Approval) - PINK