203863

IREDELL COUNTY HEALTH DEPARTMENT

STATESVILLE 704-878-5305 MOORESVILLE 704-664-5281

IMPROVEMENT PERMIT / AUTHORIZATION TO CONSTRUCT / OPERATION PERMIT / EXISTING SYSTEM INSPECTION

PERMIT# 136490 PIN# 4639 42 0136 .018 4639412735 DATE August 7, 2006

OWNER OR APPLICANT Woodbridge Partners, LLC (Whitley PHONE: Business Home

ADDRESS P.O. Box 3608, Mooresville, N.C. 28117

LOCATION Perth Rd. (N) TL Ferry Hill Rd. TR Blue Ridge Trail at end

SUBDIVISION Woodleaf BLOCK / SECTION LOT 18 LOT AREA 1.47Ac SITE CLASS. PS DESIGN FLOW 440gpd L.T.A.R. .03

Septic Tank: 1000 Gallons; STB 338 Date 10-24-14

Pump Tank: Gallons; PT Date

Pump Make: Model Serial No.

Nitrification Field: No Fields 1 Square Feet 1200 Linear Feet 400

No Lines 4@100' Trench Width 36" Max Trench Bottom Depth 36" Gravel Depth N/A

☒ New System ☐ Repair ☐ Expansion, System Type: I ☐ II ☐ III IV V VI

System Description: Gravity 25% Reduction

Repair System Description: LPPPBPS

Maintenance Agreement Required: ☐ Yes ☒ No Initially

☒ House/Mod. Home ☐ Mobile Home ☐ Business ☐ Other

No. Bedrooms 4 No. Persons No. Employees

Water Supply: ☒ Individual ☐ Public ☐ Community

☒ Gravity ☐ Pressure ☐ Slab ☐ Crawl Space ☐ Basement w/plumbing ☒ Basement wo/plumbing

Comments:/Conditions:

Comments:/Conditions:

INITIAL SITE SKETCH

SEE Plan from S&ME

AS BUILT SKETCH

12/1/14 Installed Quick 4

4-lines @ 100ft ea

Serial distribution

Permit can be suspended or revoked if any false information is supplied toward securing the permit/any unauthorized changes are made to the site/any unauthorized changes are made in the installation of the system. Improvement Permit with plat valid without expiration. ☐ Improvement Permit with site plan valid for sixty months ☒ Authorization to Construct is valid for a period equal to that of Improvement Permit – not to exceed sixty months.

Signed: Kathleen Saunders date 8/11/06

Improvement Permit by: date 8-7-06


Authorization to Construct by: date 1-9-14

Installed by: Hallman Construction

Operation Permit by: date 12/1/14

Existing System Inspection by: date

HEALTH DEPT. COPY: WHITE OWNER COPY (FINAL): YELLOW OWNER COPY (INITIAL): PINK

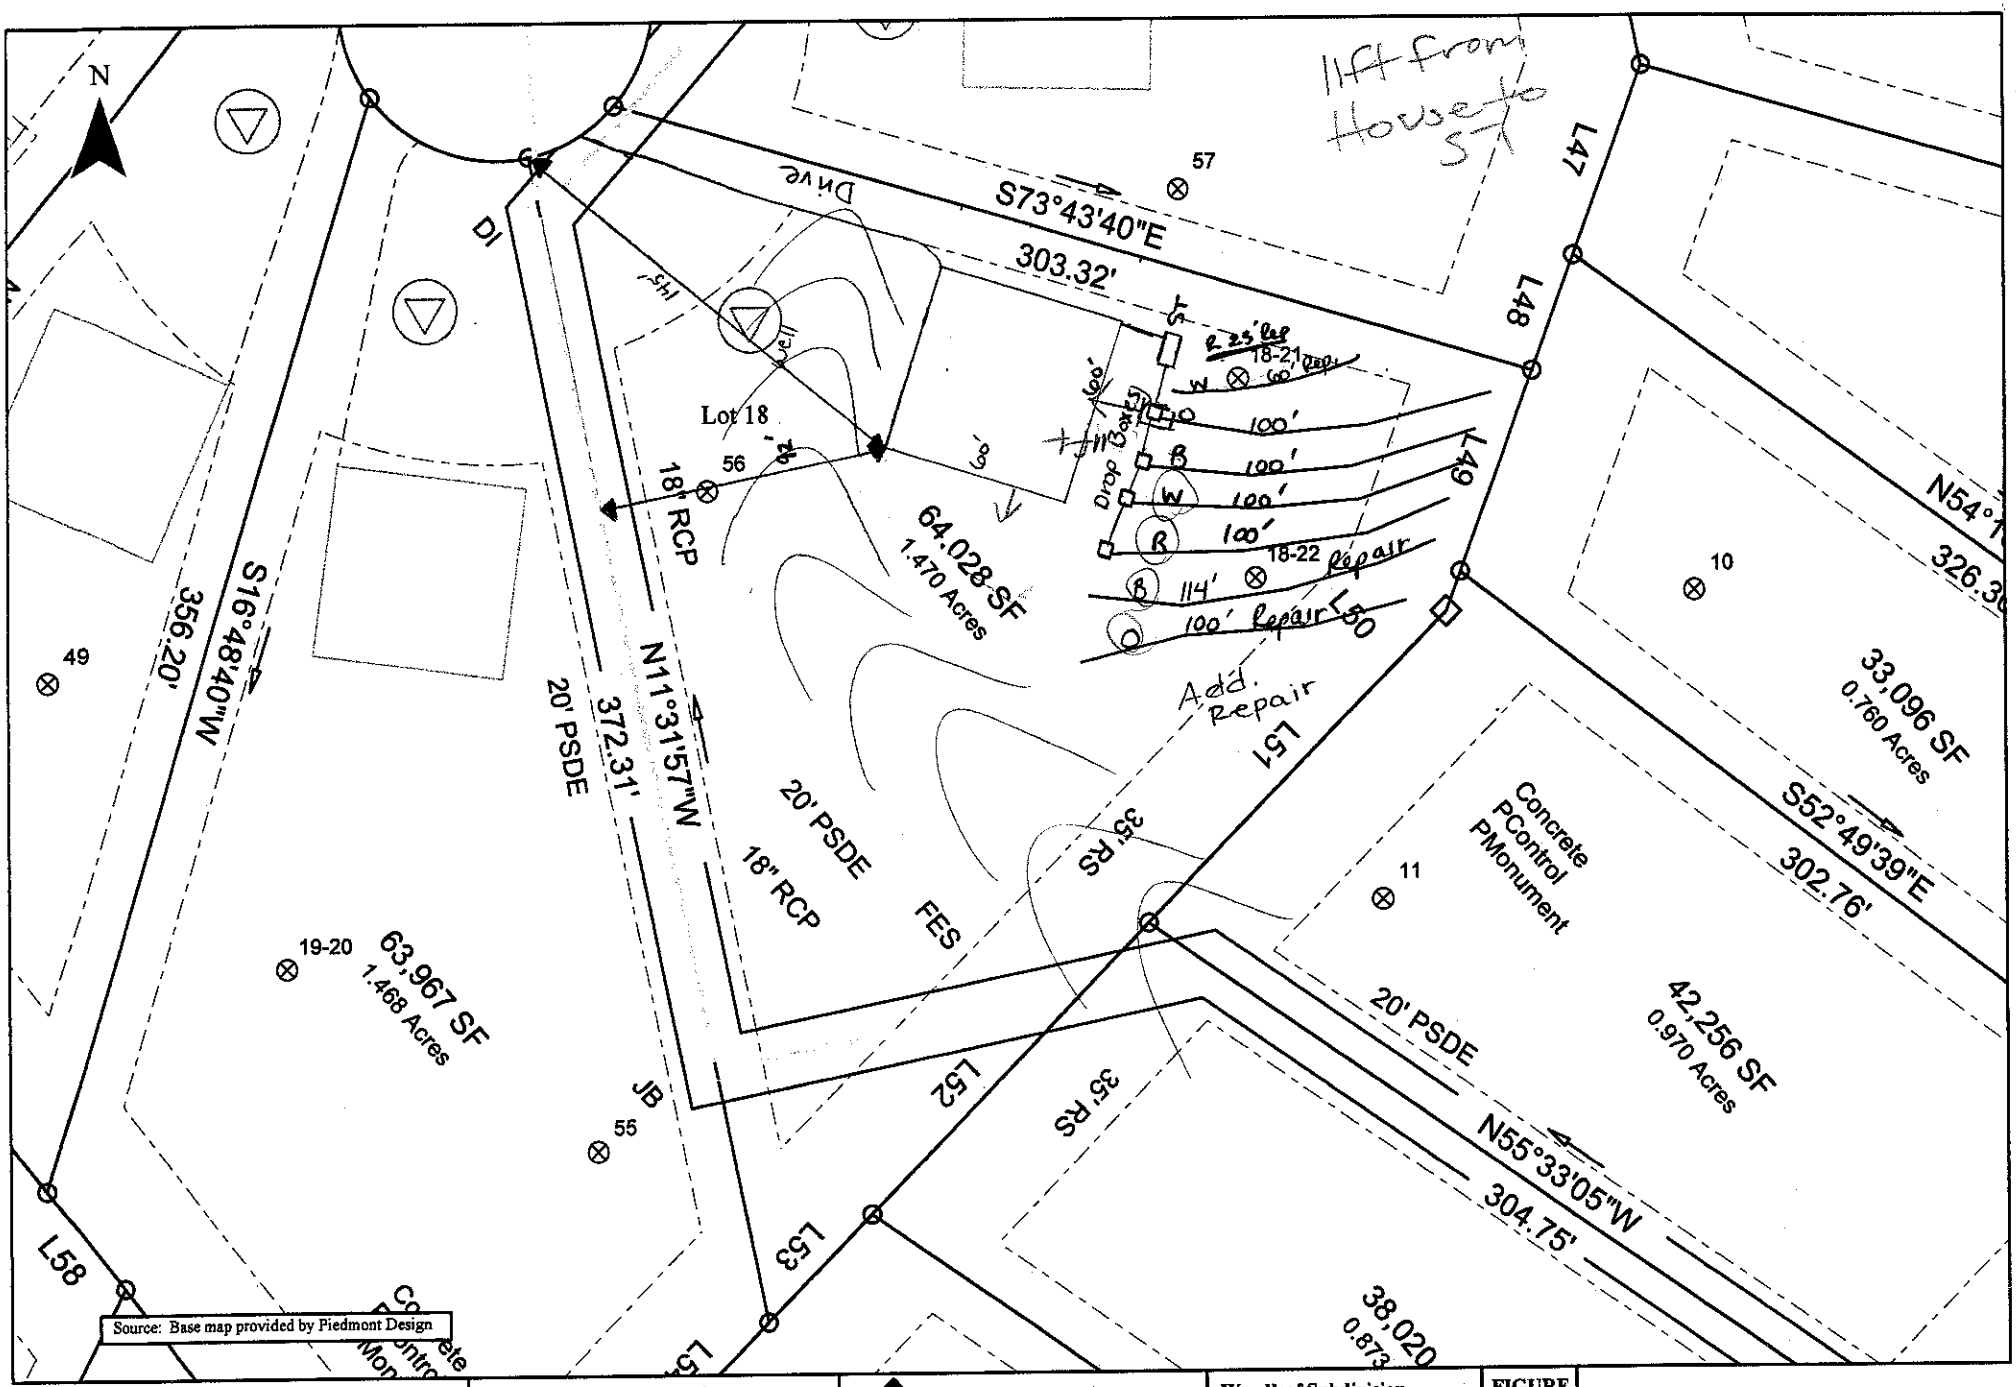

Scale: 1 inch equals 60 feet	S&ME	Woodleaf Subdivision	FIGURE
Drawn by: JBP	ENVIRONMENTAL SERVICES • ENGINEERING • TESTING	Lot 18 Septic Lines	1
Reviewed by: PGP		Iredell County, NC	
Date: July, 2006		S&ME Project #1588-05-121	