IREDELL COUNTY HEALTH DEPARTMENT - *ENVIRONMENTAL HEALTH* ☐ STATESVILLE OFFICE 704-878-5305 ☒ MOORESVILLE OFFICE 704-664-5281

IMPROVEMENT PERMIT / AUTHORIZATION TO CONSTRUCT / OPERATION PERMIT / EXISTING SYSTEM INSPECTION

PERMIT # REPAIR PIN # 4639-41-5251 DATE 5-28-12

OWNER MOREY HERENDEEN APPLICANT: SAME PHONE: Home/Cell # 704-622-3883 Business #

SITE ADDRESS 251 KENWAY LP OWNER / APPLICANT ADDRESS SAME

SITE DIRECTIONS PERTH, FERNHILL, KENWAY, ON L

SUBDIVISION CLET BLOCK / SECTION 15 LOT # 5 LOT AREA .87 AC DESIGN FLOW 360 L.T.A.R. .3

Septic Tank EXISTING Gallons: STB Date

Pump Tank Gallons: P T Date

Pump Make Model Serial #

No. Nitrification Fields: 1 No. Lines 2 Linear Feet 100'

Trench Width 36" Max. Trench Bottom Depth 36" Gravel Depth —

☐ New System ☐ Repair ☒ Expansion System Type I II (III) IV V VI

System Description: GRAVITY 25%

Repair System Description: SHALLOW 25%

Maintenance Agreement Required ☐ YES ☒ NO

☐ GRAVITY ☐ PRESSURE


☐ Residence No. Bedrooms 3 ☐ Business No. Persons ☐ Other No. Employees ☐ Slab ☐ Crawl Space ☒ Basement w/plumbing ☐ Basement w/o plumbing

Water Supply: ☒ Private ☐ Public ☐ Community


Comments / Conditions ① INSTALL NEW D-BOX ② OWNER WANTS TO ADD LINE BUT NO EXPANSION OF BEDROOMS ③ REPAIR SHOWN FOR NEW LINES ④ KEEP LINES 10' FROM HOUSE

T FEEDS GRAVEL BED FIRST THEN 2 NEW LINES.

INITIAL SITE SKETCH

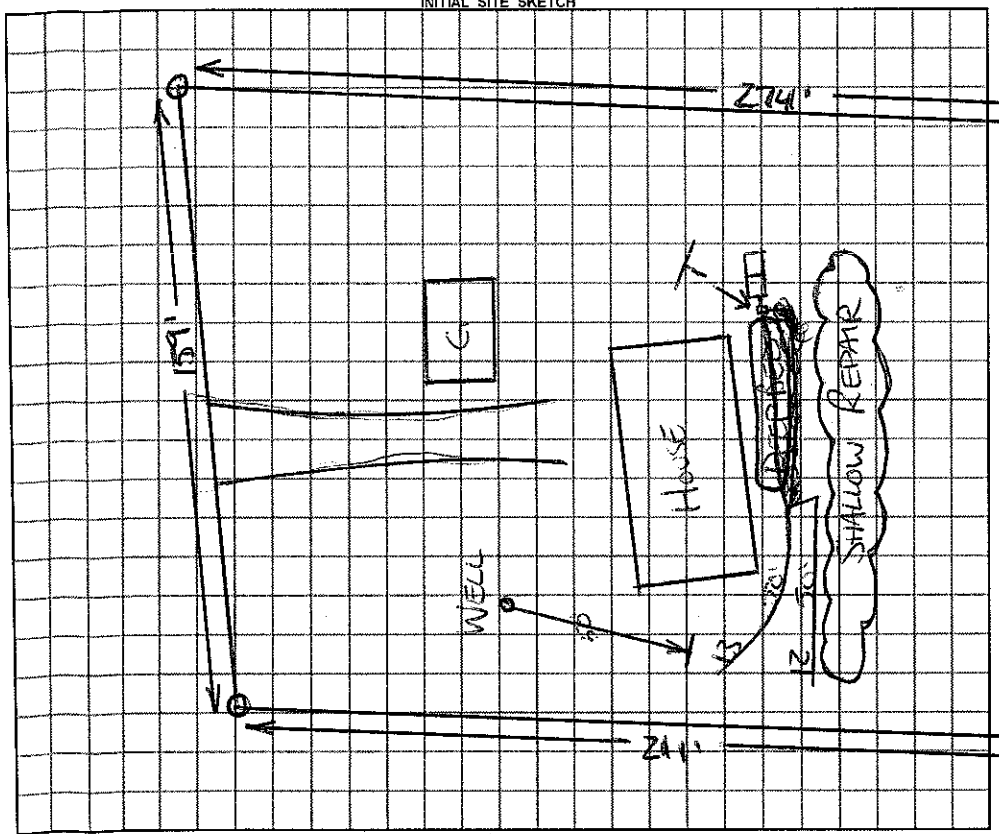

AS BUILT SKETCH

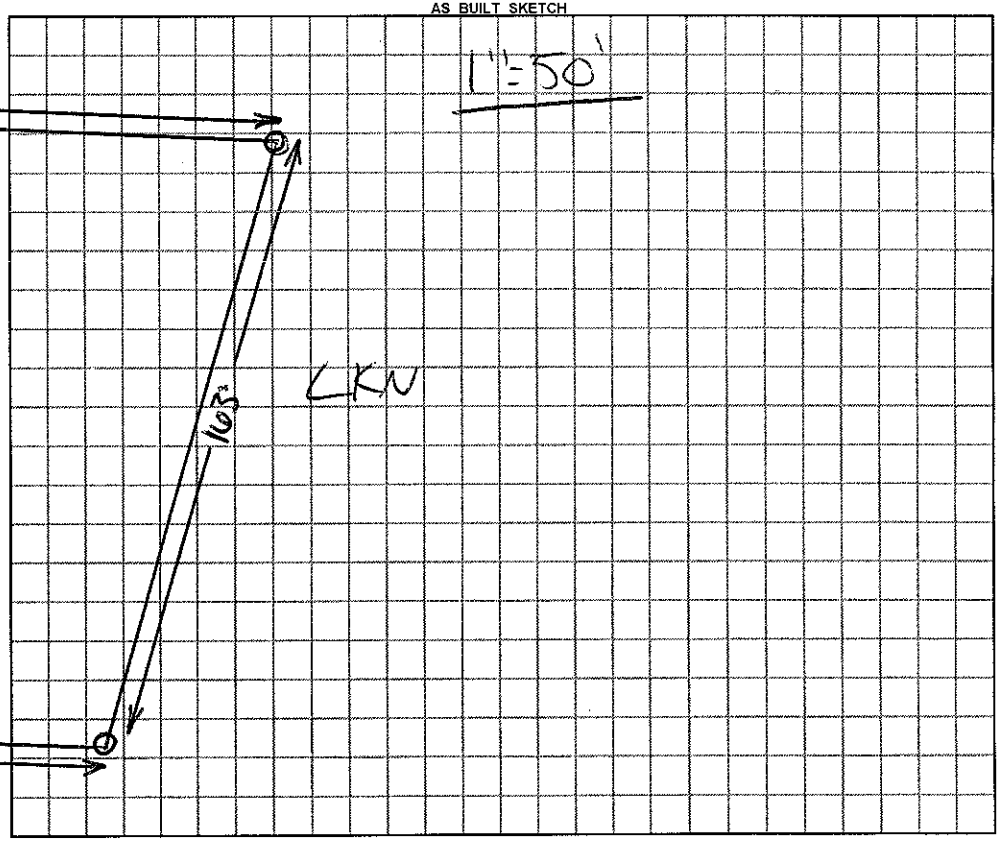

Permit can be suspended or revoked if any false information is supplied toward securing the permit / any unauthorized changes are made to the site / any unauthorized changes are made in the installation of the system.

☐ ***IMPROVEMENT PERMIT*** with plat valid without expiration. ☐ ***IMPROVEMENT PERMIT*** with plat valid without expiration. site plan valid 60 mo. ☒ ***AUTHORIZATION TO CONSTRUCT*** valid for period equal to IMPROVEMENT PERMIT--not to exceed 60 mo.

Owner / Applicant Signature: Date Installed by: WASTEWATER SOLUTIONS

IMPROVEMENT PERMIT by: REHS Date 5-28-12 OPERATION PERMIT by: REHS Date 10-4-12

AUTHORIZATION TO CONSTRUCT by: REHS Date 5-28-12 Existing System Inspected by: REHS Date

YOU SHOULD CONTACT A LOCATOR SERVICE PRIOR TO ANY EXCAVATION

White Copy – Environmental Health YELLOW COPY (Final) Owner / Applicant PINK COPY (Initial) Owner / Applicant