4639-41-7466

IREDELL COUNTY HEALTH DEPARTMENT

STATESVILLE 704-878-5305 MOORESVILLE 704-664-5281

IMPROVEMENT PERMIT / CERTIFICATE OF COMPLETION / OPERATION PERMIT / EXISTING SYSTEM INSPECTION

PROPERTY DESCRIPTION NO. 16837 DATE 8/24/93 TAX MAP NO. 25 5 A 3

OWNER OR CONTRACTOR Steve T Williams PHONE: Business Home 872-3203

ADDRESS Rt 3 Box 572 Troutman, NC.

LOCATION Kenway Loop 1st entrance, to 5th house on (L)

SUBDIVISION CL&T 1 BLOCK / SECTION 315 LOT ~~53~~ AWS LOT AREA SITE CLASS. P L.T.A.R. .3 - .35

Water Supply: ☑ Individual ☐ Community ☐ Public

Septic Tank: 1000 Gallons; STB 358 Date 12/8/93

Pump Tank: Gallons; PT Date

Nitrification Field: No Fields 1 Square Feet 375 Linear Feet 360

No Lines 3 Trench Width 3 Trench Depth 3' Gravel Depth 12"

☑ New System ☐ Repair System Type: I (II) III, IV, V, VI

System Description: CONV.

Repair System Description:

Maintenance Agreement Required: ☐ Yes ☑ No

☑ House/Mod. Home No. Bedrooms 3 Garbage Disposal: ☐ Yes ☑ No

☐ Mobile Home No. Bathrooms 2 Auto. Dishwasher: ☑ Yes ☐ No


☐ Business No. Employees Auto. Washing Machine: ☑ Yes ☐ No

☐ Other Other


☐ Slab ☑ Crawl Space ☐ Basement w/plumbing ☐ Basement wo/plumbing

Comments Keep trenches shallower than 36" to trench bottom. Lines on slope contour.

INITIAL SITE SKETCH

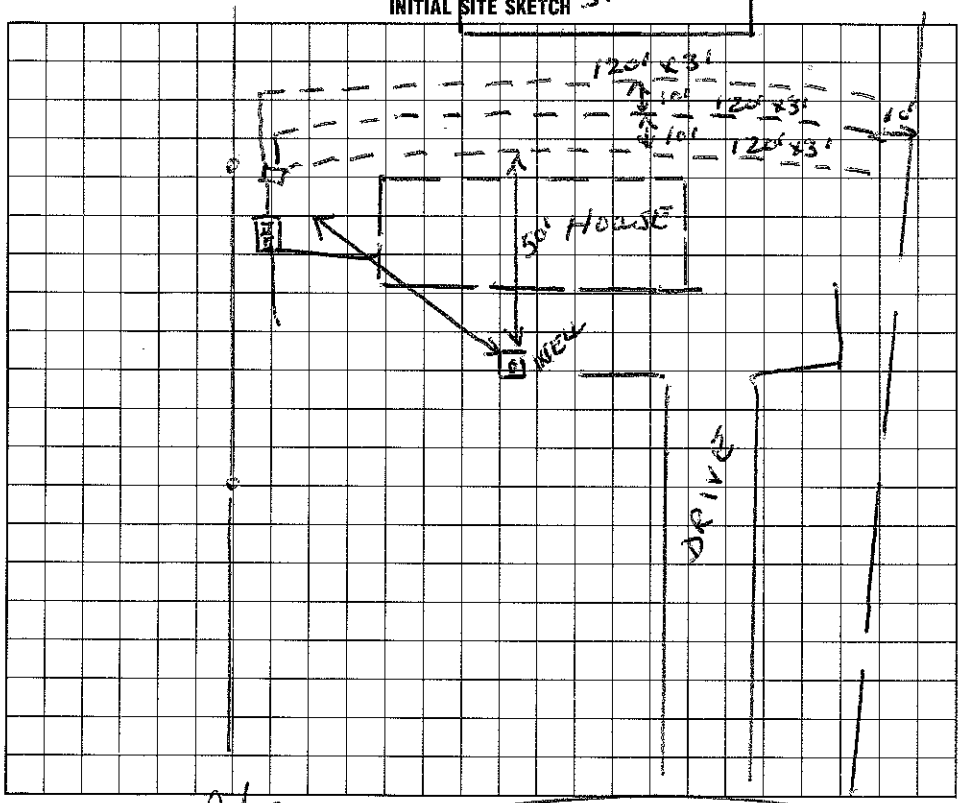

AS BUILT SKETCH

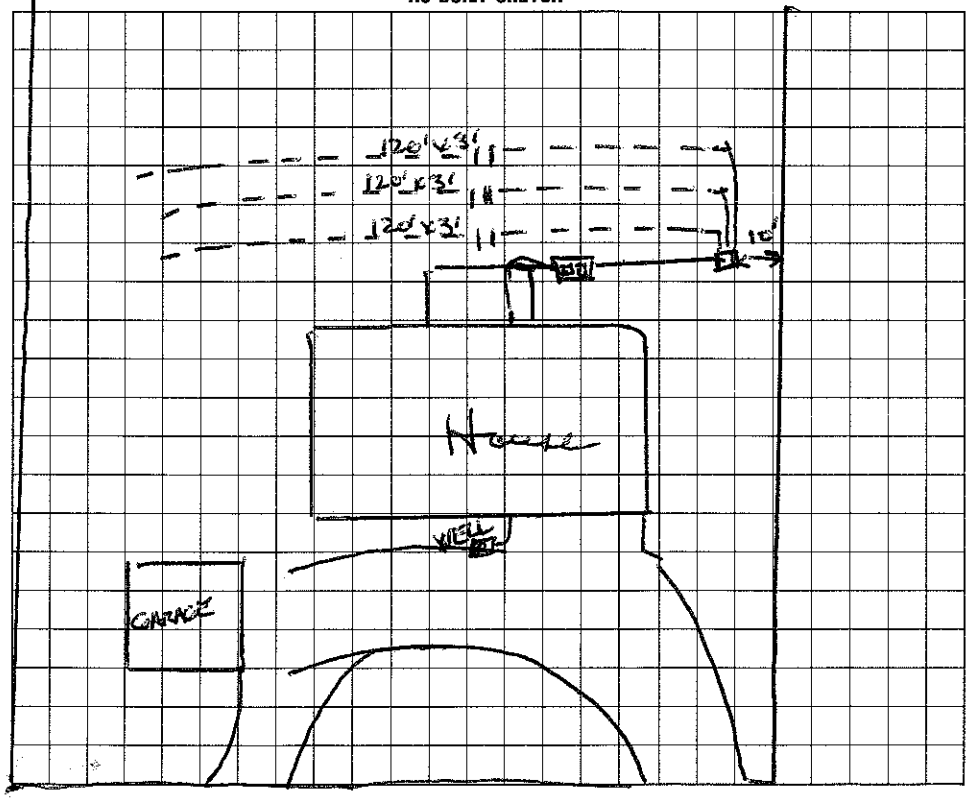

I understand that this permit can be suspended or revoked if any false information is supplied toward securing the permit/any unauthorized changes are made to the site/any unauthorized changes are made in the installation of the system. Improvement Permit is valid for 60 months from date of issuance.

Signed:

Improvement Permit by: Wesley Sparks RS. date 8/24/93

Existing System Inspection by: date

Installed by: FJ Erwin KENWAY LOOP

Certificate of Completion by: Wesley Sparks RS. date 3/18/94

Operation Permit by: date

HEALTH DEPT. COPY: WHITE INSPECTION COPY (FINAL): GREEN OWNER COPY (FINAL): YELLOW INSPECTION COPY (INITIAL): PINK OWNER COPY (INITIAL): GOLD