IREDELL COUNTY HEALTH DEPARTMENT

Statesville Office (704) ~~878-5305~~ Mooresville Office (704) 660-3625 PERMIT # 179579

IMPROVEMENT PERMIT / AUTHORIZATION TO CONSTRUCT / OPERATION PERMIT / EXISTING SYSTEM

PIN # 4639418538

APPLICANT: Robert Edwards APPLICANT ADDRESS: 4920 Wherry Ln Catawba NC 28609

SITE ADDRESS: 235 Kenway Lp, Mooresville, NC 28117 PHONE: 828 241-3451 ALT. PHONE: 704 252-0555

SITE DIRECTIONS: Hwy 150 West TR Perth Rd TL Fern Hill Rd TL 1st Kenway Lp on left #235

SUBDIVISION: Lot 1 SECTION: 15 LOT # 2 LOT AREA: .78 Acres DESIGN FLOW: 360gpd L.T.A.R.:

Existing

Septic Tank 1000 (gal) STB Date
Pump Tank (gal) PT Date
Pump Make Model Serial #
Nitrification Fields 1 # Lines 3 Linear Ft: 225'
Existing Trench Width Bed 8ft Max. Trench Bottom Depth Gravel Depth ~12"

☐ New System ☐ Repair ☐ Expansion System Type: I II III IV V VI
System Description: Existing Gravity Conventional
Repair System Description: Pre 1983
Maintenance Agreement Required: ☐ YES ☒ NO
☒ GRAVITY ☐ PRESSURE

☒ Residence ☐ Business ☐ Other ☐ Slab ☐ Basement w/plumbing
No. Bedrooms 3 No. Persons No. Employees ☒ Crawl Space ☐ Basement w/o plumbing


Water Supply: ☒ Private ☐ Public ☐ Community

Comments / Conditions:

Existing Septic System appears to be functioning okay at time of inspection.
* MUST KEEP new House at least 5ft from Septic System.

INITIAL SITE SKETCH

AS BUILT SKETCH

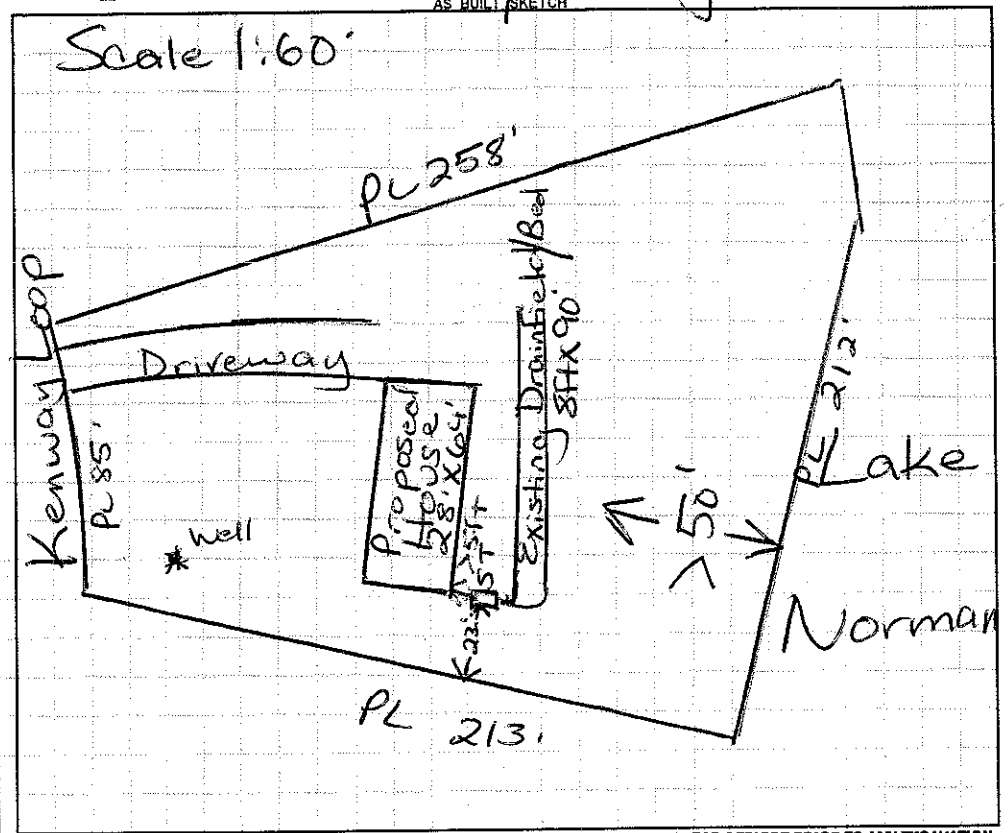

Permit can be suspended or revoked if any false information is supplied toward securing the permit / any unauthorized changes are made to the site / any unauthorized changes are made in the installation of the system. **CONTACT A LOCATOR SERVICE PRIOR TO ANY EXCAVATION**

☐ **IMPROVEMENT PERMIT** ~~*with plat*~~ *valid without expiration.* ☐ **IMPROVEMENT PERMIT** *with site plan valid for 60 mos.* ☐ **AUTHORIZATION TO CONSTRUCT** *valid for period equal to IMPROVEMENT PERMIT--not to exceed 60 mo.*

Owner / Applicant Signature: ~~X~~ R Edwards BY RG Date: 8-15-13 Installed by:

IMPROVEMENT PERMIT by: Date: OPERATION PERMIT by: Date:

AUTHORIZATION TO CONSTRUCT by: Date: Existing System Inspected by: RS Date: 8/15/13

Health Dept. Copy - WHITE Applicant (Final Approval) - YELLOW Applicant (Conditional Approval) - PINK