IREDELL COUNTY HEALTH DEPARTMENT

STATESVILLE 704-878-5305 MOORESVILLE 704-664-5281

IMPROVEMENT PERMIT / AUTHORIZATION TO CONSTRUCT / OPERATION PERMIT / EXISTING SYSTEM INSPECTION

PERMIT# 136486 PIN# 4639-42-0136.015 4639-42-1130 DATE August 4, 2006

OWNER OR APPLICANT Woodbridge Partners / TOP NOTCH PHONE: Business _____ Home _____

ADDRESS P.O. Box 3608, Mooresville, N.C. 28117

LOCATION Pearl Rd. (N) TL Fern Hill TL Blue Ridge Trail 1st lot on left

SUBDIVISION Woodlea BLOCK / SECTION _____ LOT 15 LOT AREA 1.052Ac SITE CLASS. PS DESIGN FLOW 480gpd L.T.A.R. .025

Septic Tank: 1000 Gallons; STB 160 Date 10/30/07

Pump Tank: _____ Gallons; PT _____ Date _____

Pump Make: _____ Model _____ Serial No. _____

Nitrification Field: No Fields 1 Square Feet 1440 Linear Feet 480

No Lines 5 Trench Width 36" Max Trench Bottom Depth 24"

☒ New System ☐ Repair ☐ Expansion System Type: I II III IV V VI

System Description: Gravity 25% Reduction LPP/BS

Repair System Description: _____

Maintenance Agreement Required: ☐ Yes ☒ No Initially

Gravel Depth NA ☒ Gravity ☐ Pressure ☐ Slab ☒ Crawl Space ☐ Basement w/plumbing ☐ Basement wo/plumbing

☒ House/Mod. Home No. Bedrooms 4

☐ Mobile Home No. Persons _____

☐ Business No. Employees _____

☐ Other _____

Water Supply: ☒ Individual ☐ Public ☐ Community

Comments:/Conditions:

Comments:/Conditions:

Bonus room doorway has been cased 6/3/08


Tank & Drainlines checked 1/14/08

INITIAL SITE SKETCH

SEE PLAN from S&ME

NEW PERMIT PLAN 6-21-06 SA

AS BUILT SKETCH

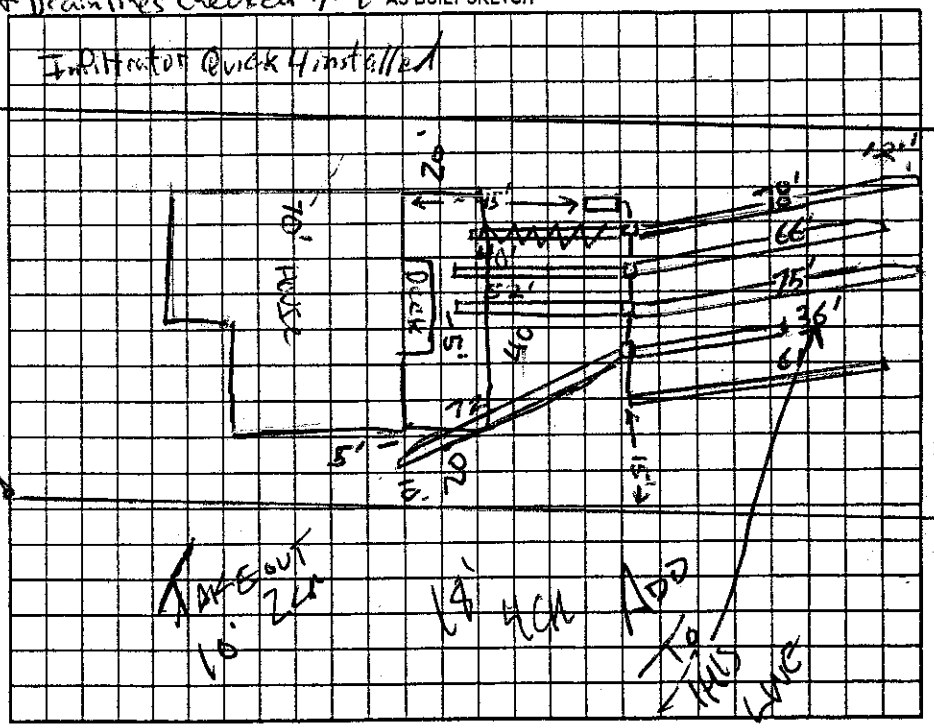

Permit can be suspended or revoked if any false information is supplied toward securing the permit/any unauthorized changes are made to the site/any unauthorized changes are made in the installation of the system. Improvement Permit with plat valid without expiration ☐ Improvement Permit with site plan valid for sixty months ☒ Authorization to Construct is valid for a period equal to that of Improvement Permit – not to exceed sixty months.

Signed: Kathleen Saunders date 8/11/06

Improvement Permit by: _____ date 8-4-06

Authorization to Construct by: _____ date 2/22/07

Installed by: Gary Leatherman

Operation Permit by: Anthony Coker Jr. date 6/2/08

Existing System Inspection by: _____ date _____

HEALTH DEPT. COPY: WHITE OWNER COPY (FINAL): YELLOW OWNER COPY (INITIAL): PINK