11/10

IREDELL COUNTY HEALTH DEPARTMENT - *ENVIRONMENTAL HEALTH* ☐ STATESVILLE OFFICE 704-878-5305 ☐ MOORESVILLE OFFICE 704-664-5281

IMPROVEMENT PERMIT / AUTHORIZATION TO CONSTRUCT / OPERATION PERMIT / EXISTING SYSTEM INSPECTION

PERMIT # 35450 PIN # 4639209711 4639422731 DATE 3-26-2012

OWNER LWHB Inc. APPLICANT: LWHB PHONE: Home/Cell # 704 309-430 Business #

SITE ADDRESS Kenway Lp OWNER / APPLICANT ADDRESS P.O. Box 4301 Mooresville NC

SITE DIRECTIONS Hwy 150 W, R Peeth Rd TL Fern Hill TL 1st Kenway Lp on right

SUBDIVISION Woodleaf BLOCK / SECTION LOT # 33 LOT AREA .65Acs DESIGN FLOW 360 gpd L.T.A.R. .3

Septic Tank 1000 Gallons: STB 794 Date 9-13-12 ☒ New System ☐ Repair ☐ Expansion System Type I II III IV V VI

Pump Tank 1000 Gallons: PT 37 Date 9-3-12 System Description: Pump-PM-25% Reduction

Pump Make Zoeller Model PES1/V4 Serial # Repair System Description: Pump 25%-50% Reduction

No. Nitrification Fields: 1 No. Lines 4 Linear Feet 300ft Maintenance Agreement Required ☐ YES ☒ NO

Trench Width 36" Max. Trench Bottom Depth 36" Gravel Depth N/A ☐ GRAVITY ☒ PRESSURE

☒ Residence No. Bedrooms 3 ☐ Business No. Persons ☐ Other No. Employees ☐ Slab ☒ Crawl Space ☐ Basement w/plumbing ☐ Basement w/o plumbing


Water Supply: ☒ Private ☐ Public ☐ Community

Comments / Conditions


ARC Se Installed

This permit replaces previous permit from 6/7/2006
OK to do 3 lines @ 100ft ea.
Tanks & lines checked by BA
2ft pressure set 10/31/12

INITIAL SITE SKETCH

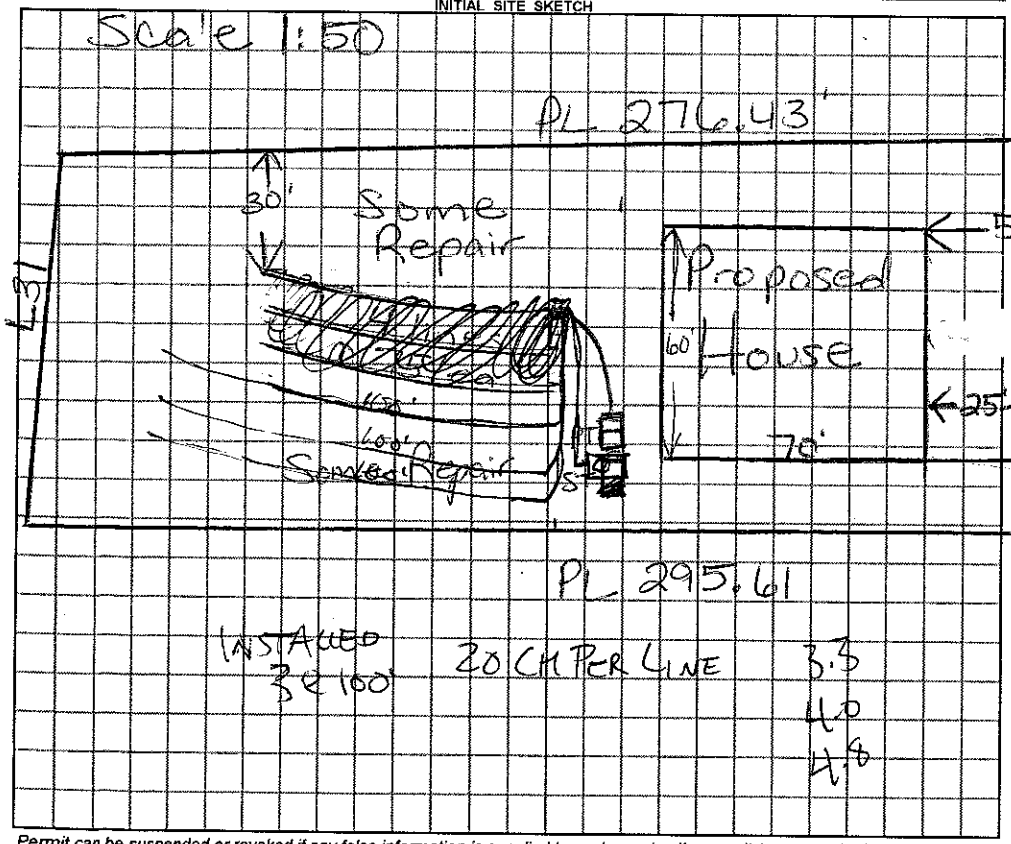

AS BUILT SKETCH

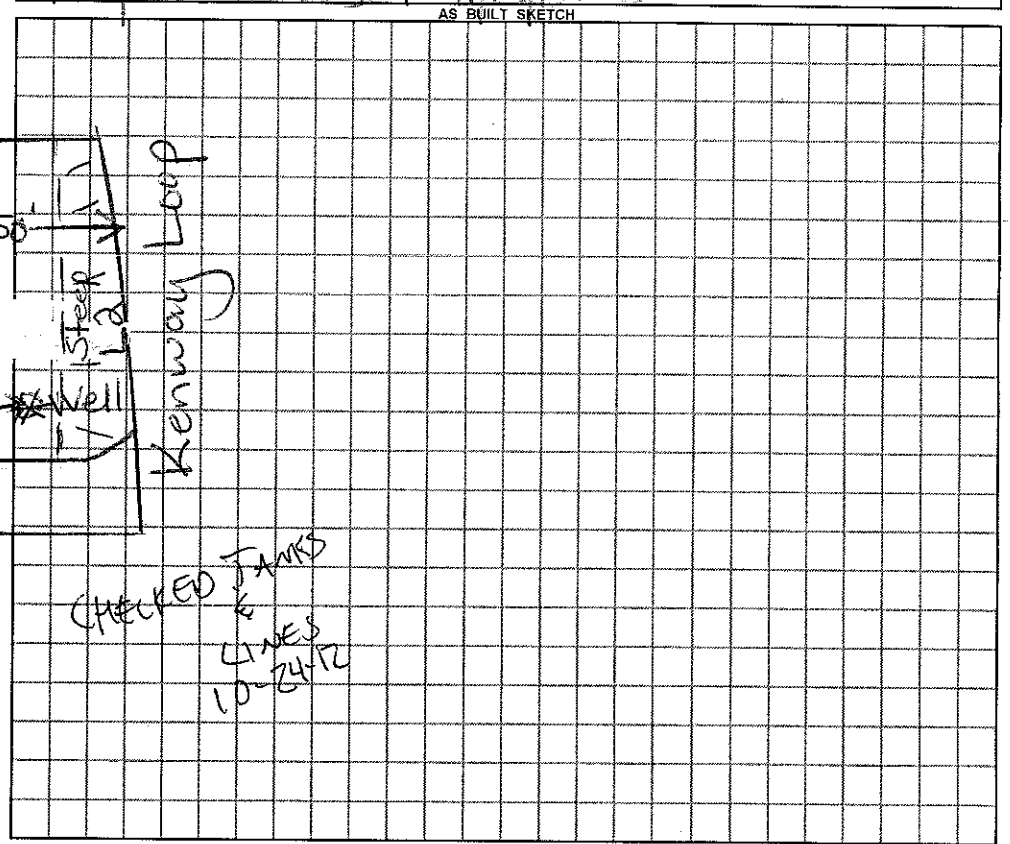

Permit can be suspended or revoked if any false information is supplied toward securing the permit / any unauthorized changes are made to the site / any unauthorized changes are made in the installation of the system.

☐ ***IMPROVEMENT PERMIT*** with plat valid without expiration. ☐ ***IMPROVEMENT PERMIT*** with plat valid without expiration. site plan valid 5 years ☐ ***AUTHORIZATION TO CONSTRUCT*** valid for period equal to IMPROVEMENT PERMIT--not to exceed 60 mo.

Owner / Applicant Signature: Date 3/29/12 Installed by: ABERNATHY

IMPROVEMENT PERMIT by: REHS Date 3/26/2012 OPERATION PERMIT by: REHS Date 11/13/2012

AUTHORIZATION TO CONSTRUCT by: REHS Date 3/26/2012 Existing System Inspected by: REHS Date

YOU SHOULD CONTACT A LOCATOR SERVICE PRIOR TO ANY EXCAVATION

White Copy – Environmental Health YELLOW COPY (Final) Owner / Applicant PINK COPY (Initial) Owner / Applicant