37 ~ 4/06

REDELL COUNTY HEALTH DEPARTMENT

STATESVILLE 704-878-5305 MOORESVILLE 704-664-5281

IMPROVEMENT PERMIT / AUTHORIZATION TO CONSTRUCT / OPERATION PERMIT / EXISTING SYSTEM INSPECTION

PERMIT# 13545 PIN# 4639 20 97 11.037 4639425435 DATE June 7, 2006

OWNER OR APPLICANT c/o Woodridge Partners LLC/Northlake Homes PHONE Business Home

ADDRESS P.O. Box 3608, Mooresville, N.C. 28117

LOCATION Perth Rd. (W) TL FERN Hill RD. TL Kenway Loop on Right

SUBDIVISION Woodleaf BLOCK / SECTION LOT 37 LOT AREA ±7.95 Ac SITE CLASS. PS DESIGN FLOW 480gpd L.T.A.R. .03

Septic Tank: 1000 Gallons: STB 794 Date 5-21-07

Pump Tank: 1000 Gallons: PT 283 Date 5-28-07

Pump Make: Gould's Model WE0.5J2 Serial No.

Nitrification Field: No Fields 1 Square Feet 1200 Linear Feet 400

No. Lines 3 Trench Width 36" Max Trench Bottom Depth 36" Gravel Depth 11A ☐ Gravity ☒ Pressure ☐ Slab ☒ Crawl Space ☐ Basement w/plumbing ☐ Basement wo/plumbing

☒ New System ☐ Repair ☐ Expansion System Type: I II III IV V VI

System Description: Pur 25% Reduction

Repair System Description: LPPPBPS

Maintenance Agreement Required: ☐ Yes ☒ No Initially

☒ House/Mod. Home No. Bedrooms 4

☐ Mobile Home No. Persons

☐ Business No. Employees

☐ Other

Water Supply: ☒ Individual ☐ Public ☐ Community

Comments:/Conditions:

Comments:/Conditions: 7/9/07 Checked tanks & lines

INITIAL SITE SKETCH

SEE Plan from State

AS BUILT SKETCH

Installed Quick 4 as Drawn


Permit can be suspended or revoked if any false information is supplied toward securing the permit/any unauthorized changes are made to the site/any unauthorized changes are made in the installation of the system. Improvement Permit with plat valid without expiration ☐ Improvement Permit with site plan valid for sixty months ☒ Authorization to Construct is valid for a period equal to that of Improvement Permit – not to exceed sixty months.

Signed: [signature] date 6-20-06 Installed by: R & H

Improvement Permit by: [signature] date 6-7-06 Operation Permit by: [signature] date 7/24/07

Authorization to Construct by: [signature] date 1/10/07 Existing System Inspection by: date

HEALTH DEPT. COPY: WHITE OWNER COPY (FINAL): YELLOW OWNER COPY (INITIAL): PINK

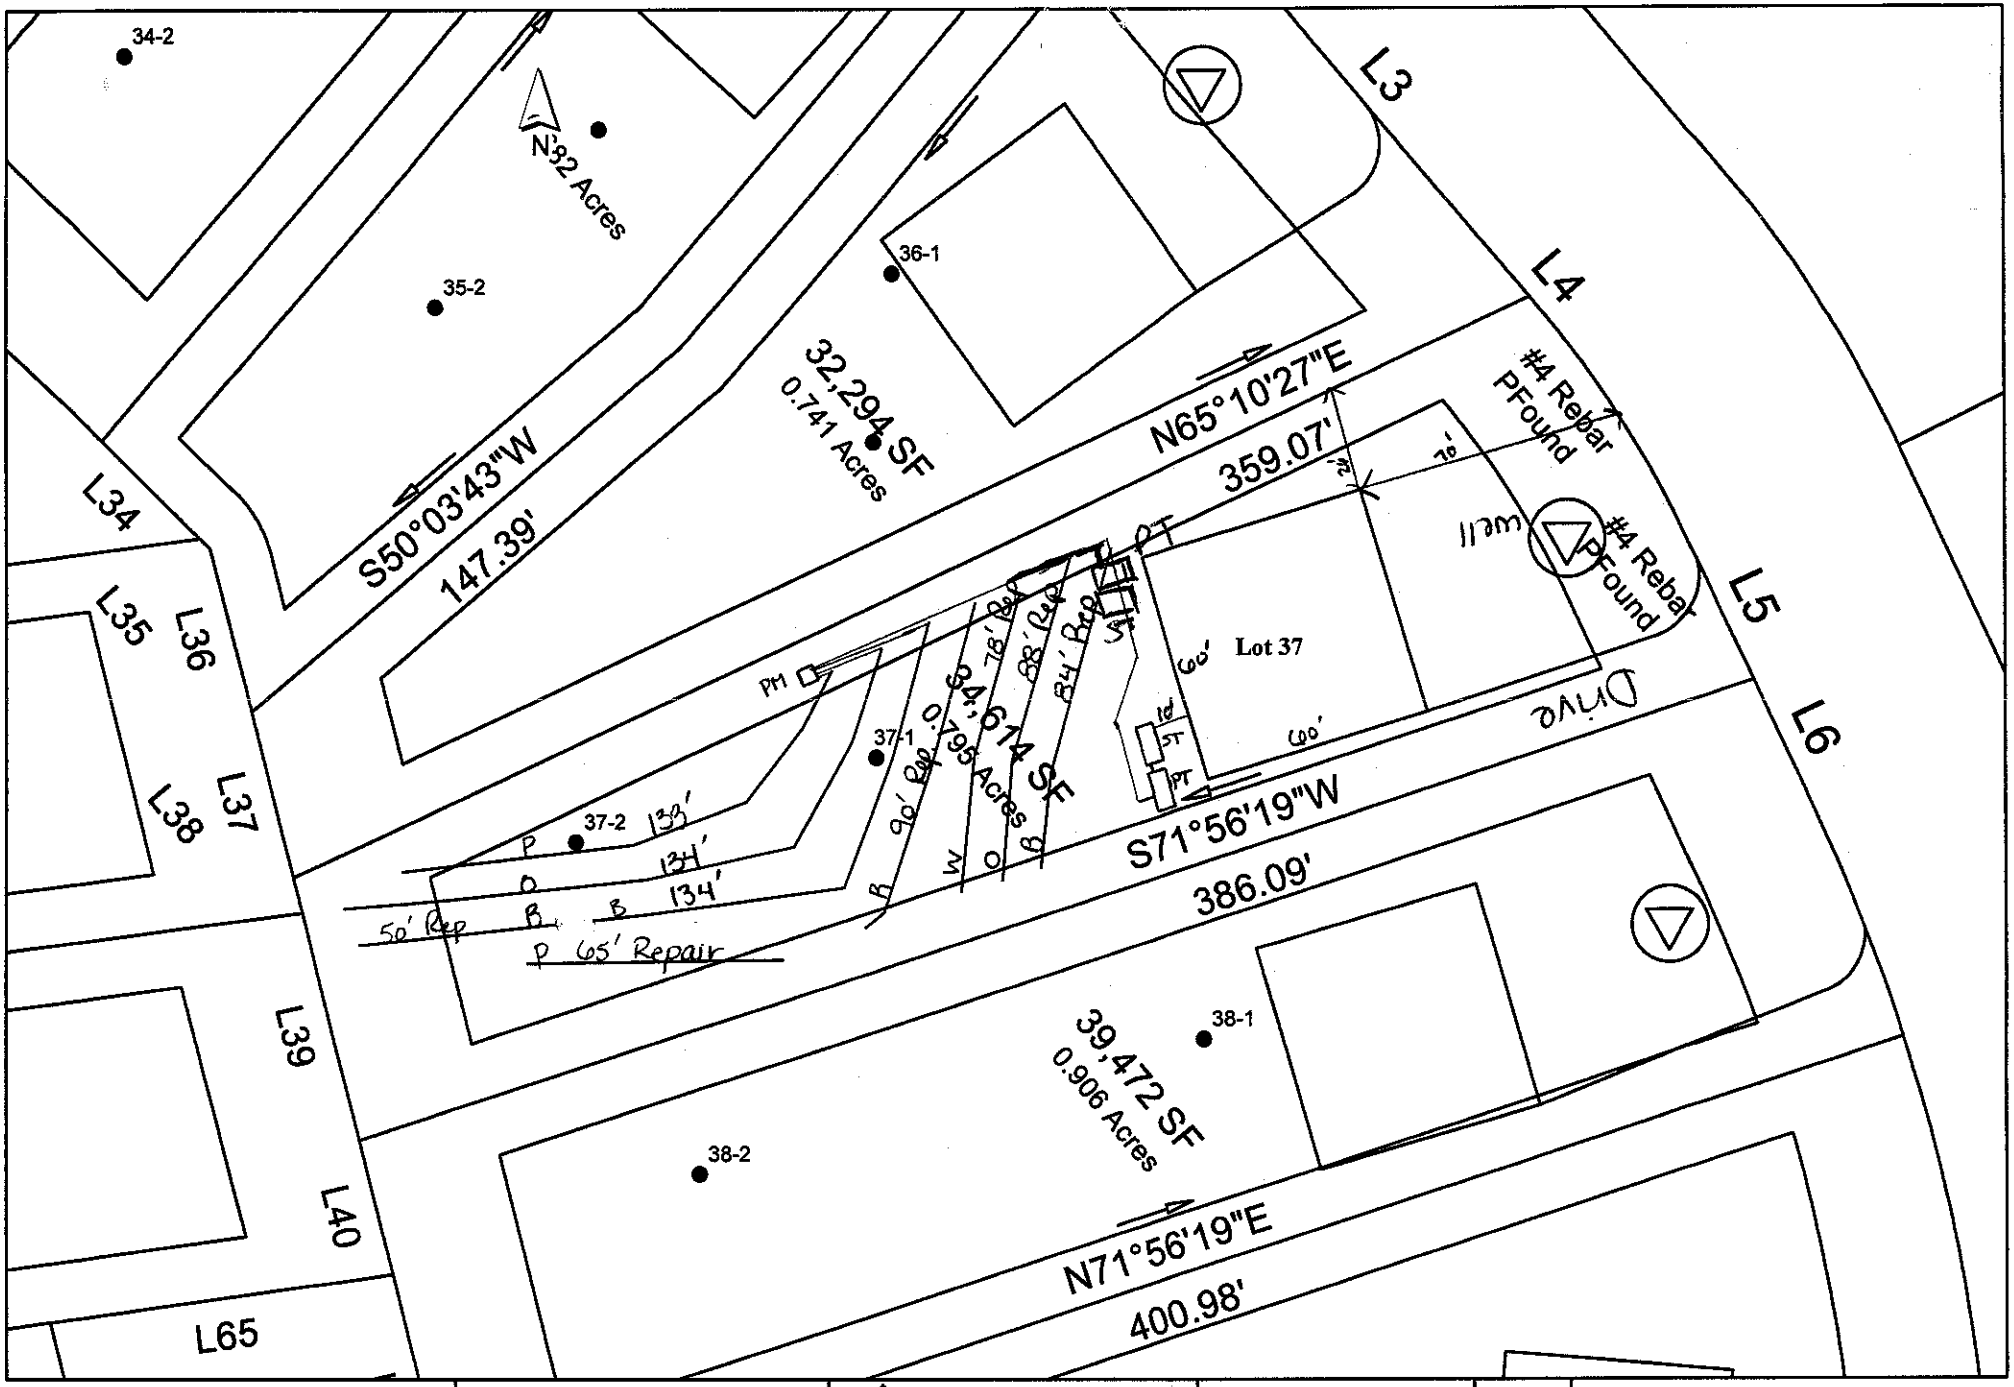

Scale: 1 inch equals 50 feet	S&ME	Woodleaf - Phase I	FIGURE
Drawn by: JBP		Lot 37	1
Reviewed by: PGP		Iredell County, NC	
Date: May, 2006	ENVIRONMENTAL SERVICES • ENGINEERING • TESTING	S&ME Project #1588-05-121	