IREDELL COUNTY HEALTH DEPARTMENT

STATESVILLE 704-878-5305 MOORESVILLE 704-664-5281

IMPROVEMENT PERMIT / AUTHORIZATION TO CONSTRUCT / OPERATION PERMIT / EXISTING SYSTEM INSPECTION

PERMIT# 092-432 / 126969 PIN# 4639 73 4457 (pt) 4639425990 DATE Dec 21, 00

OWNER OR CONTRACTOR Crescent Resources Inc. / DAVID DeWDY PHONE: Business 663-6905 Home

ADDRESS P.O. Box 103 Charlotte N.C. 28201

LOCATION 1500 ± TR Peeth Rd. TL Fern Hill TL Kenway Loop ~1/4 mile on left

SUBDIVISION Wildwood Cove BLOCK / SECTION LOT 43 LOT AREA 39,082 sf SITE CLASS. PS DESIGN FLOW 480gpd L.T.A.R. .03+

Septic Tank: 1000 Gallons; STB 825 Date 5/26/05

Pump Tank: Gallons; PT Date

Pump Make: Model Serial No.

Nitrification Field: No Fields 1 Square Feet 1170 Linear Feet 390

No Lines 3@130' Trench Width 36" Max Trench Bottom Depth 36"

☑ New System ☐ Repair System Type: I, II, III, IV, V, VI

System Description: Gravity Innovative - 25% Red

Repair System Description: SAME

Maintenance Agreement Required: ☐ Yes ☑ No

Gravel Depth N/A

☑ House/Mod. Home No. Bedrooms 4/4

☐ Mobile Home No. Bathrooms

☐ Business No. Employees

☐ Other

☐ Slab ☑ Crawl Space ☐ Basement w/plumbing ☐ Basement wo/plumbing


Water Supply: ☑ Individual ☐ Public ☐ Community

Comments:/Conditions:


Comments:/Conditions:

1"=50'

INITIAL SITE SKETCH

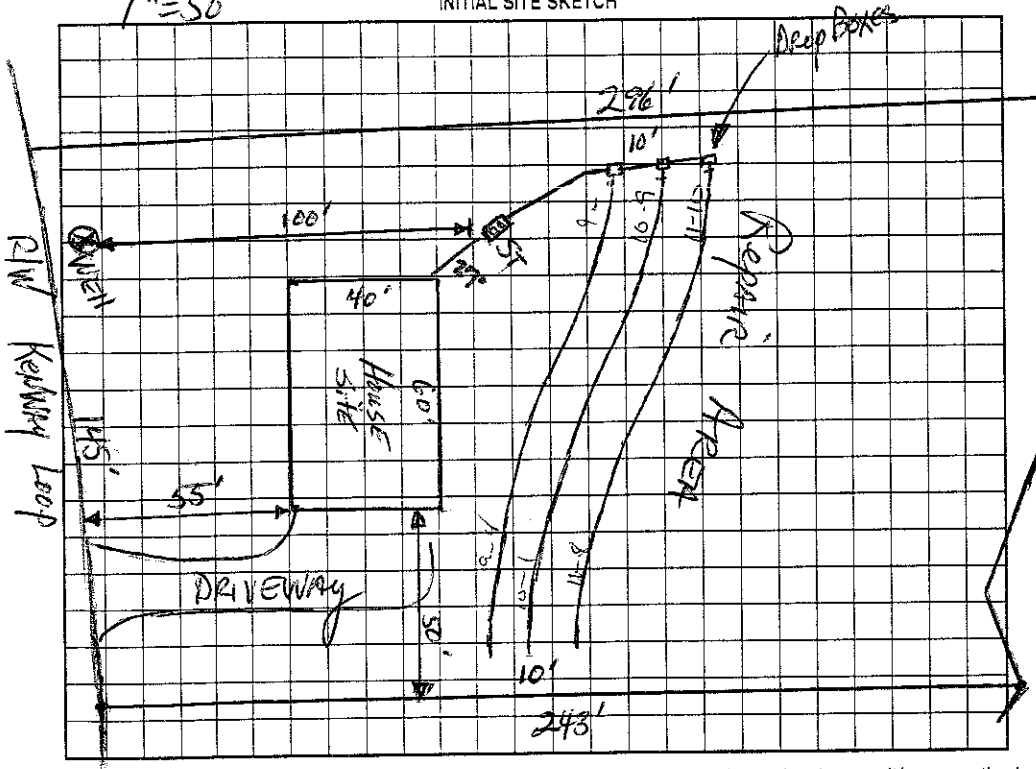

AS BUILT SKETCH

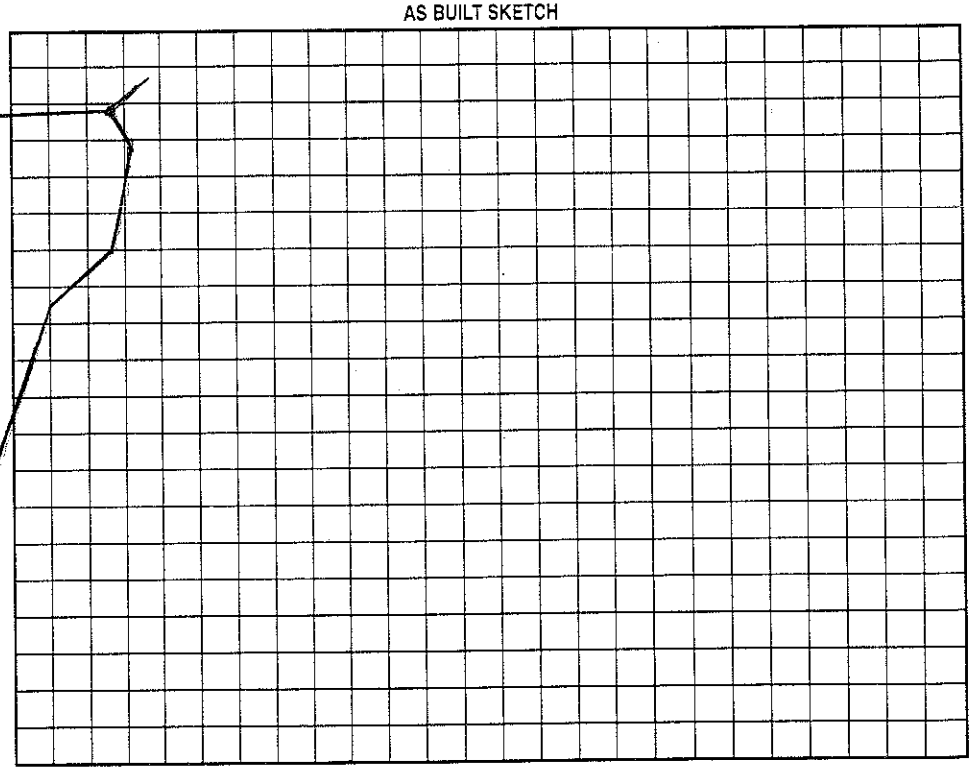

Permit can be suspended or revoked if any false information is supplied toward securing the permit/any unauthorized changes are made to the site/any unauthorized changes are made in the installation of the system. Improvement Permit with ~~plat~~valid without expiration. Improvement Permit with site plan valid for sixty months. Authorization to Construct is valid for a period equal to that of Improvement Permit – not to exceed sixty months.

Signed: date 3-21-01 Installed by: DeHart Brothers

Improvement Permit by: date 12-21-00 Operation Permit by: Wesley Sparks R.S. date 8/17/05

Authorization to Construct by: date 1/18/05 Existing System Inspection by: date

HEALTH DEPT. COPY: WHITE OWNER COPY (FINAL): YELLOW OWNER COPY (INITIAL): PINK