IREDELL COUNTY HEALTH DEPARTMENT

STATESVILLE 704-878-5305 MOORESVILLE 704-664-5281

IMPROVEMENT PERMIT / AUTHORIZATION TO CONSTRUCT / OPERATION PERMIT / EXISTING SYSTEM INSPECTION

PERMIT# 24783 PIN# ~~4755A~~ 9346942844 3.000 DATE 3/20/2000

OWNER OR CONTRACTOR Ray Morris/Crescent Resources PHONE: Business 662-2789 Ray Home 528-6005 598-5800 Johnny

ADDRESS P.O. Box 10103 Charlotte NC 28201

LOCATION Perth Rd. TL Fen Hill TL Kenway Loop on left

SUBDIVISION C L & T BLOCK / SECTION 15 LOT ~~23~~ 1036 LOT AREA 1 Acre SITE CLASS. PS DESIGN FLOW 360 L.T.A.R. .3

Septic Tank: 1000 Gallons; STB 1160 Date 9-28-00
Pump Tank: 1000' Gallons; PT 319 Date 10-31-00
Pump Make: Hydromatic Model SJHEF40A1 Serial No. 52608616-T
Nitrification Field: No Fields 1 Square Feet 600 Linear Feet 200'
No Lines 4 @ 50' Trench Width 24" Max Trench Bottom Depth 36" Gravel Depth N/A

☐ New System ☐ Repair System Type: I, II, III, IV, V, VI
System Description: Pump (pm) Panel
Repair System Description: Pump LPP Panel
Maintenance Agreement Required: ☐ Yes ☐ No


☒ House/Mod. Home No. Bedrooms 3
☐ Mobile Home No. Bathrooms 3
☐ Business No. Employees
☐ Other
☐ Slab ☐ Crawl Space ☒ Basement w/plumbing ☐ Basement wo/plumbing

Water Supply: ☒ Individual ☐ Public ☐ Community

Comments:/Conditions: Drainage for Culvert under road shall be diverted to left of property. Keep Septic System at least 10' From PL & 50'

Comments:/Conditions: Label filter installed & Checked tanks & lines 12/8/2000 MD

INITIAL SITE SKETCH

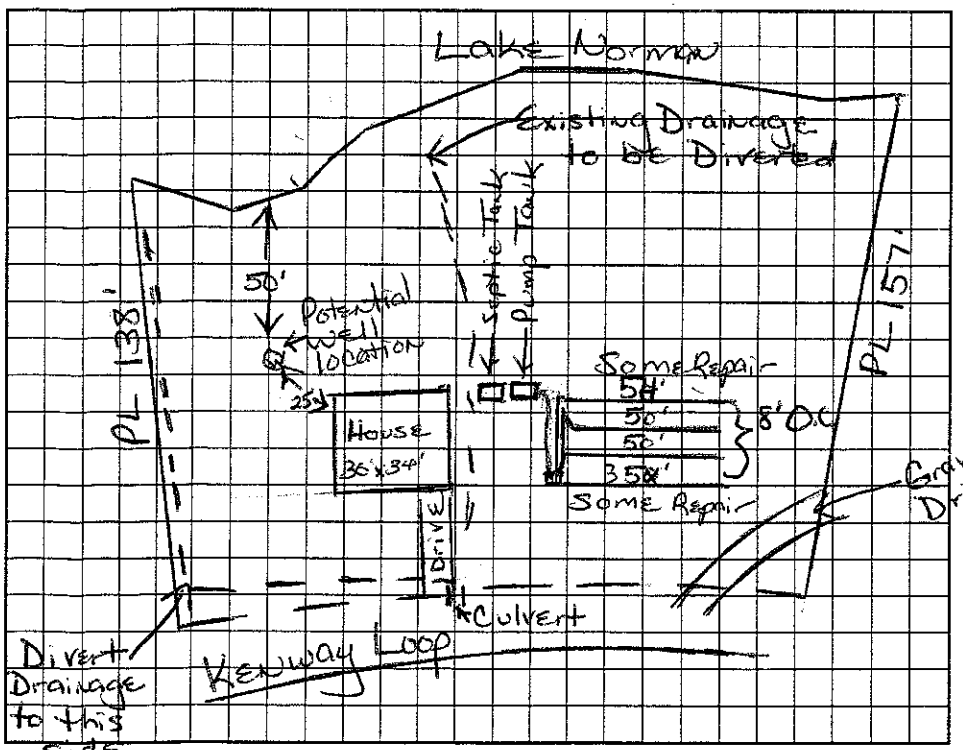

AS BUILT SKETCH

Installed as Drawn

Permit can be suspended or revoked if any false information is supplied toward securing the permit/any unauthorized changes are made to the site/any unauthorized changes are made in the installation of the system. Improvement Permit with plat valid without expiration. Improvement Permit with site plan valid for sixty months. Authorization to Construct is valid for a period equal to that of Improvement Permit – not to exceed sixty months. 828

Signed: Laura Dietrich date 3/28/00 Installed by: Workman's Construction 759-1224

Improvement Permit by: Maria H. Dotson R.S. date 3/20/2000 Operation Permit by: Maria H. Dotson R.S. date 12/14/2000

Authorization to Construct by: Maria H. Dotson R.S. date 3/20/2000 Existing System Inspection by: _____ date _____

HEALTH DEPT. COPY: WHITE OWNER COPY (FINAL): YELLOW OWNER COPY (INITIAL): PINK