IREDELL COUNTY HEALTH DEPARTMENT
ENVIRONMENTAL HEALTH DIVISION
Application For Improvement Permit

ALL items on this application form must be completed before Health Department can begin work. One application must be completed by the property owner or agent for each (proposed) site.

PERSONAL INFORMATION:

Applicant	Phone #	Mailing Address	City	State	Zip Code
CRESCENT ~~RESC.~~ INC	663-6905	P.O. Box 1003	Charlotte	NC	28201

Current Property Owner	Mailing Address	City	State	Zip Code
SAME				

PROPERTY INFORMATION:

(Proposed) Subdivision Name	(Proposed) Lot #	(Proposed) Block/Section #	State Road #
	1036	Sect. 15	1398 Runway

(Proposed) Water Supply: Public / (Private Well)

Preliminary Plat Approval Date (DEVELOPERS ONLY)

Tax Map # 25-5-A-93

Specific Directions to Property - Path Rd
- TL Fern Hill
- TL Runway
- Lot on left

TYPE OF FACILITY: (use check (X) or number as appropriate)

House X Mobile Home ____ Commercial ____ No. Bedrooms 3 No. Baths 3

No. Persons or Employees (commercial only) ____ Basement X Basement with Plumbing ~~No~~ Yes

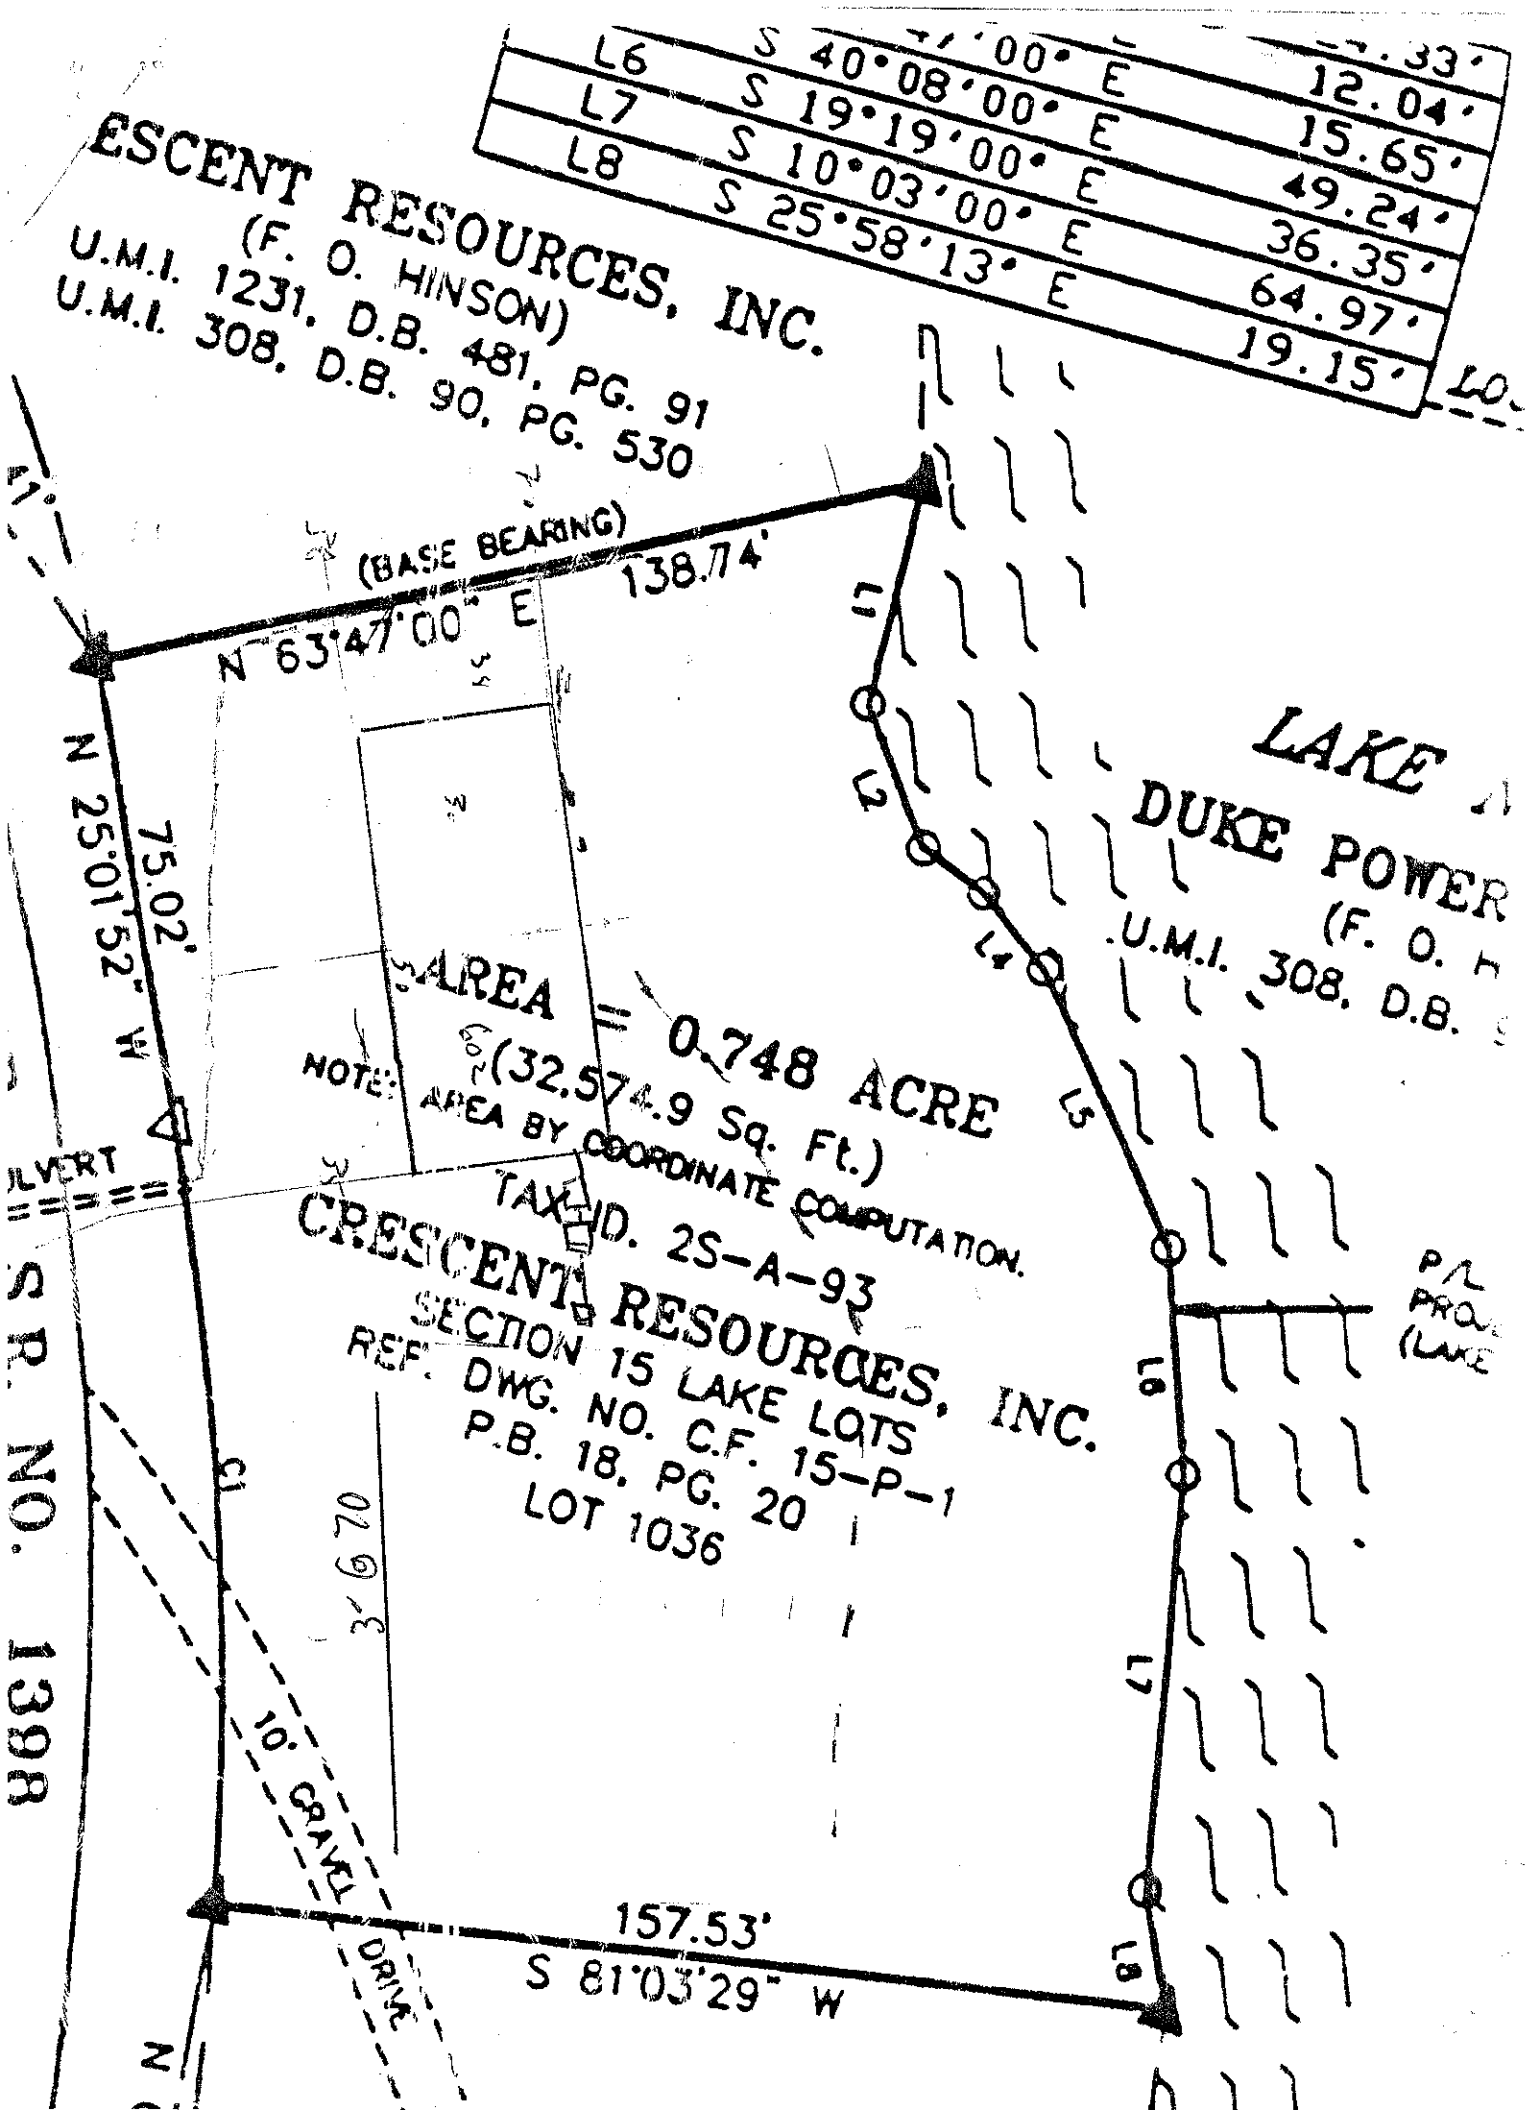
Crawl Space ____ Concrete Slab ____ Garbage Disposal ____ Jaccuzi or spa ____

COVENANT AND SIGNATURE:

I hereby make application to the Iredell County Health Department for a soils/site evaluation of the property described above. This evaluation is to be conducted for the sole purpose of obtaining a septic system Improvement Permit. I hereby authorize Iredell County Health Department representatives to go onto the above property for purposes of conducting this evaluation. I understand that, by state law, any Improvement Permit issued on the above property may be voided if substantial changes are made to the designated sewage system site. The issuance of an Improvement Permit by the Iredell County Health Department does not relieve me from compliance with all other relevant state/local laws or regulations. As owner or authorized agent, I covenant that the contents of this application are true and represent the maximum facilities intended to be placed on this property to my knowledge to date.

I understand that any Improvement Permit issued on the above property is valid for five (5) years from the issuance date and is subject to revocation if the above described site plans or intended use changes.

8-13-96 DATE Paul G. Pennington SIGNATURE OF OWNER/AUTHORIZED AGENT


ESCENT RESOURCES, INC.
(F. O. HINSON)
U.M.I. 1231, D.B. 481, PG. 91
U.M.I. 308, D.B. 90, PG. 530
(BASE BEARING)
N 63°47'00" E
138.74'
N 25°01'52" W
75.02'
AREA = 0.748 ACRE
(32,574.9 Sq. Ft.)
NOTE: AREA BY COORDINATE COMPUTATION.
TAX I.D. 2S-A-93
CRESCENT RESOURCES, INC.
SECTION 15 LAKE LOTS
REF. DWG. NO. C.F. 15-P-1
P.B. 18, PG. 20
LOT 1036
LAKE
DUKE POWER
(F. O. H
U.M.I. 308, D.B.
P/L PROJ
(LAKE
10' GRAVEL DRIVE
157.53'
S 81°03'29" W
SR NO. 1398
L7
L8