7/25 4:00

IREDELL COUNTY HEALTH DEPARTMENT

STATESVILLE 704-878-5305 MOORESVILLE 704-664-5281

IMPROVEMENT PERMIT / AUTHORIZATION TO CONSTRUCT / OPERATION PERMIT / EXISTING SYSTEM INSPECTION

PERMIT# 092412 PIN# 4639 73 4457 (ot.) 4639-42-8895 DATE 2/16/01

OWNER OR CONTRACTOR Crescent Resources LLC. / Spear Builders PHONE: Business 704 202-4964 Home

ADDRESS P.O. Box 1003, Charlotte N.C. 28201

LOCATION North Rd N. TL Fern Hill TL Wildwood Cove on Right

SUBDIVISION Wildwood Cove BLOCK / SECTION LOT 27 LOT AREA 49,920 ft2 SITE CLASS. PS DESIGN FLOW 480 gpd L.T.A.R. .03

Septic Tank: 1000 Gallons; STB 325 Date 8/27/03
Pump Tank: 1000 Gallons; PT 302 Date 1/5/03
Pump Make: Zoeller Model N137 Serial No.
Nitrification Field; No Fields 1 Square Feet 1200 Linear Feet 400
No Lines 4 Trench Width 36" Max Trench Bottom Depth 36" Gravel Depth NA

☑ New System ☐ Repair System Type: I, II, (III), IV, V, VI
System Description: PM - Innovative - 25% Red.
Repair System Description: SAME
Maintenance Agreement Required: ☐ Yes ☑ No

☑ House/Mod. Home No. Bedrooms 4
☐ Mobile Home No. Bathrooms 4
☐ Business No. Employees
☐ Other

☑ Slab ☑ Crawl Space ☑ Basement w/plumbing ☐ Basement wo/plumbing


Water Supply: ☐ Individual ☑ Public ☐ Community

Comments:/Conditions:

Comments:/Conditions: (PARTIAL)

1" = 50'

INITIAL SITE SKETCH

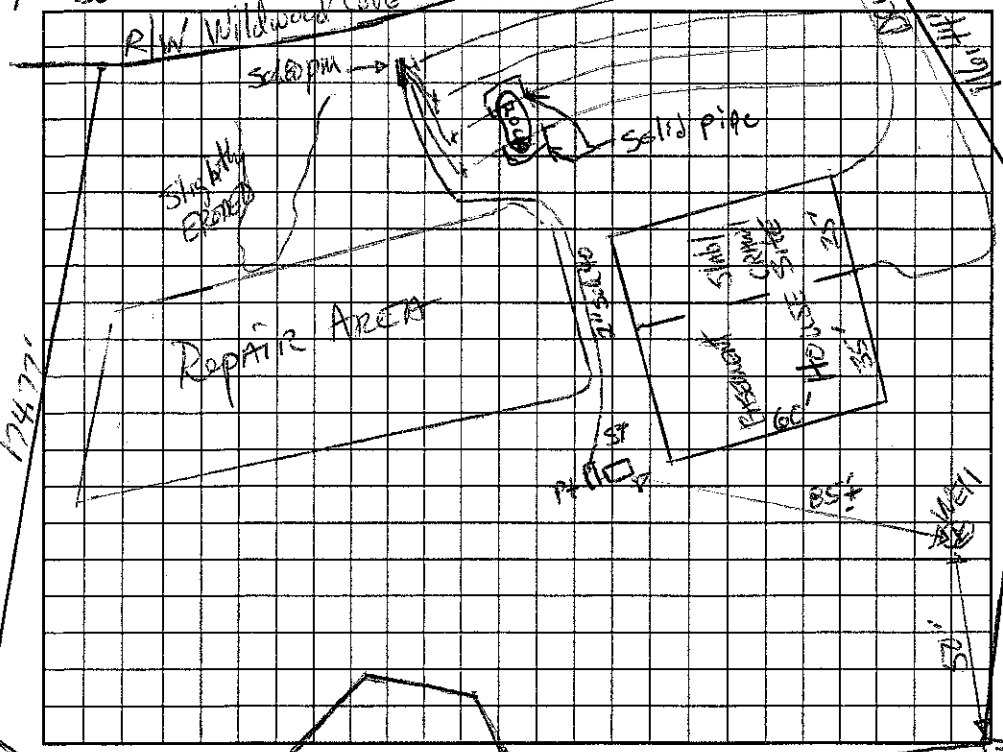

AS BUILT SKETCH

Permit can be suspended or revoked if any false information is supplied toward securing the permit/any unauthorized changes are made to the site/any unauthorized changes are made in the installation of the system. Improvement Permit with plat valid without expiration. Improvement Permit with site plan valid for sixty months. Authorization to Construct is valid for a period equal to that of Improvement Permit – not to exceed sixty months.

Signed: Roger T. date 3-21-01 Installed by: Rowan Septic

Improvement Permit by: date 2-16-01 Operation Permit by: RS date 9/17/03

Authorization to Construct by: RS date 4/29/03 Existing System Inspection by: date

HEALTH DEPT. COPY: WHITE OWNER COPY (FINAL): YELLOW OWNER COPY (INITIAL): PINK