IREDELL COUNTY HEALTH DEPARTMENT

STATESVILLE 704-878-5305 MOORESVILLE 704-664-5281

IMPROVEMENT PERMIT / AUTHORIZATION TO CONSTRUCT / OPERATION PERMIT / EXISTING SYSTEM INSPECTION

PERMIT# 092424 PIN# 4639-73-4457 4639430514 DATE 12/23/02

OWNER OR CONTRACTOR Rion Homes PHONE: Business 704-634-1466 Home

ADDRESS

LOCATION Perth, TL Fern Hill, TL Kenway Lp on Lt - 121 KENWAY LOOP

SUBDIVISION Wildwood Cove BLOCK / SECTION LOT 37 LOT AREA 30,820 Ft² SITE CLASS. 05 DESIGN FLOW 450 L.T.A.R. 0.3

Septic Tank: 1000 Gallons; STB 794 Date 1/13/03

Pump Tank: Gallons; PT Date

Pump Make: Model Serial No.

Nitrification Field: No. Fields 1 Square Feet 1200 Linear Feet 400

No Lines 3 ~~2~~ ~~155'~~ Trench Width 36" Max Trench Bottom Depth 36" Gravel Depth —

☒ New System ☐ Repair System Type: I, II, III, IV, V, VI

System Description: Gravity 25% Reduction

Repair System Description: Same

Maintenance Agreement Required: ☐ Yes ☒ No

☒ House/Mod. Home ☐ Mobile Home ☐ Business ☐ Other

No. Bedrooms 4 No. Bathrooms 2 No. Employees


Water Supply: ☒ Individual ☐ Public ☐ Community

☐ Slab ☒ Crawl Space ☐ Basement w/plumbing ☐ Basement wo/plumbing


Comments:/Conditions:

Comments:/Conditions:

INITIAL SITE SKETCH

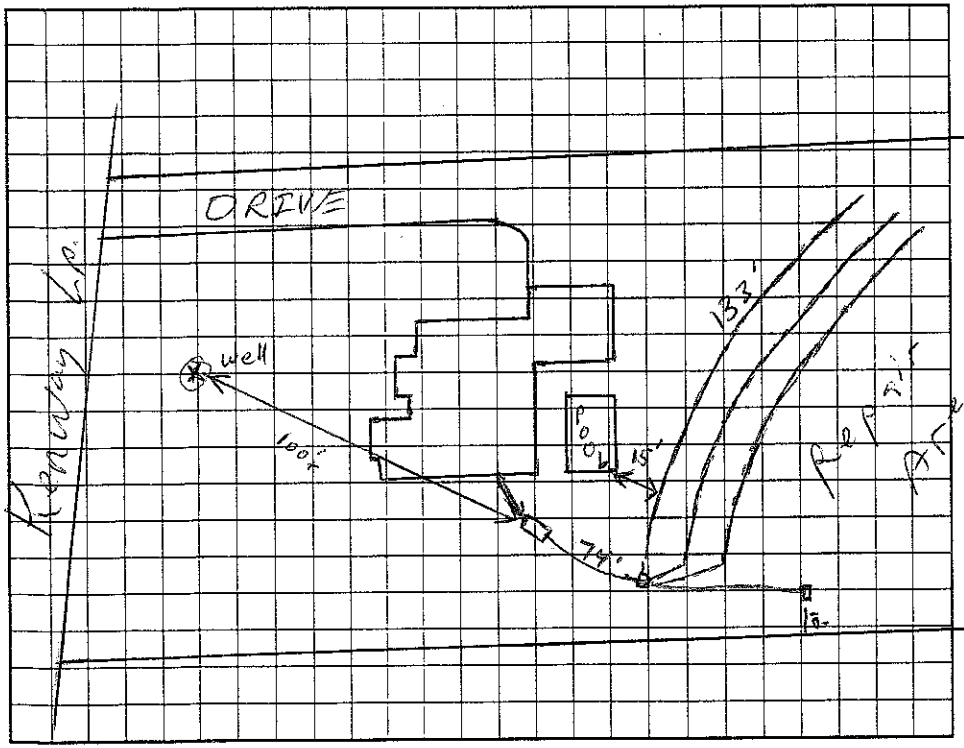

AS BUILT SKETCH

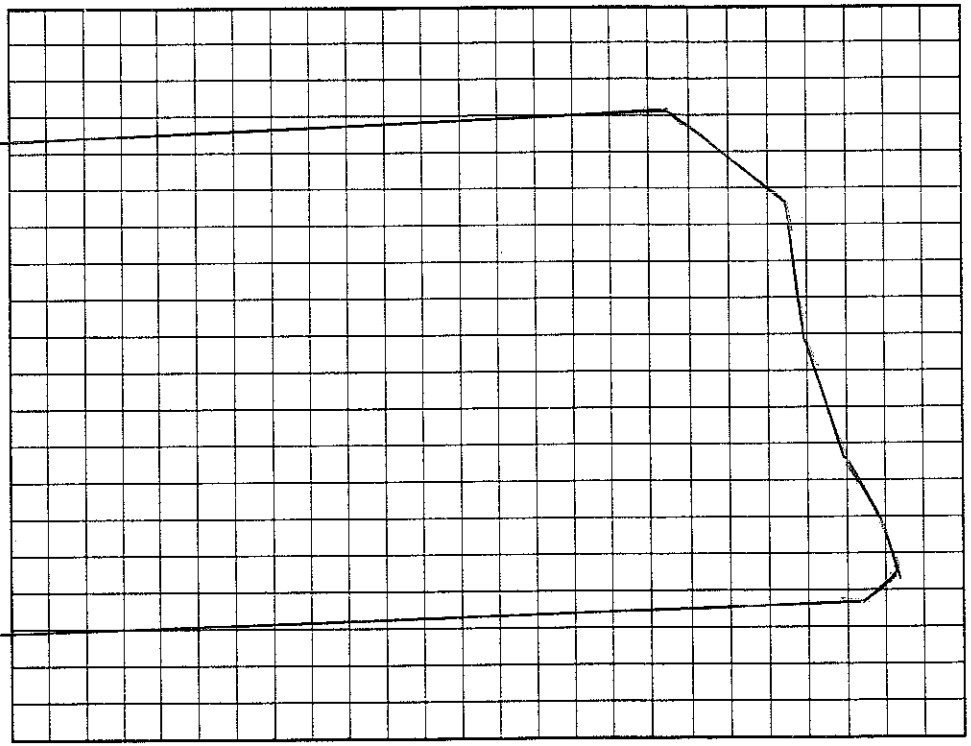

Permit can be suspended or revoked if any false information is supplied toward securing the permit/any unauthorized changes are made to the site/any unauthorized changes are made in the installation of the system. Improvement Permit with plat valid without expiration. Improvement Permit with site plan valid for sixty months. Authorization to Construct is valid for a period equal to that of Improvement Permit – not to exceed sixty months.

Signed: Nicole R. Bobb, Rion Homes date 12/23/02 Installed by: Buddy Chaney

Improvement Permit by: RS date 12/23/02 Operation Permit by: Wesley Thomas date 5/1/03

Authorization to Construct by: RS date 12/23/02 Existing System Inspection by: date

HEALTH DEPT. COPY: WHITE OWNER COPY (FINAL): YELLOW OWNER COPY (INITIAL): PINK