IREDELL COUNTY HEALTH DEPARTMENT

STATESVILLE 704-878-5305 MOORESVILLE 704-664-5281

IMPROVEMENT PERMIT / AUTHORIZATION TO CONSTRUCT / OPERATION PERMIT / EXISTING SYSTEM INSPECTION

$125.00 Paid #0 1130

PERMIT# 092426 PIN# 4639 73 4475 (pt.) 4639 43 1434 DATE Jan 24, 01

OWNER OR CONTRACTOR Crescent Resources, LLC / Lake Norman Coast C PHONE: Business 643-1339 Home

ADDRESS P.O. Box 1003, Charlotte / 123 Old Timberton, Mooresville, NC 28117

LOCATION Perth Rd N. TL Tepee Hill TL Kenway Loop on left

SUBDIVISION Wildwood Cove BLOCK / SECTION LOT 38 LOT AREA 91,170 ft² SITE CLASS. PS DESIGN FLOW 480 gpd L.T.A.R. ~.3

Septic Tank: 1000 Gallons; STB 794 Date 9-31-01

Pump Tank: Gallons; PT Date

Pump Make: Model Serial No. 400

Nitrification Field: No Fields 1 Square Feet 1200 Linear Feet ~~540~~

No Lines 4@60' Trench Width 36" Max Trench Bottom Depth 36" Gravel Depth 12"

☑ New System ☐ Repair System Type: I, II, III, IV, V, VI, Cht PLASTIC EZ FLOW

System Description: GRAVITY ~~CONVENTIONAL~~

Repair System Description: SAME

Maintenance Agreement Required: ☐ Yes ☑ No

☑ House/Mod. Home No. Bedrooms 4

☐ Mobile Home No. Bathrooms 4

☐ Business No. Employees

☐ Other

☐ Slab ☑ Crawl Space ☐ Basement w/plumbing ☐ Basement wo/plumbing


Water Supply: ☑ Individual ☐ Public ☐ Community

Comments:/Conditions: Type 3 - Cht Plastic or EZ Flow


Comments:/Conditions: EZ Flow installed
Grey Filter installed

1"=60'

INITIAL SITE SKETCH

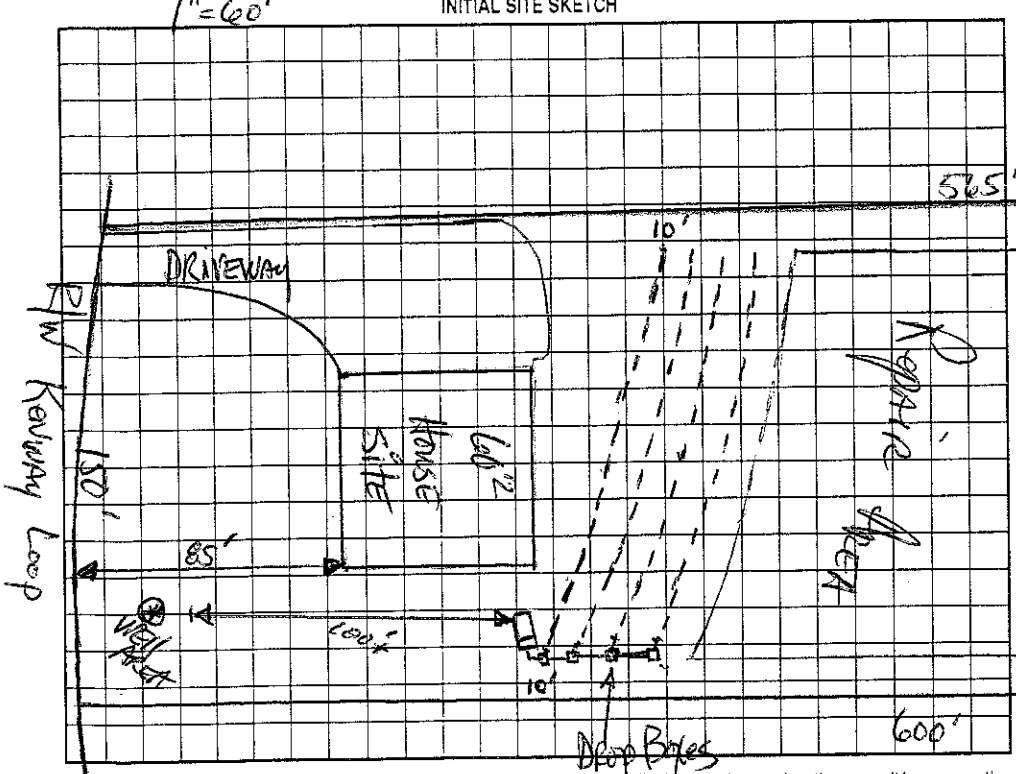

AS BUILT SKETCH

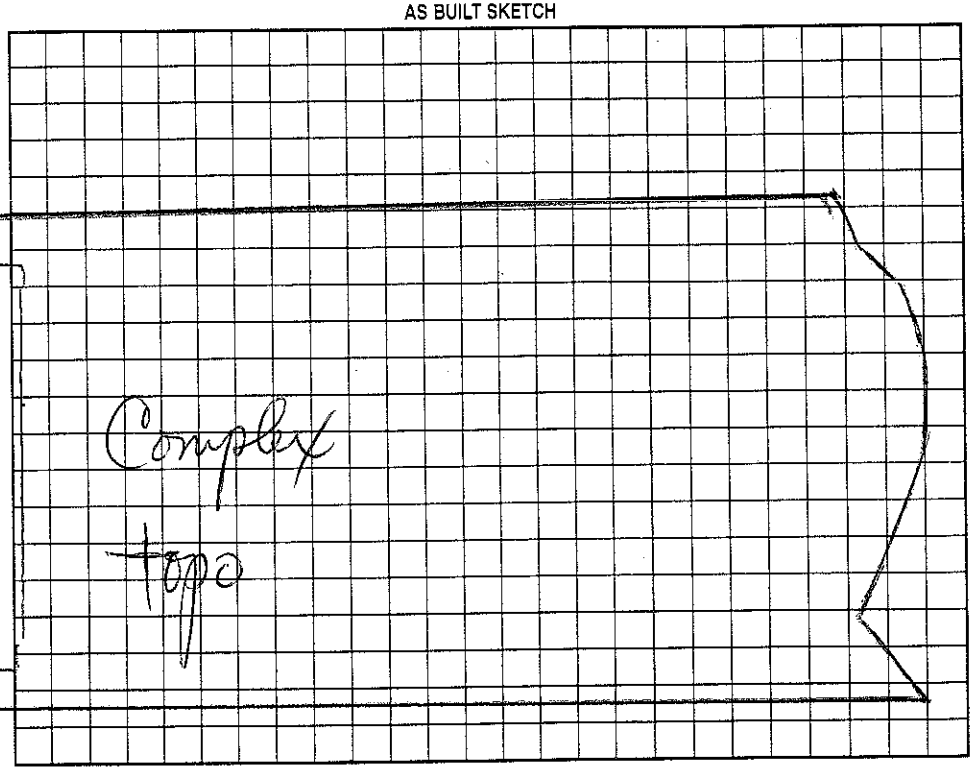

Permit can be suspended or revoked if any false information is supplied toward securing the permit/any unauthorized changes are made to the site/any unauthorized changes are made in the installation of the system. Improvement Permit with plat valid without expiration. Improvement Permit with site plan valid for sixty months. Authorization to Construct is valid for a period equal to that of Improvement Permit – not to exceed sixty months.

Signed: [signature] date 3-21-01 Installed by: David Clark.

Improvement Permit by: [signature] RS date 1-24-01 Operation Permit by: Wesley Sparks RS date 11/8/01

Authorization to Construct by: Wesley Sparks RS date 7/16/01 Existing System Inspection by: date

HEALTH DEPT. COPY: WHITE OWNER COPY (FINAL): YELLOW OWNER COPY (INITIAL): PINK