IREDELL COUNTY HEALTH DEPARTMENT

STATESVILLE 704-878-5305 MOORESVILLE 704-664-5281

IMPROVEMENT PERMIT / AUTHORIZATION TO CONSTRUCT / OPERATION PERMIT / EXISTING SYSTEM INSPECTION

$105

PERMIT# 092418 PIN# ~~4639 73 4475 (pt)~~ 4639432343 DATE 10/16/02

OWNER OR CONTRACTOR Lake Norman Construction PHONE: Business 704-663-1339 Home

ADDRESS 1230 Old Timber Ln. Mooresville, NC. 28117

LOCATION Perth N, TL Fern Hill Rd. TL Kenway Loop. (1st) to 2nd lot on (L)

SUBDIVISION Wildwood Cove BLOCK / SECTION LOT 39 LOT AREA 88,880 SITE CLASS. PS DESIGN FLOW 480 L.T.A.R. .3

Septic Tank: 1000 Gallons; STB Date

Pump Tank: Gallons; PT Date

Pump Make: Model Serial No.

Nitrification Field: No Fields 1 Square Feet 1200 Linear Feet 400 ±

No Lines 4 @ 100' Trench Width 3' Max Trench Bottom Depth 3' Gravel Depth NA

☑ New System ☐ Repair System Type: I, II, (III) IV, V, VI

System Description: GRAVITY - Type 3

Repair System Description: Same

Maintenance Agreement Required: ☐ Yes ☒ No

☒ House/Mod. Home No. Bedrooms 4

☐ Mobile Home No. Bathrooms 4

☐ Business No. Employees

☐ Other

☐ Slab ☒ Crawl Space ☐ Basement w/plumbing ☐ Basement wo/plumbing


Water Supply: ☒ Individual ☐ Public ☐ Community

Comments:/Conditions:


Comments:/Conditions:

(1" = 60')

INITIAL SITE SKETCH

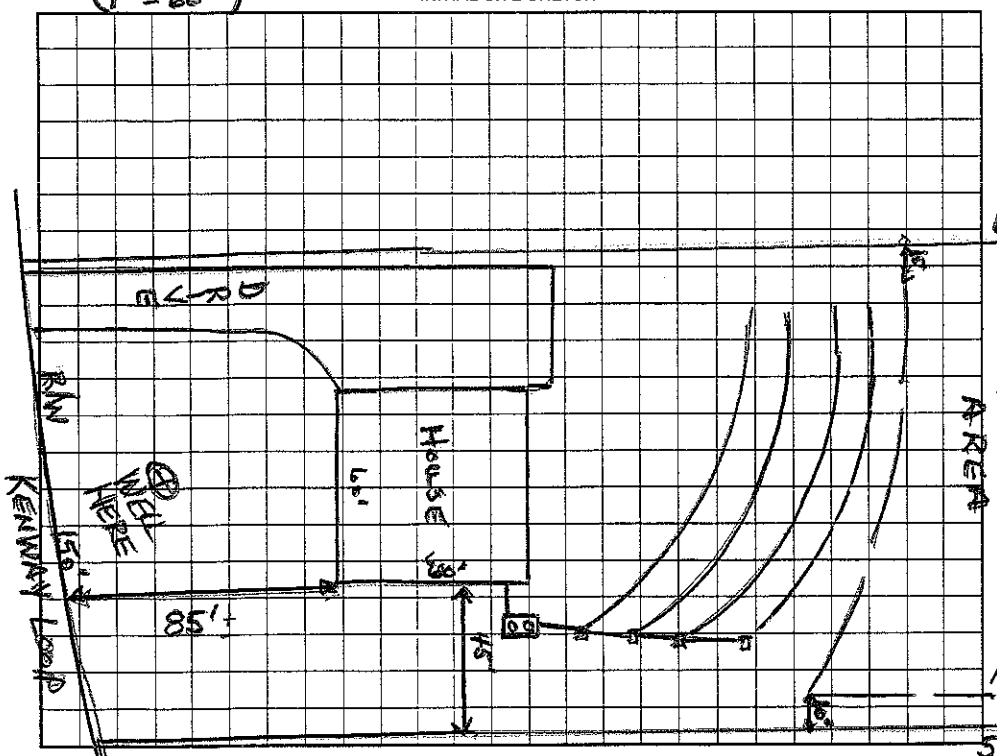

AS BUILT SKETCH

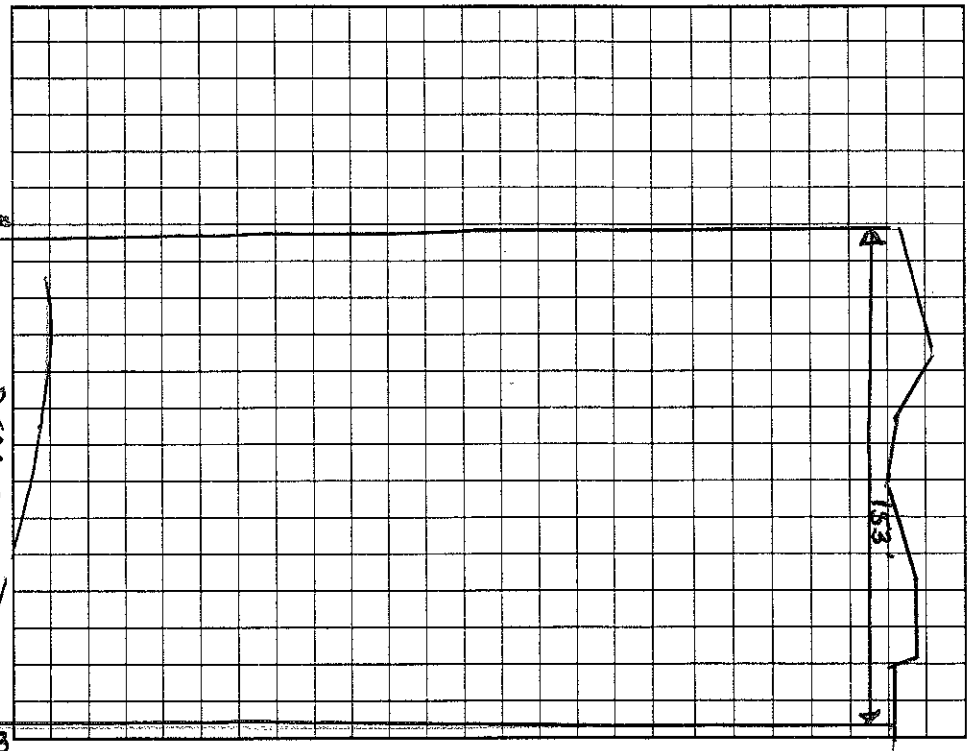

Permit can be suspended or revoked if any false information is supplied toward securing the permit/any unauthorized changes are made to the site/any unauthorized changes are made in the installation of the system. Improvement Permit with plat valid without expiration. Improvement Permit with site plan valid for sixty months. Authorization to Construct is valid for a period equal to that of Improvement Permit – not to exceed sixty months.

Signed: Theresa A. Beaty date 11-7-02 Installed by: DC Construction

Improvement Permit by: DRH date 1/23/01 Operation Permit by: Wesley Sparks RS. date 10/16/02

Authorization to Construct by: AWS date 5/28/02 Existing System Inspection by: date

HEALTH DEPT. COPY: WHITE OWNER COPY (FINAL): YELLOW OWNER COPY (INITIAL): PINK