IREDELL COUNTY HEALTH DEPARTMENT

STATESVILLE 704-878-5305 50.00 Paid - 338 MOORESVILLE 704-664-5281

IMPROVEMENT PERMIT / AUTHORIZATION TO CONSTRUCT / OPERATION PERMIT / EXISTING SYSTEM INSPECT

PERMIT# 092379 PIN# 4639 73 4457 4639 44 0301 DATE May 31, 02

OWNER OR CONTRACTOR Graham Central PHONE: Business (704) 664-5342 Home

ADDRESS 230 Hideaway Ln. Mooresville 28117

LOCATION Perth Road North TL Fern Hill TL Wildwood Cove 1st lot on left

SUBDIVISION Wildwood Cove BLOCK / SECTION LOT 1 LOT AREA 44,384 sf SITE CLASS PS* DESIGN FLOW 360gpd L.T.A.R. n, 2

Septic Tank: 1000 Gallons; STB 825 Date 6/4/02

Pump Tank: 1000 Gallons; PT 302 Date 6/4/02

Pump Make: Zoeller Model N140-0 Serial No.

Nitrification Field: No Fields 1 Square Feet 1350 Linear Feet 450

No Lines 7 Trench Width 36" Trench Bottom Depth 36" Gravel Depth NA

☒ New System ☐ Repair System Type: I, II, III, IV, V, VI

System Description: pm - Innovative - 25% Red, onsite

Repair System Description: * Innovative on SFE 1A

Maintenance Agreement Required: ☐ Yes ☒ No

☐ House/Mod. Home No. Bedrooms 3

☐ Mobile Home No. Bathrooms 2.5

☐ Business No. Employees

☐ Other


☐ Slab ☒ Crawl Space ☐ Basement w/plumbing ☐ Basement wo/plumbing

Water Supply: ☒ Individual ☐ Public ☐ Community


Comments:/Conditions: Install drainfield at 36" trench bottom depth.

Comments:/Conditions:

INITIAL SITE SKETCH 1"=50'

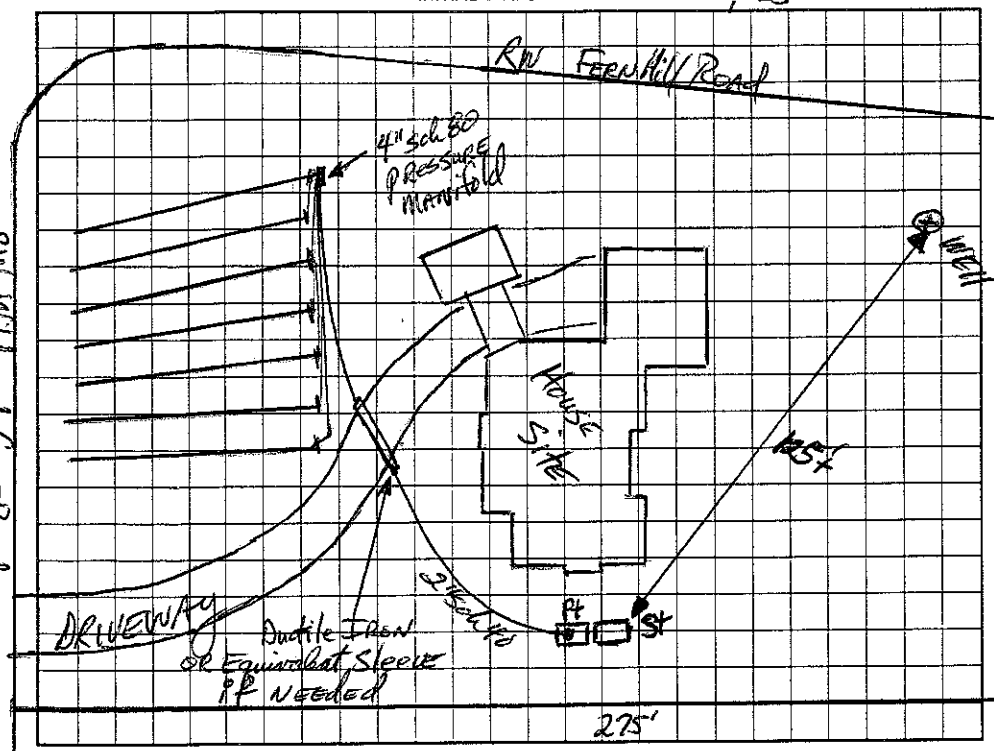

AS BUILT SKETCH

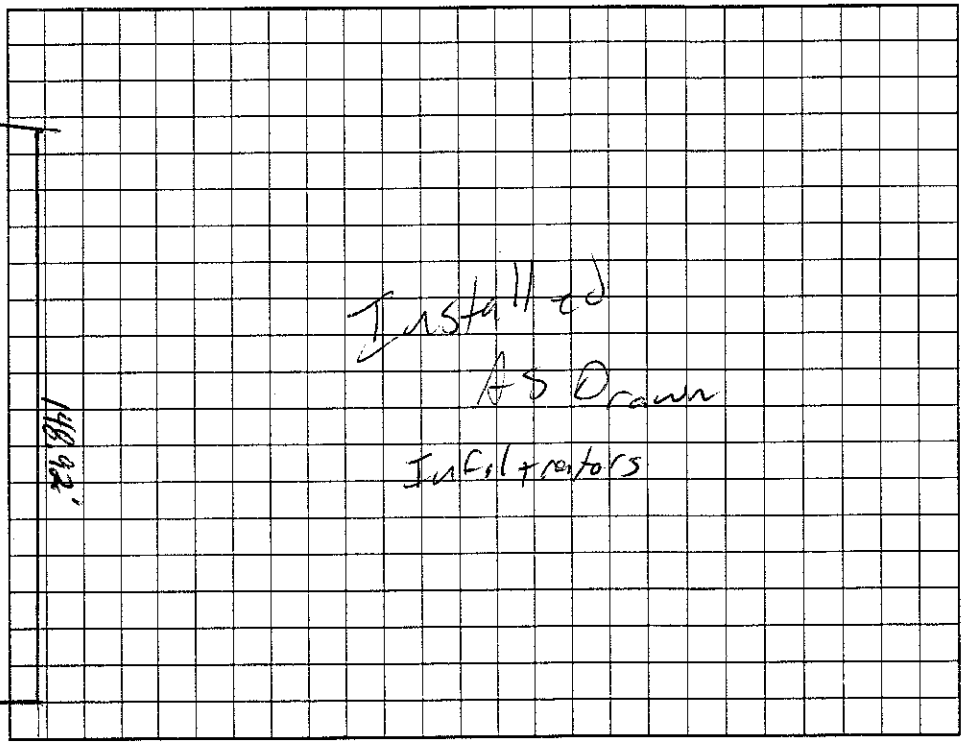

Permit can be suspended or revoked if any false information is supplied toward securing the permit/any unauthorized changes are made to the site/any unauthorized changes are made in the installation of the system. Improvement Permit with plat valid without expiration. Improvement Permit with site plan valid for sixty months. Authorization to Construct is valid for a period equal to that of Improvement Permit – not to exceed sixty months.

Signed: date 6/5/02 Installed by: Rowan Septic

Improvement Permit by: date 5-31-02 Operation Permit by: date 8/19/02

Authorization to Construct by: date 5-31-02 Existing System Inspection by: date

HEALTH DEPT. COPY: WHITE OWNER COPY (FINAL): YELLOW OWNER COPY (INITIAL): PINK